


2 P.A. 15

475


477	TOTAL
-----	-------

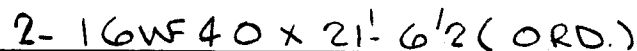

4 Paint

723

727	TOTAL
-----	-------

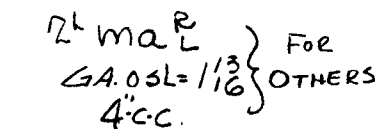

7^{LS} A454X^R For 136

$$\begin{array}{r} H131^{(1)} - 56 \\ \hline \frac{2}{H136}^{(1)} \quad \frac{2}{H141}^{(1)} - 56 \\ \hline H152^{(1)} - 56 \end{array}$$

2. 16WF45 x 21'-7³/₈ (ORD. 21'-6¹/₂)

4. do x 21'-7 1/4" (ORD. 21'-6 1/2")

ONE - 16WF36 x 21¹/₄ (ORD. 21¹/₂)

↳ SHOP NOTE : DIFF WT. BMS.

2^{LS} A454x_L^R

34	Paint
----	-------

12	18	A454x ^R
----	----	--------------------

4. FOR 136
2 EA. FOR OTHERS

69	10	ma ^L	$L^3 \times 3 \times 3^3$	0	$11\frac{1}{2}$
----	----	-----------------	---------------------------	---	-----------------

2 EA. For 131,
141, 152

1939	
------	--

3877

075

6818	TOTAL
------	-------

TOTAL	ORD.	PLATES	STD.	BOLT	RIV.	BAR	SM. STD.	PAINT	WELD.
8022	7789		193						40
DET.	DATE	CHK'R.	DATE	IN CHARGE					
LWS	11-1-54	E.R.H.	12-4-54	FISHER					
REVISIONS	Rev. 12/22/54					CONTRACT NO.	SHEET NO.		
						4090	B413		

WELD Lot 6