



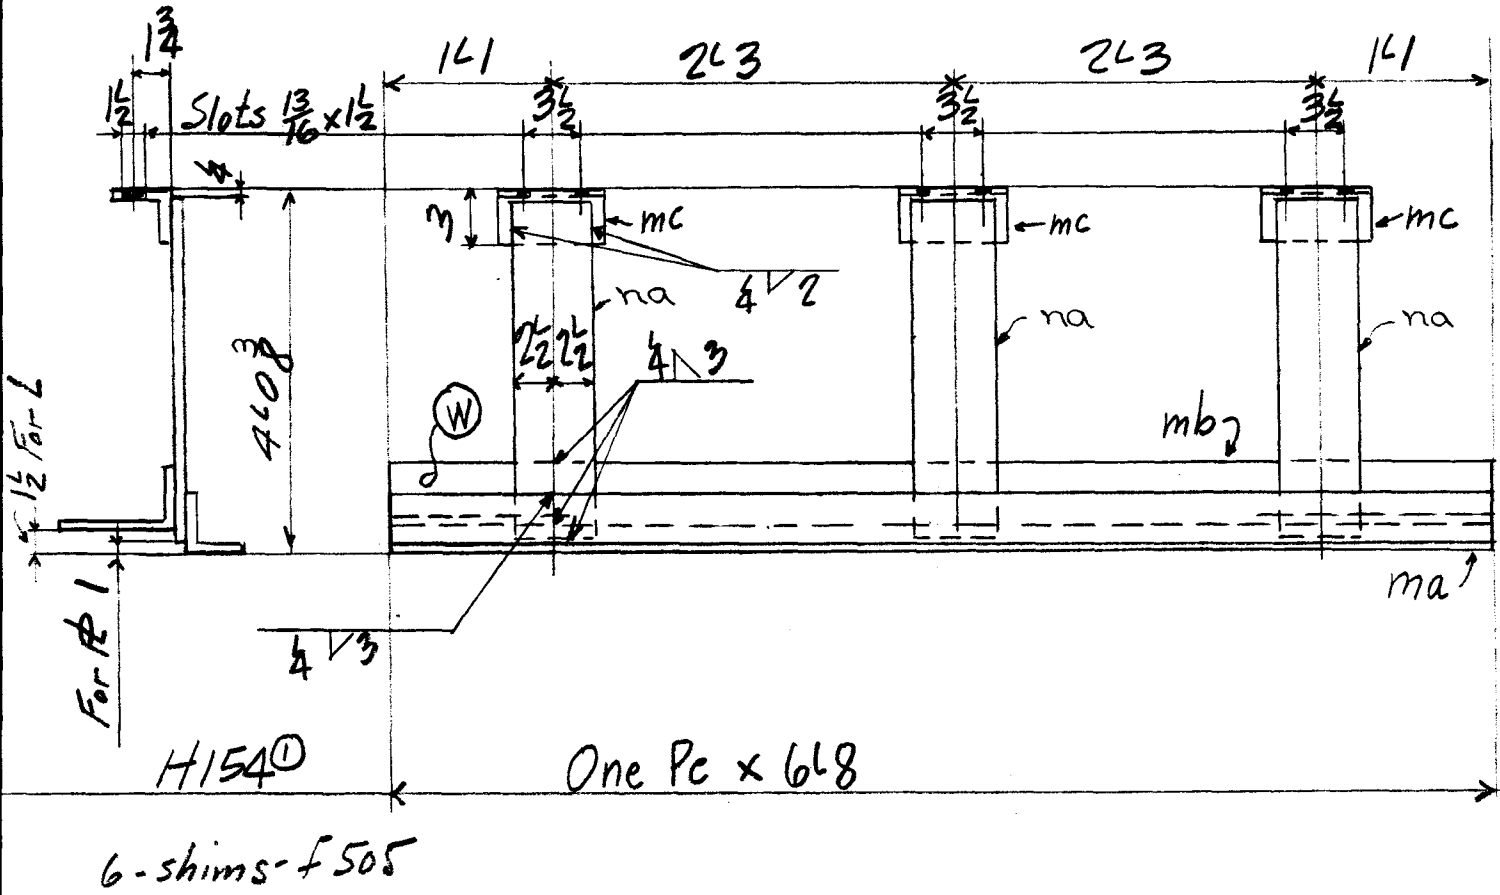

48	1	ma	L 3 1/2 x 3 1/2 x 5/16	6 8		stk
115	1	mb	L 8 x 4 x 7/16	6 8		
12	3	mc	L 3 1/2 x 3 x 3/8	0 6		
75	3	na	R 5 x 3/8	3 11 1/8		
1 PAINT						
251 TOTAL						

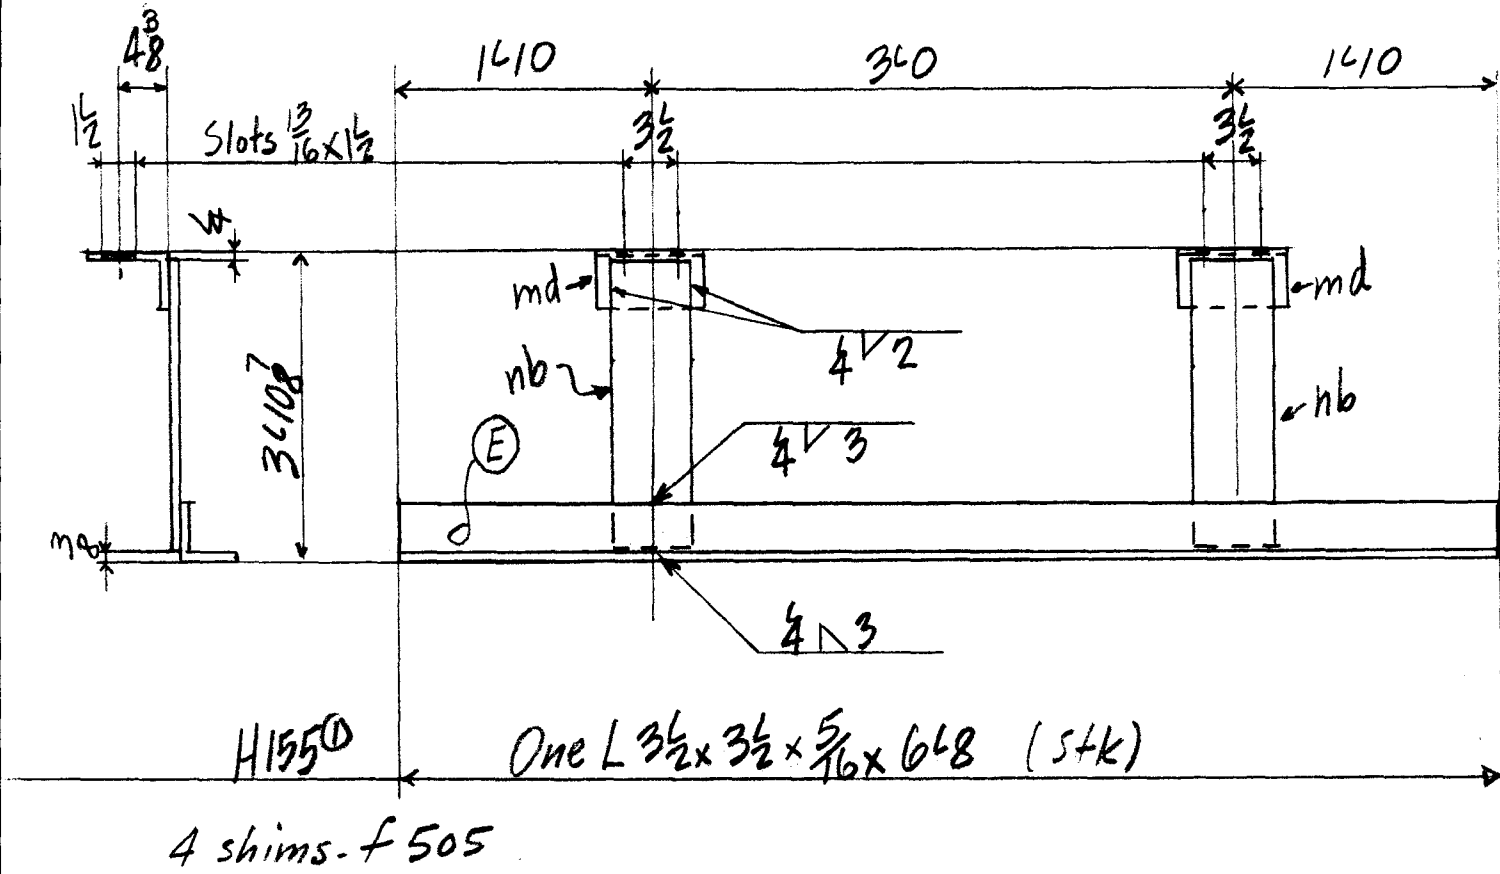

1 PAINT						
16	2	md	L 6 x 4 x 1/2	0 6		stk
49	2	nb	R 5 x 3/8	3 10 1/4		
48						
114 TOTAL						

TOTAL	ORD.	PLATES	STD.	BOLT	RIV.	BAR	SM. STD.	PAINT	WELD
365			239			12L			2

DET. CLF	DATE 12/21/54	CHK'R. R.C.C.	DATE 12-22-54	IN CHARGE CLF
----------	---------------	---------------	---------------	---------------

CONTRACT NO.	SHEET NO.	REVISIONS 1-10-55: Appl. Changes	CONTRACT NO. 4090	SHEET NO. B422
OPEN HOLES As	UNREMARKED			