



WEIGHT	NO. PCS.	ASS'M MK.	SHAPE	LENGTH	REMARKS	ORDERED
--------	----------	-----------	-------	--------	---------	---------

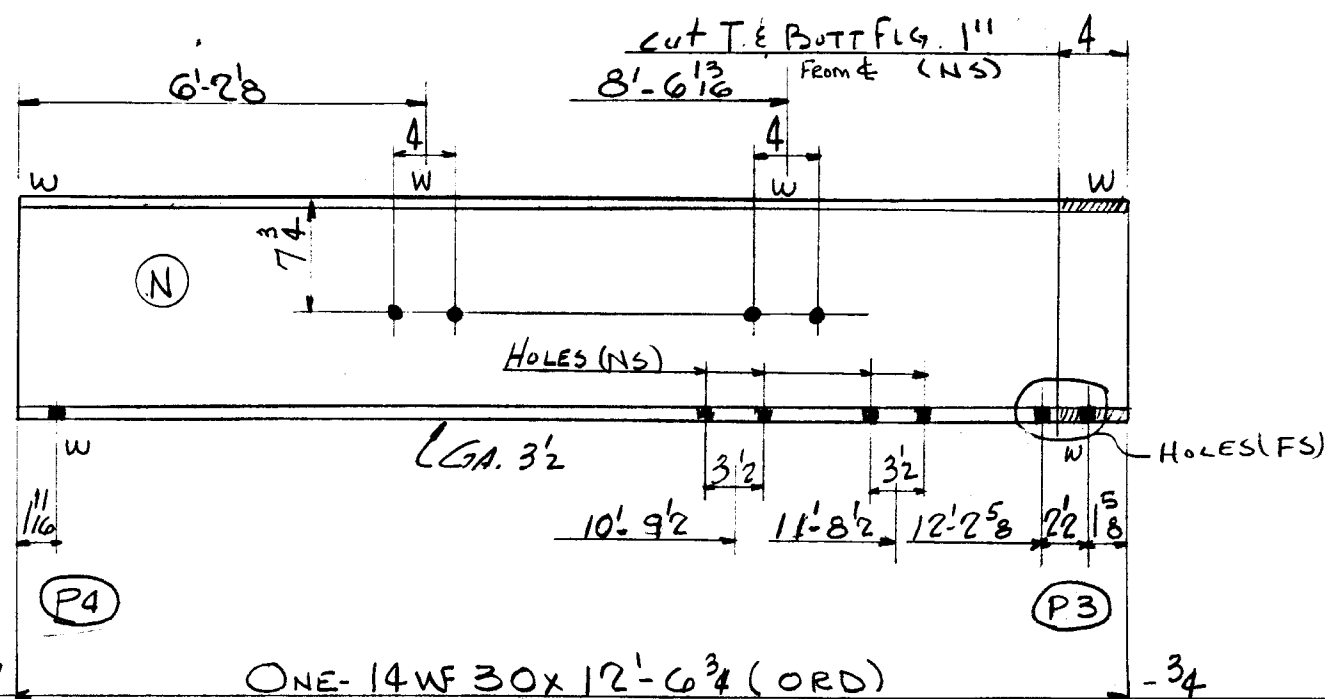


H42⁽²⁾
 4-34" x 16 Gr.
 8- do x 1 Gr.


4. SHIMS \$505

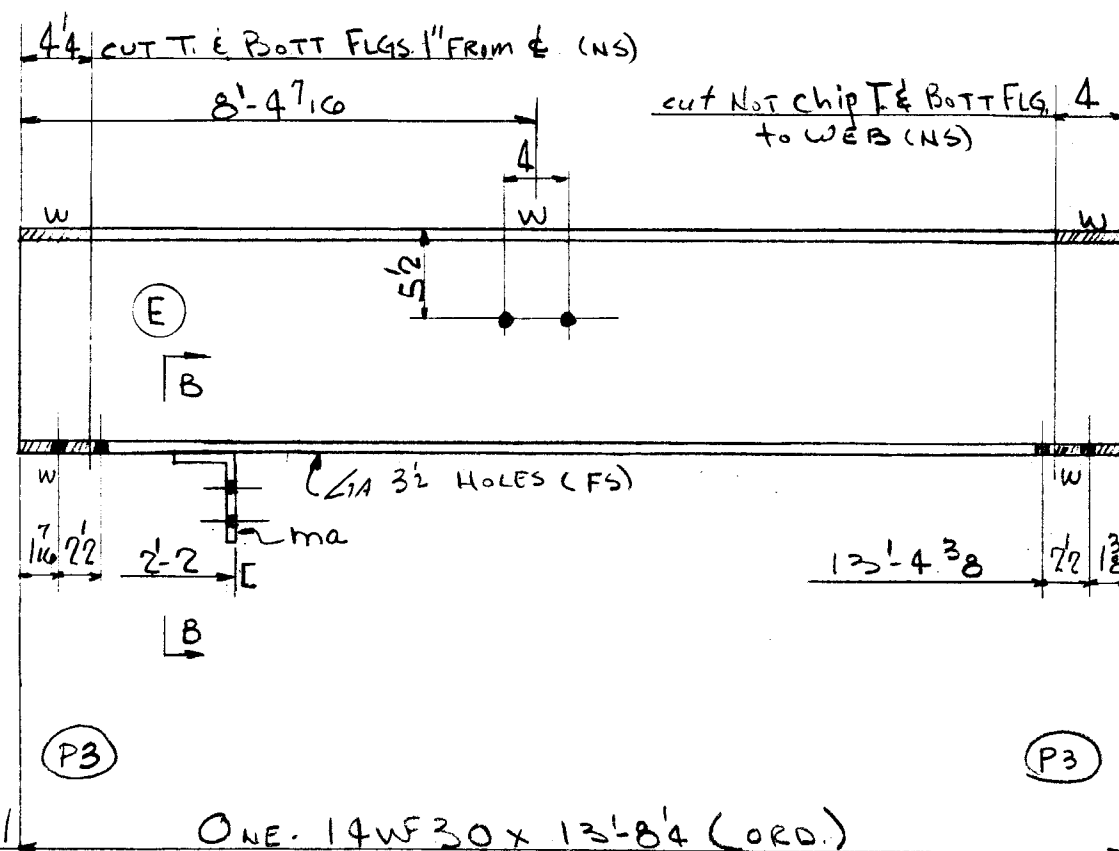


2. 34" x 16 Gr.
4. do x 18 Gr.

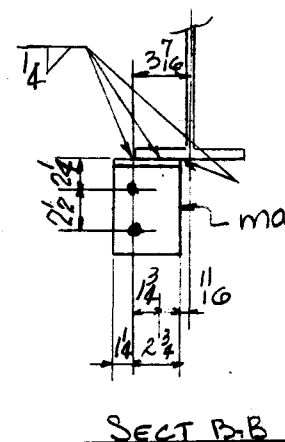

SECT B.B

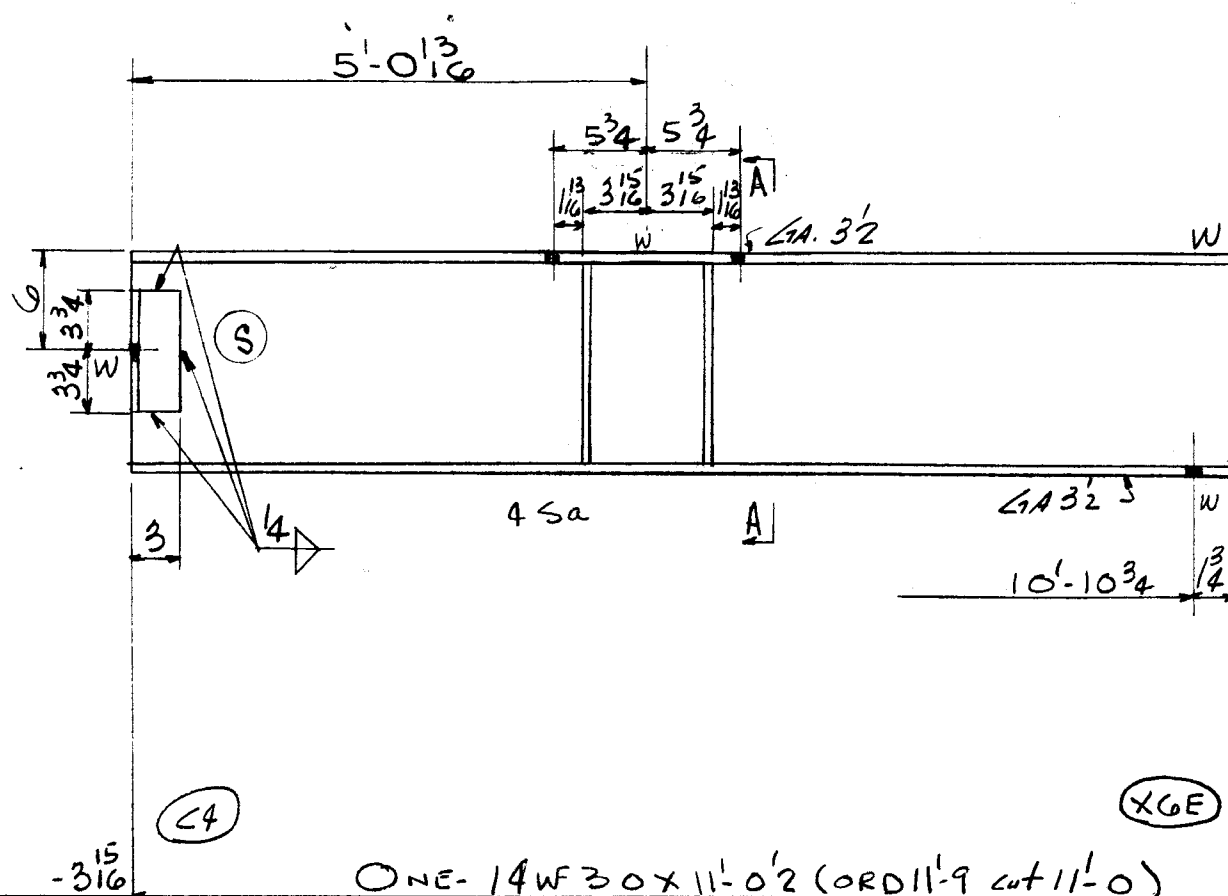

2¹³ mb
LA. σSL = 1⁵₈
3¹/₂ ctrs.

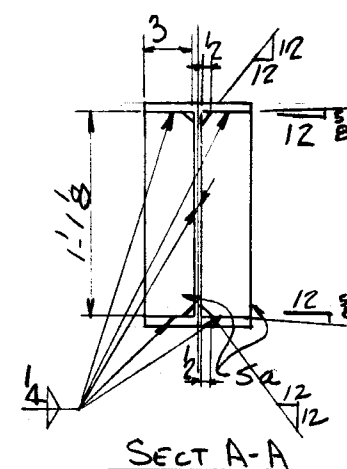

SECT A-A

H37 ⁽²⁾
4. 34" d P x 78 Gr
2. do x 34 Gr.

[illegible]

TOTAL	ORD.	PLATES	STD.	BOLT	RIV.	BAR	SM. STD.	PAINT	WELD
1153	1118		12			17		6	

DET.	DATE	CHK'R.	DATE	IN CHARGE
LWS	11-10-54	CZ	12-1-54	FISHER

REVISIONS 1-24-55: App'l. change (H37) 5'-0 ³ / ₈ " was 4'-9 ³ / ₈ " (H42) 6'-2 ³ / ₈ " was 6'-5 ³ / ₈ "	CONTRACT NO. 4090	SHEET NO. B459
--	----------------------	-------------------

WELD LOTS