




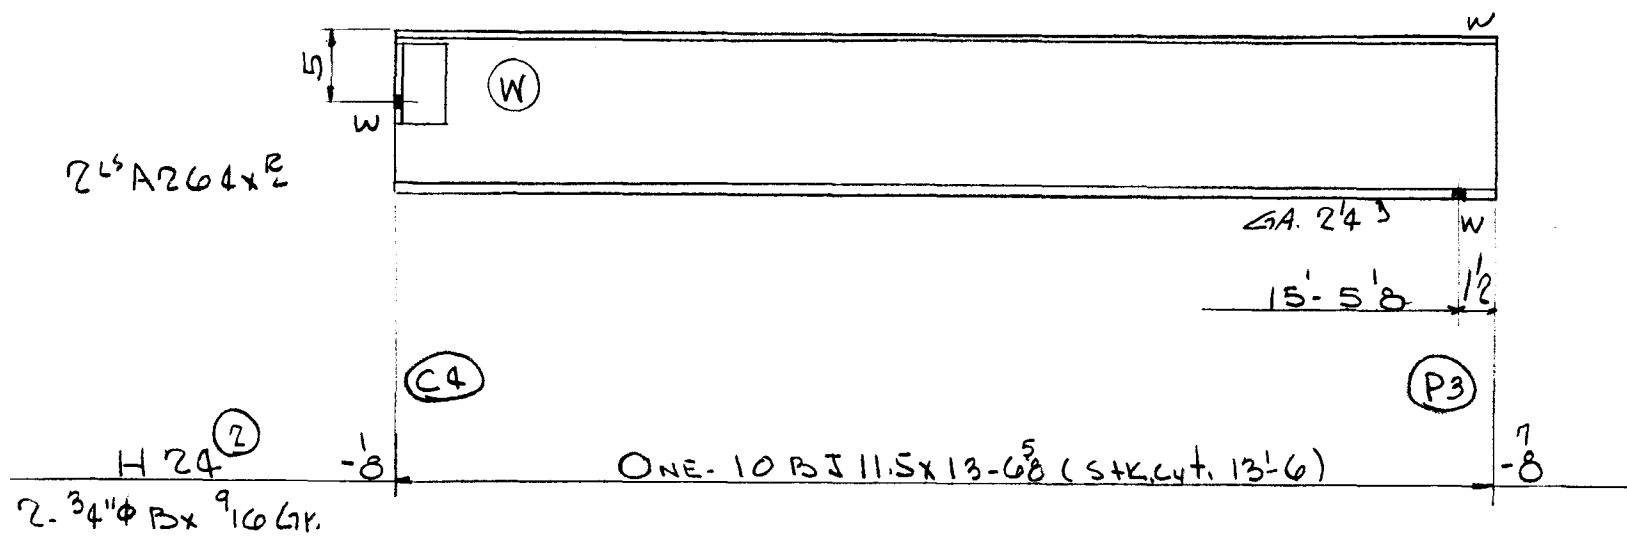

1	PAINT					
6	2 A264XL					
155						
162	TOTAL					

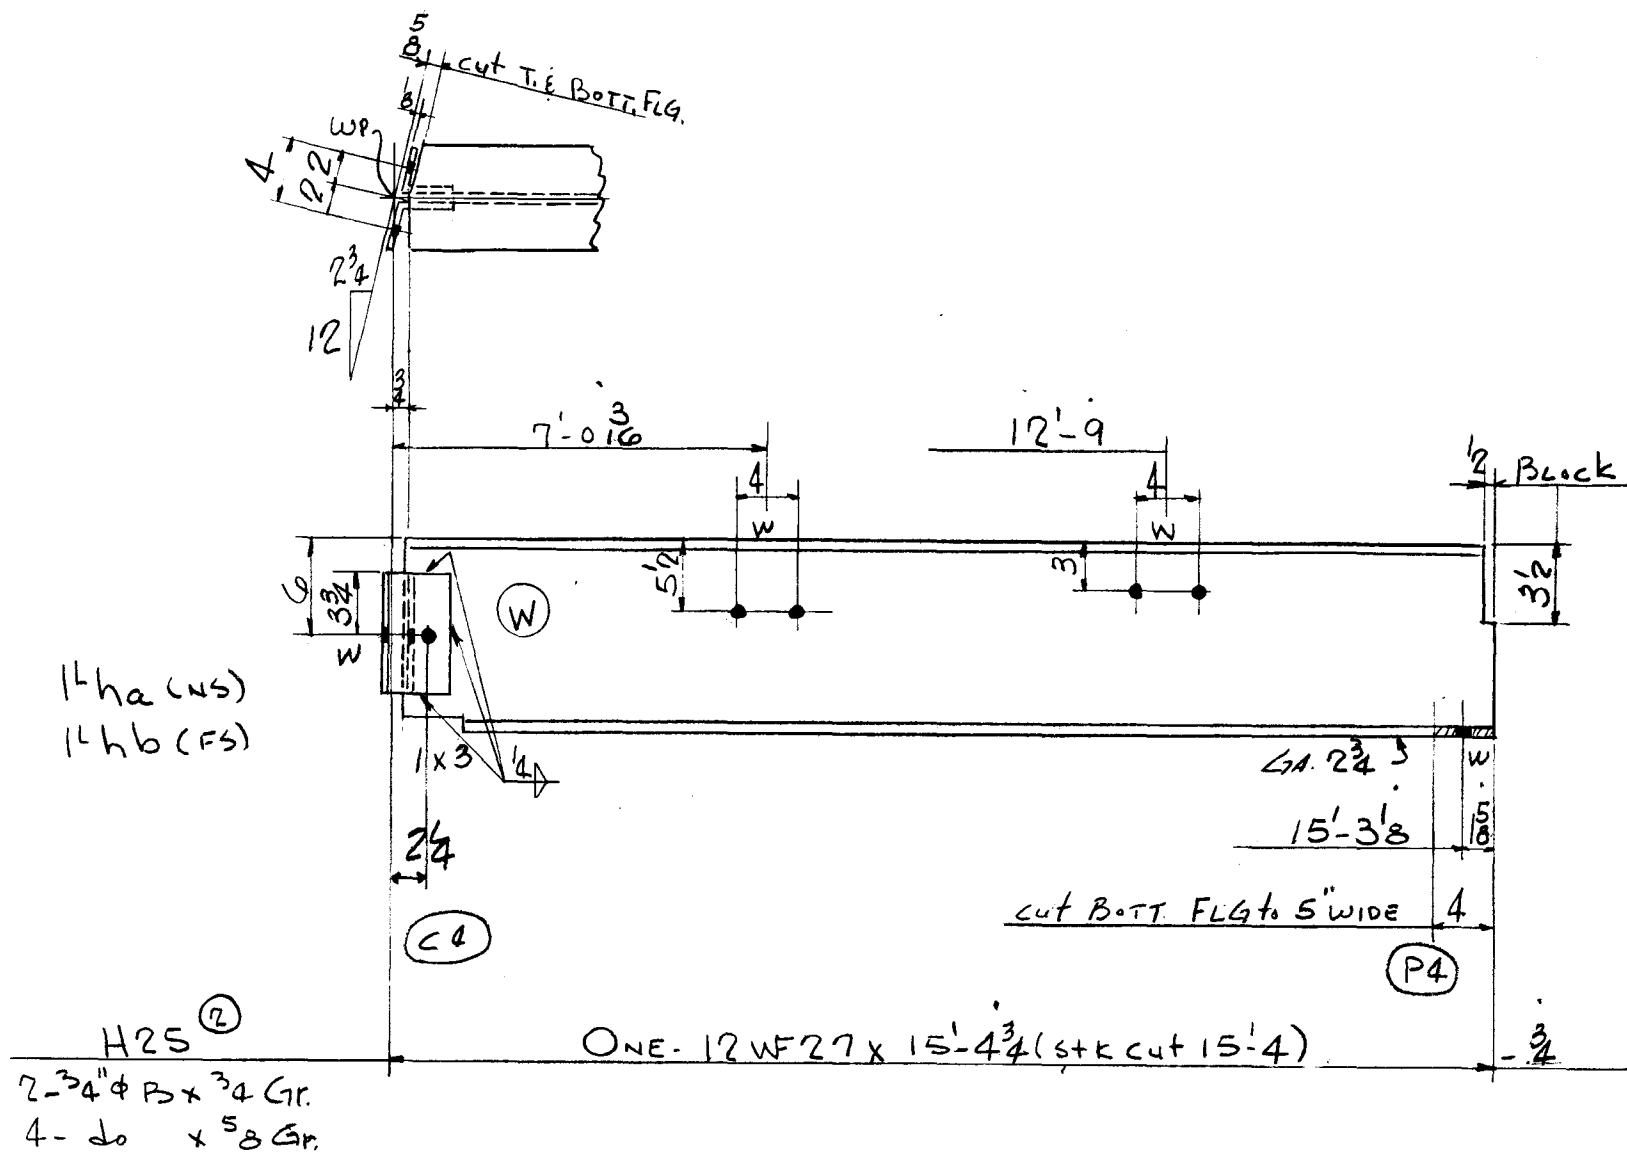

2	PAINT					
5	1 ha	L 3 1/2 x 3 1/2 x 3/8	0	7 1/2		
5	1 hb	do	0	7 1/2		
416						
428	TOTAL					

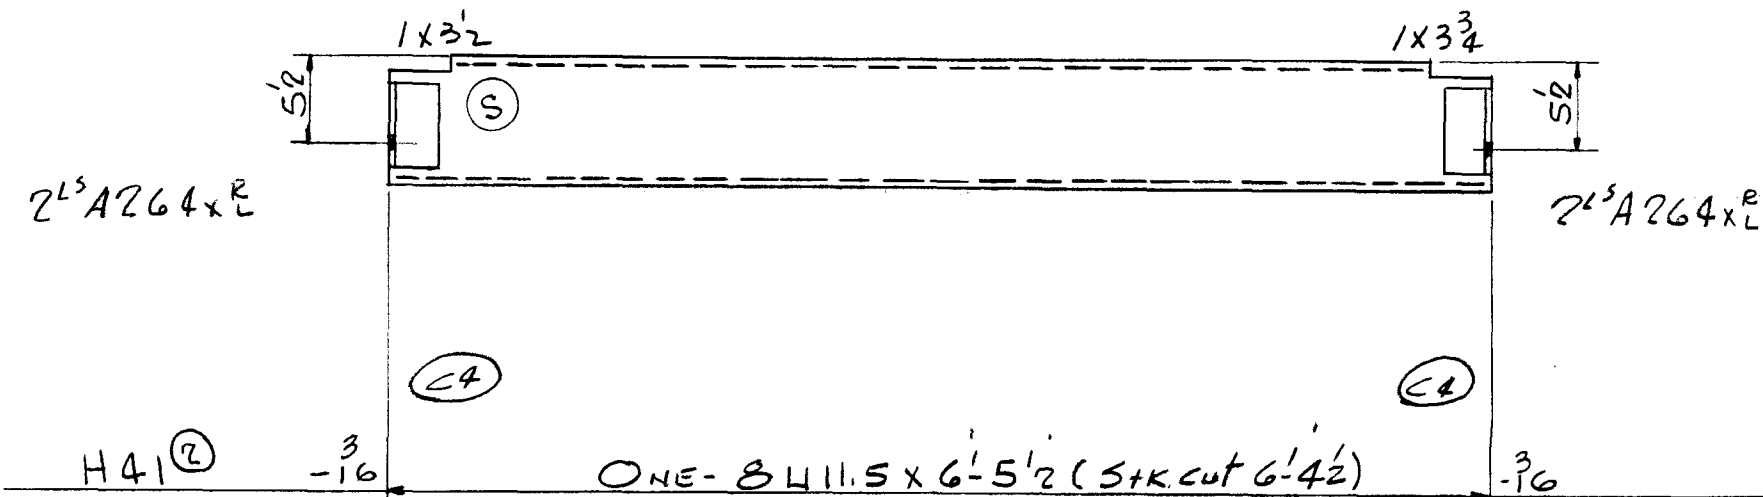

-	PAINT					
12	4 A264XL					
76						
88	TOTAL					

TOTAL	ORD.	PLATES	STD.	BOLT	RIV.	BAR	SM. STD.	PAINT	WELD
678			675						3

DET.	DATE	CHK'R.	DATE	IN CHARGE
LWS	11-10-54	CZ	12-1-54	FISHER

PIVOTS		UNLESS NOTED		CONTRACT NO.	SHEET NO.	REVISIONS	H25 Pitting Hole 12/23/54	CONTRACT NO.	SHEET NO.
OPEN HOLES		13 11/16" UNLESS NOTED		4090	B460	1-24-55: Appl. change: H41 shortened 3" - H25 shortened 1" & extension dim. changed		4090	B460

Lot 5 WELD