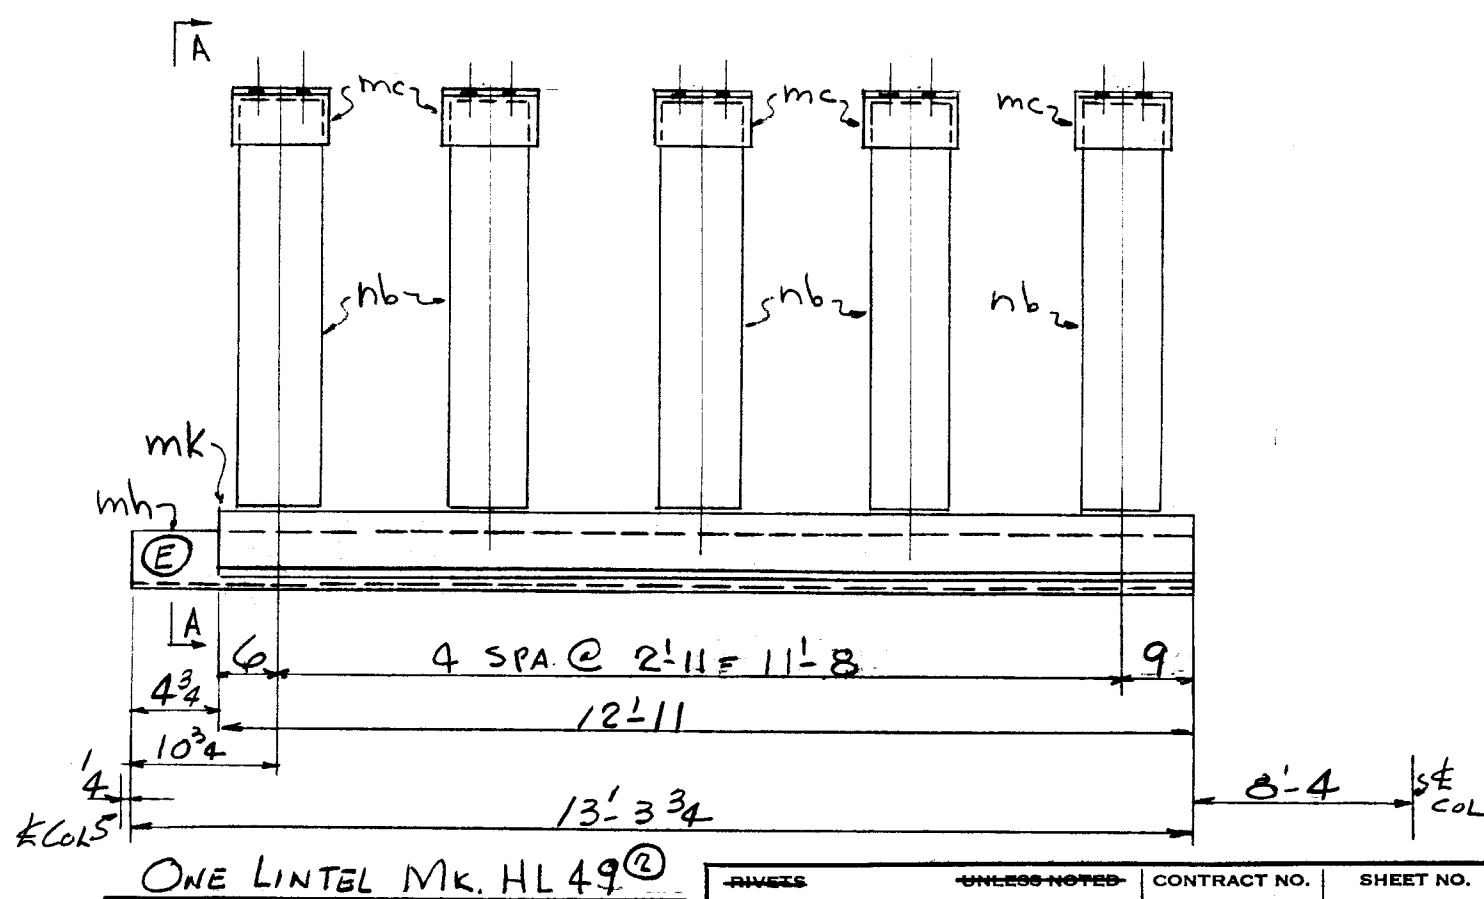
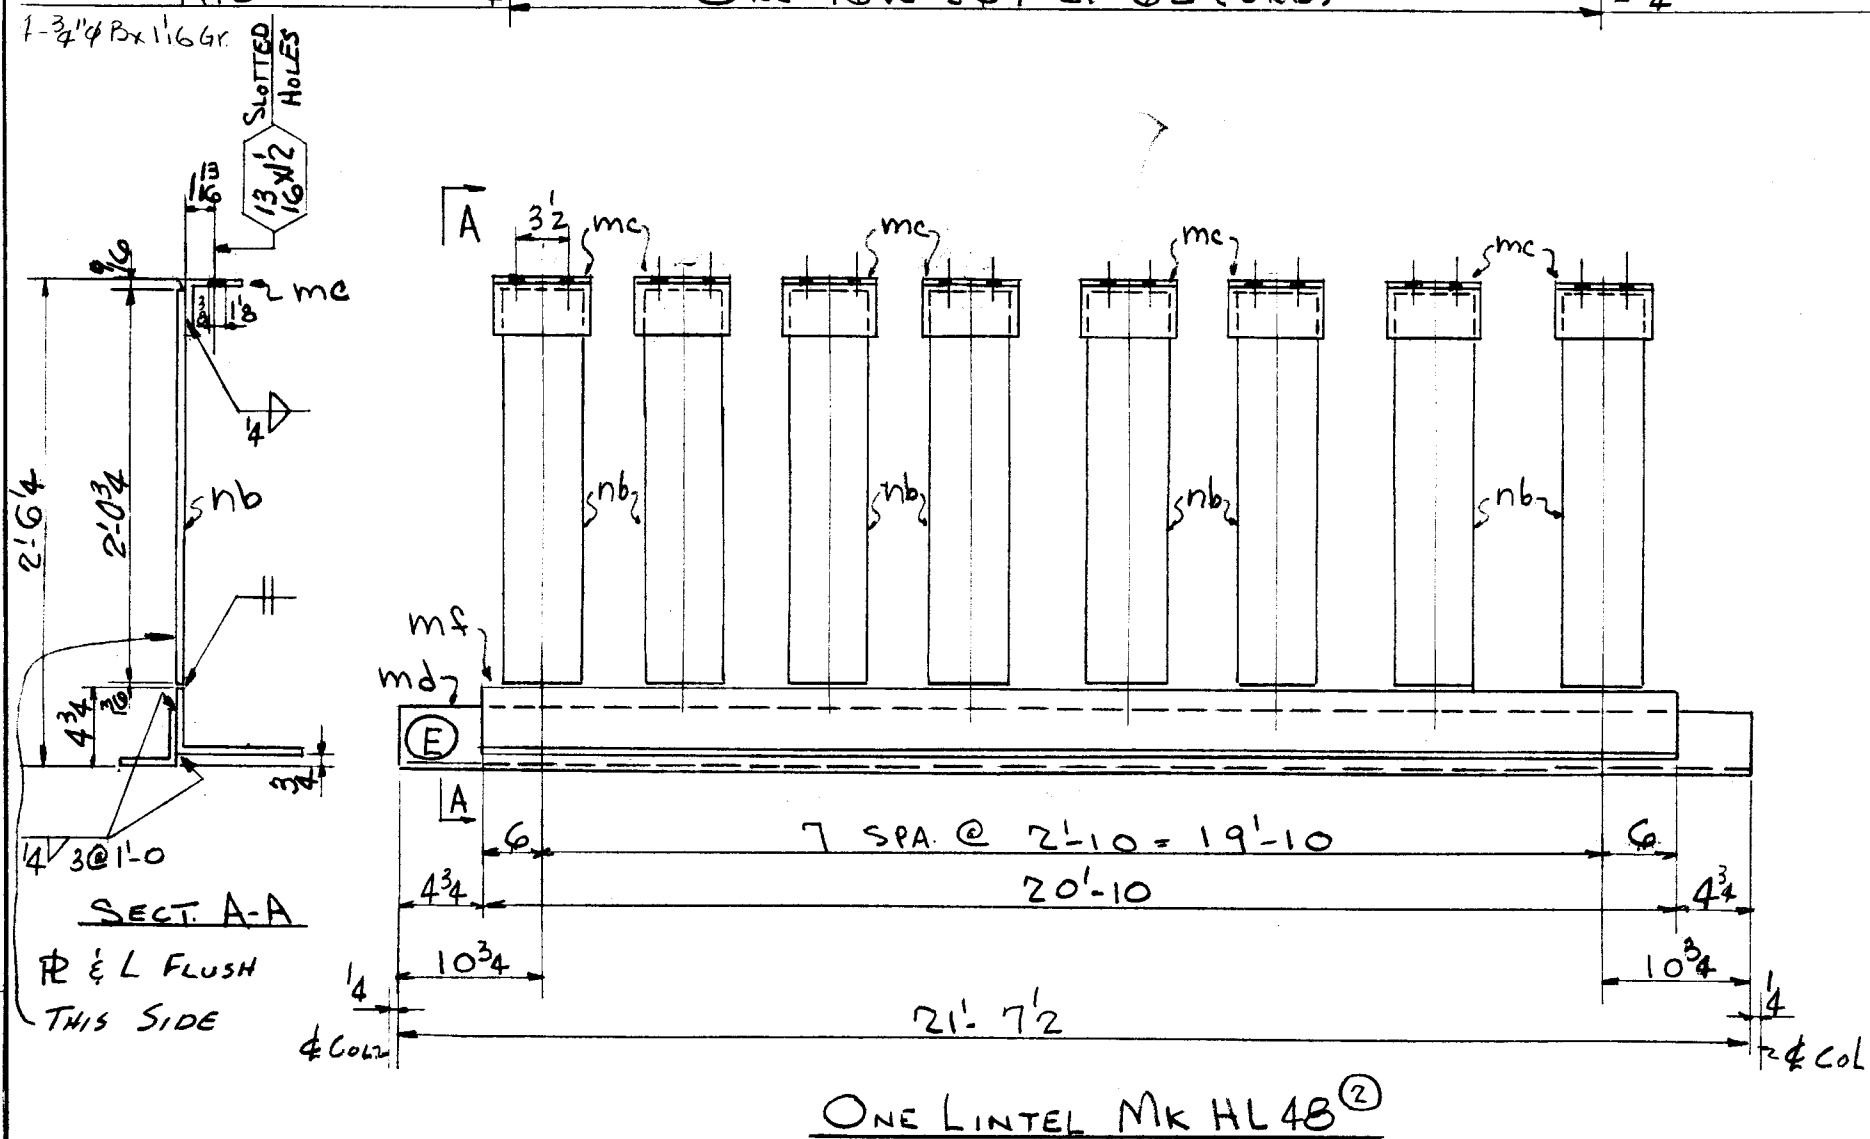
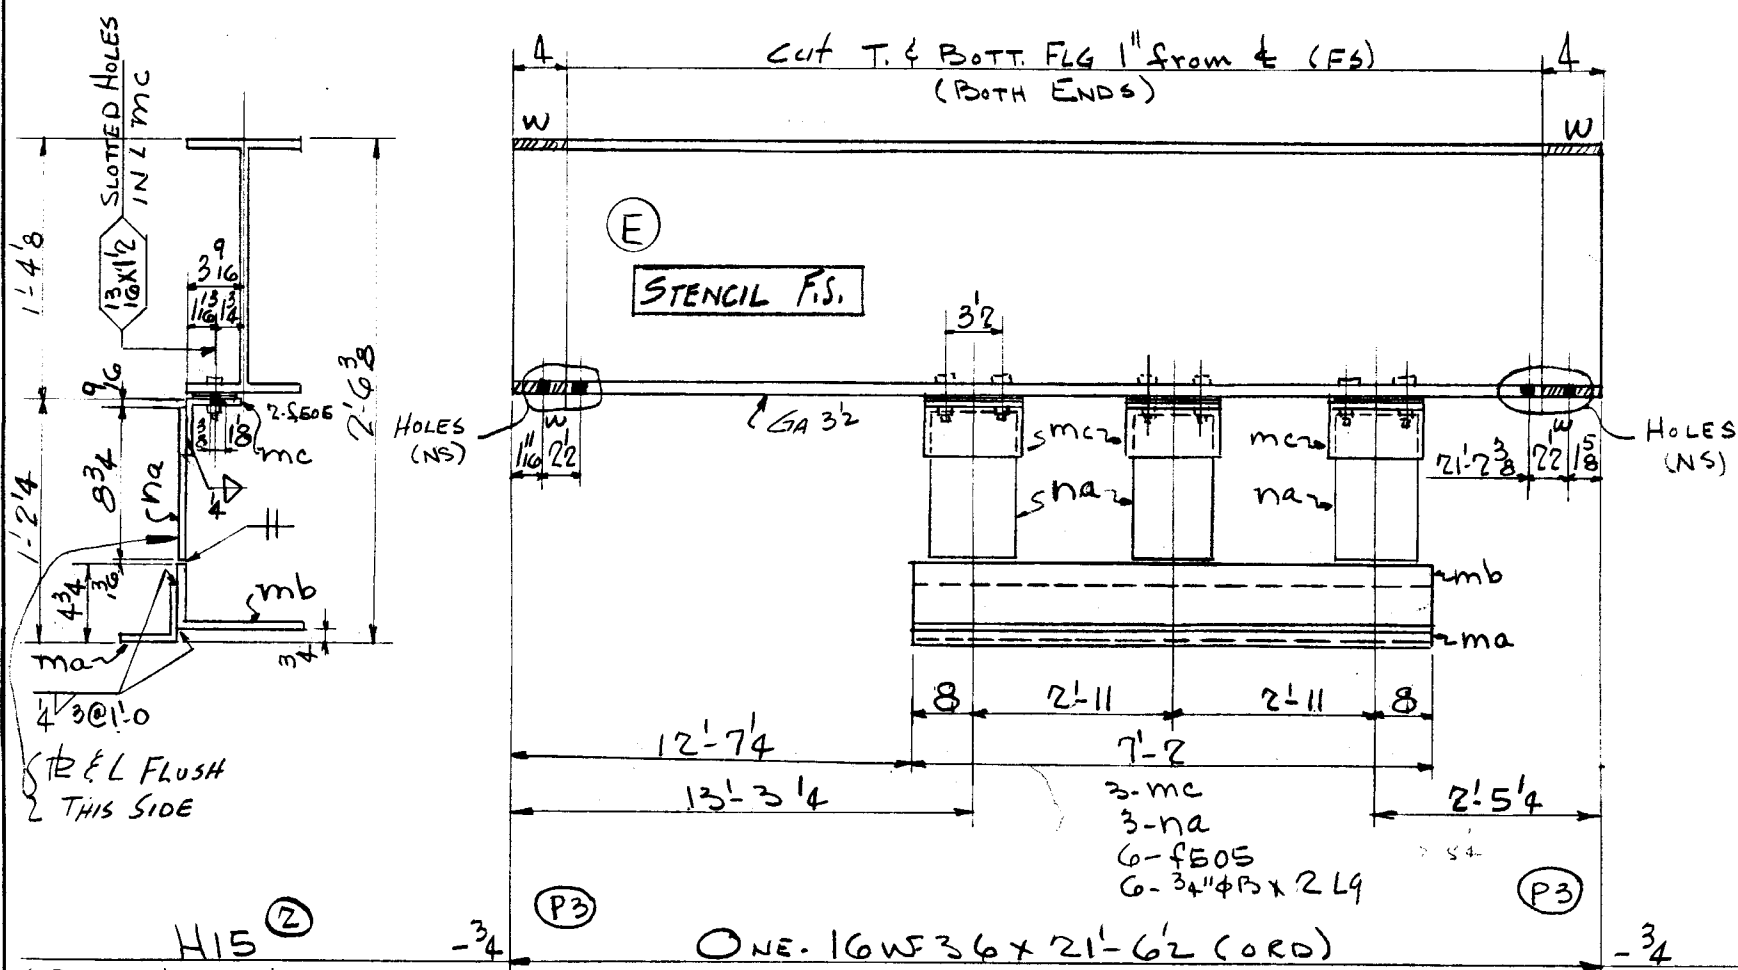


[illegible]

ONE LINTEL MK HL48 ⁽²⁾						
156	1	md	2 3/2 x 3 1/2 x 5/16	21	7 1/2	STK
358	1	mf	2 8 x 4 x 7/16	20	10	STK
34	8	mc	L			
105	8	nb	2 5 x 3/8	2	0 3/4	
3	PAINT					
656	TOTAL					

			ONE L INTEL MK.	HL	49	(2)	
21	5	mc	L				
66	5	nb	BAR				
95	1	mh	$L \frac{3}{2} \times 3\frac{1}{2} \times \frac{5}{16}$	13	33		S+K
227	1	mk	$\angle 8 \times 4 \times \frac{7}{16}$	12	11		S+K
2		Paint					
406		TOTAL					

TOTAL	ORD.	PLATES	STD.	BOLT	RIV.	BAR	SM. STD.	PAINT	WELD
2051	775	189	1074	3				10	

DET.	DATE	CHK'R.	DATE	IN CHARGE
LWS	11-23-54	CZ	12-2-54	FISHER

RIVETS		UNLESS NOTED		CONTRACT NO.	SHEET NO.	REVISIONS	CONTRACT NO.	SHEET NO.
OPEN HOLES		UNLESS NOTED		4090	B463	1-26-55: SECT. A-A 2'-6" WAS 2'-5"	4090	B463

WELD Lot 5