



NAME OF STRUCTURE
THE HARTFORD PUBLIC LIBRARY
HARTFORD - CONNECTICUT

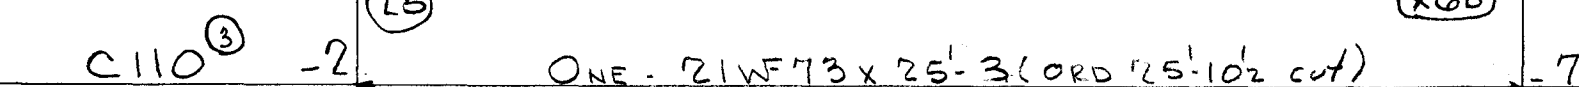

10	Paint			
29	1 Ga	Fill 4 ³ / ₄ x 1 ¹ / ₄	1	5 ¹ / ₄
25	1 Sb	Fill 3 ³ / ₄ x 1 ¹ / ₄	1	6 ³ / ₄
13	1 Pa	Fill 6 ¹ / ₄ x 1 ² / ₂	1	2 ¹ / ₂

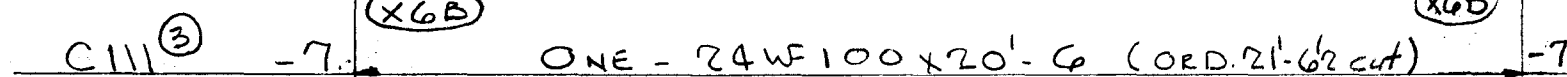

11		Paint			
56	2'	fc	FILL 3 ³ / ₄ x 14	1	9
19	1	nb	R 6'4 x 5 _B	1	5 1/2
33	1	ma	L 4 x 2'2 x 5 ₁₀	4	7 1/2 CF L 4 x 3
3	6	3/4"	4 BOLTS	0	1 3/4
19	1	nc	R 6'4 x 5 _B	1	5 1/2
8	1	ba	L 6 x 4 x 2	0	6
70	2	nd	R 10 1/4 x 2	1	11 3/8 Cut 10 1/4 x 2 x 11 3/8 M.I.E.
18	1	nf	R 7 x 2	1	6 Cut 7 x 2 x 11 3/8 M.I.E.

2050	
2287	TOTAL



TOTAL	ORD.	PLAN	STD.	BOLT	RIV.	BAR	SM. STD.	PAINT	WELD
4207	3893	249	41	3					21
DET.	DATE	CHK'R.	DATE	IN CHARGE					
LWS	11-8-54	R.C.C.	12-10-54	FISHER					
REVISIONS				CONTRACT NO.	SHEET NO.				

RIVETS	UNLESS NOTED	CONTRACT NO.	SHEET NO.	REVISIONS	CONTRACT NO.	SHEET NO.
OPEN HOLES	UNLESS NOTED	4090	B640	1-11-55: App'l. Changes to C111	4090	B640

WELD Lot 7