



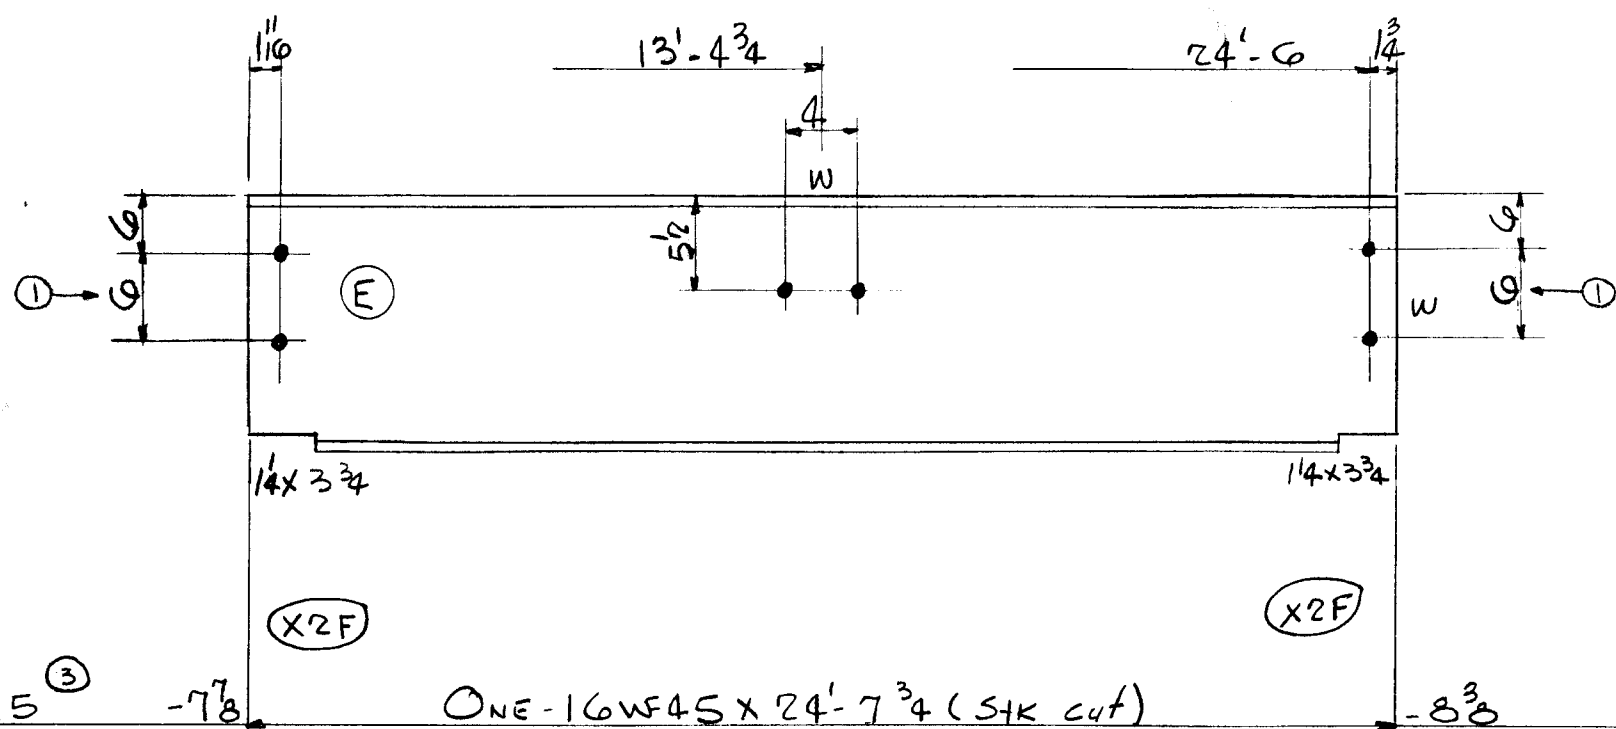


C115 ③ -7 3/8
2- 3/4" ϕ B x 3/4 Gr.
2- do x 1 1/2 Gr.
2- do x 1/4 Gr.

6 PAINT
1109
1115 TOTAL

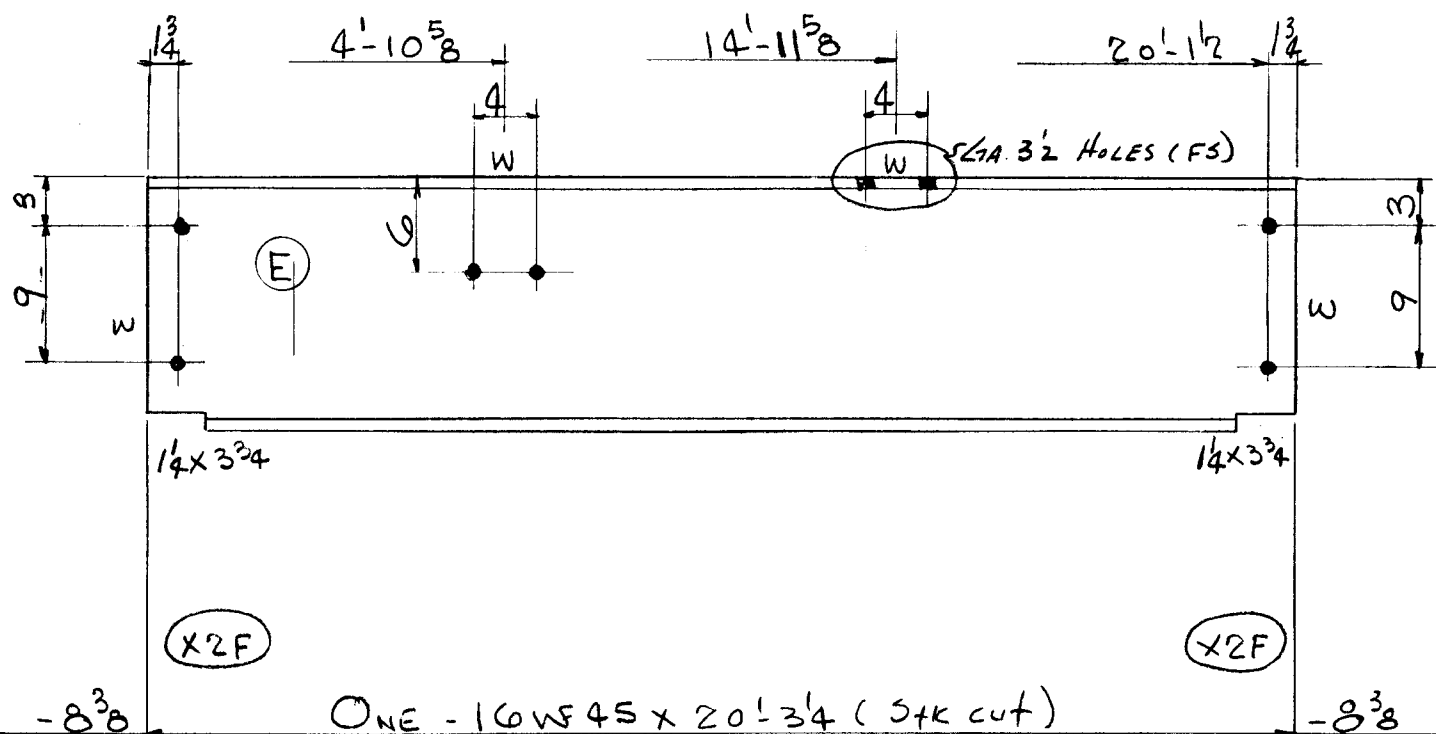

C116 ③ -8 3/8
2- 3/4" ϕ B x 3/4 Gr.
4- do x 1 1/2 Gr.
2- do x 1/4 Gr.

5 PAINT
912
917 TOTAL

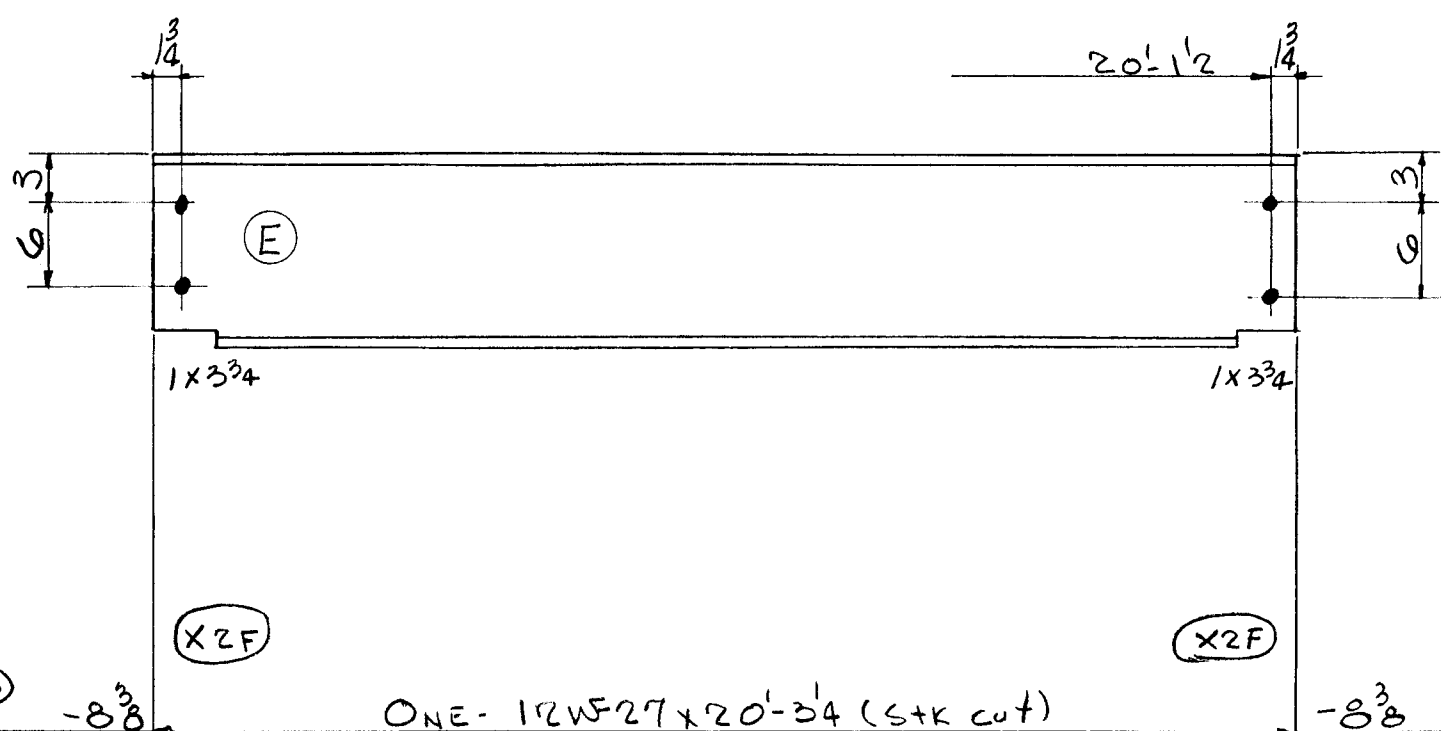

C117 ③ -8 3/8
4- 3/4" ϕ B x 1 1/2 Gr.

3 PAINT
547
550

TOTAL	ORD.	PLATES	STD.	BOLT	RIV.	BAR	SM. STD.	PAINT	WELD
-------	------	--------	------	------	------	-----	----------	-------	------

2582	2568								14
------	------	--	--	--	--	--	--	--	----

DET.	DATE	CHK'R.	DATE	IN CHARGE
------	------	--------	------	-----------

LWS	11-19-54	R.C.C.	12-8-54	FISHER
-----	----------	--------	---------	--------

CONTRACT NO.	SHEET NO.	CONTRACT NO.	SHEET NO.
--------------	-----------	--------------	-----------

4090	B641	4090	B641
------	------	------	------

REVISIONS
1-31-55: ① 6" was 9" on C115