LEHIGH STRUCTURAL STEEL CO.
ALLENTOWN, PA.

NAME OF STRUCTURE
THE HARTFORD PUBLIC LIBRARY
HARTFORD - CONNECTICUT

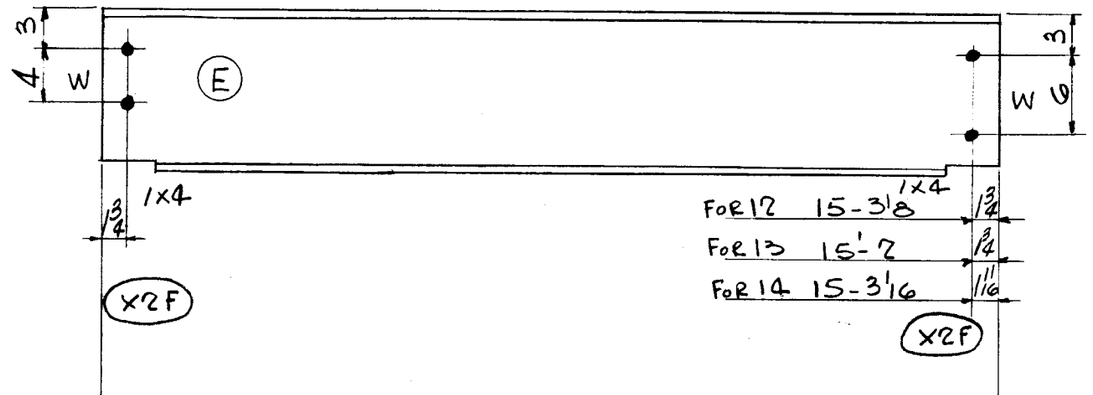

For 12 15-3 1/8
For 13 15'-2
For 14 15-3 1/16

A12 ①	-8 1/8	ONE - 12WF27 x 15'-4 7/8 (Stk)	-8	416.2	418	
A13 ①	-8 1/8	11 - do x 15'-3 3/4 (Stk)	-9 1/8	4547.23	4570	
A14 ①	-8 1/8	ONE - do x 15'-4 3/4 (Stk)	-8 1/8	416.2	418	

4 - 3/4"φ B x 1 1/8 Gr.
22 - do x 1 3/8 Gr.
26 - do x 1 1/4 Gr.

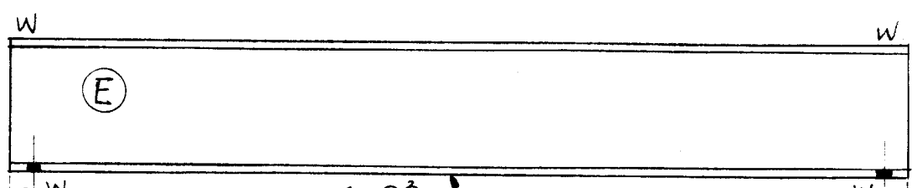

For 6 7/8
For 10 & 15 3/4

For 6 18'-6 1/8 5/8
For 10 18'-6 1/4 3/4
For 15 16'-5 5/8 7/8

P9 for A6
P4 " others
P4

A6 ①	-7/8	ONE - 10WF21 x 18'-7 3/4 (ORD)	-7/8	392.2	394	
A10 ①	-3/4	ONE - do x 18'-8 (ORD)	-3/4	392.2	394	
A15 ①	-3/4	ONE - do x 16'-7 1/2 (ORD)	-3/4	344.2	351	

12 - 3/4"φ B x 3/4 Gr.

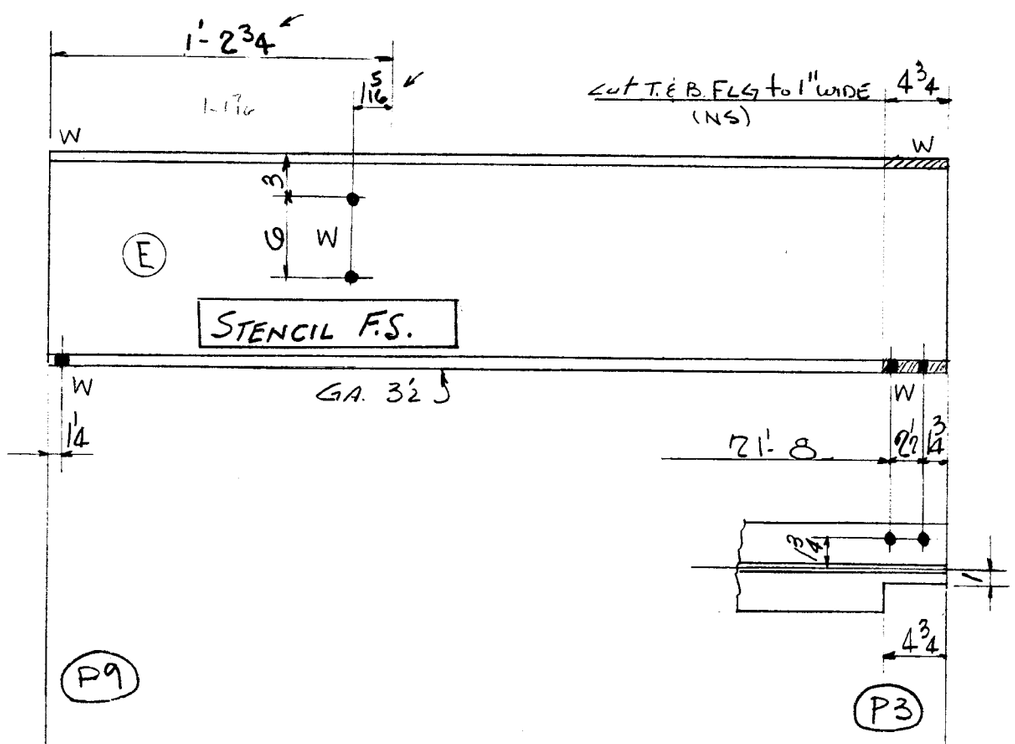

A16 ①	-1 7/8	ONE - 16WF40 x 22'-0 1/4 (ORD 22'-1 cut)	-3/4	881.4	885	

4 - 3/4"φ B x 1 Gr.
2 - do x 1 3/16 Gr.

WEIGHT		NO. PCS.	ASS'M MK.	SHAPE	LENGTH		REMARKS	ORDERED
	TOTAL							

TOTAL	ORD.	PLATES	STD.	BOLT	RIV.	BAR	SM. STD.	PAINT	WELD
7430	2014		5379					37	

DET.	DATE	CHK'R.	DATE	IN CHARGE
LWS	10-25-54	CZ	10-27-54	FISHER

~~RIVETS~~ ~~UNLESS NOTED~~
OPEN HOLES 13/16"φ ~~UNLESS NOTED~~

CONTRACT NO.	SHEET NO.
4090	B7

REVISIONS A16 Rev. 11/27/54
Stencil added 12/2/54

CONTRACT NO.	SHEET NO.
4090	B7

Lot 1