LEHIGH STRUCTURAL STEEL CO.
ALLENTOWN, PA.

NAME OF STRUCTURE
HARTFORD PUBLIC LIBRARY
HARTFORD, CONN.

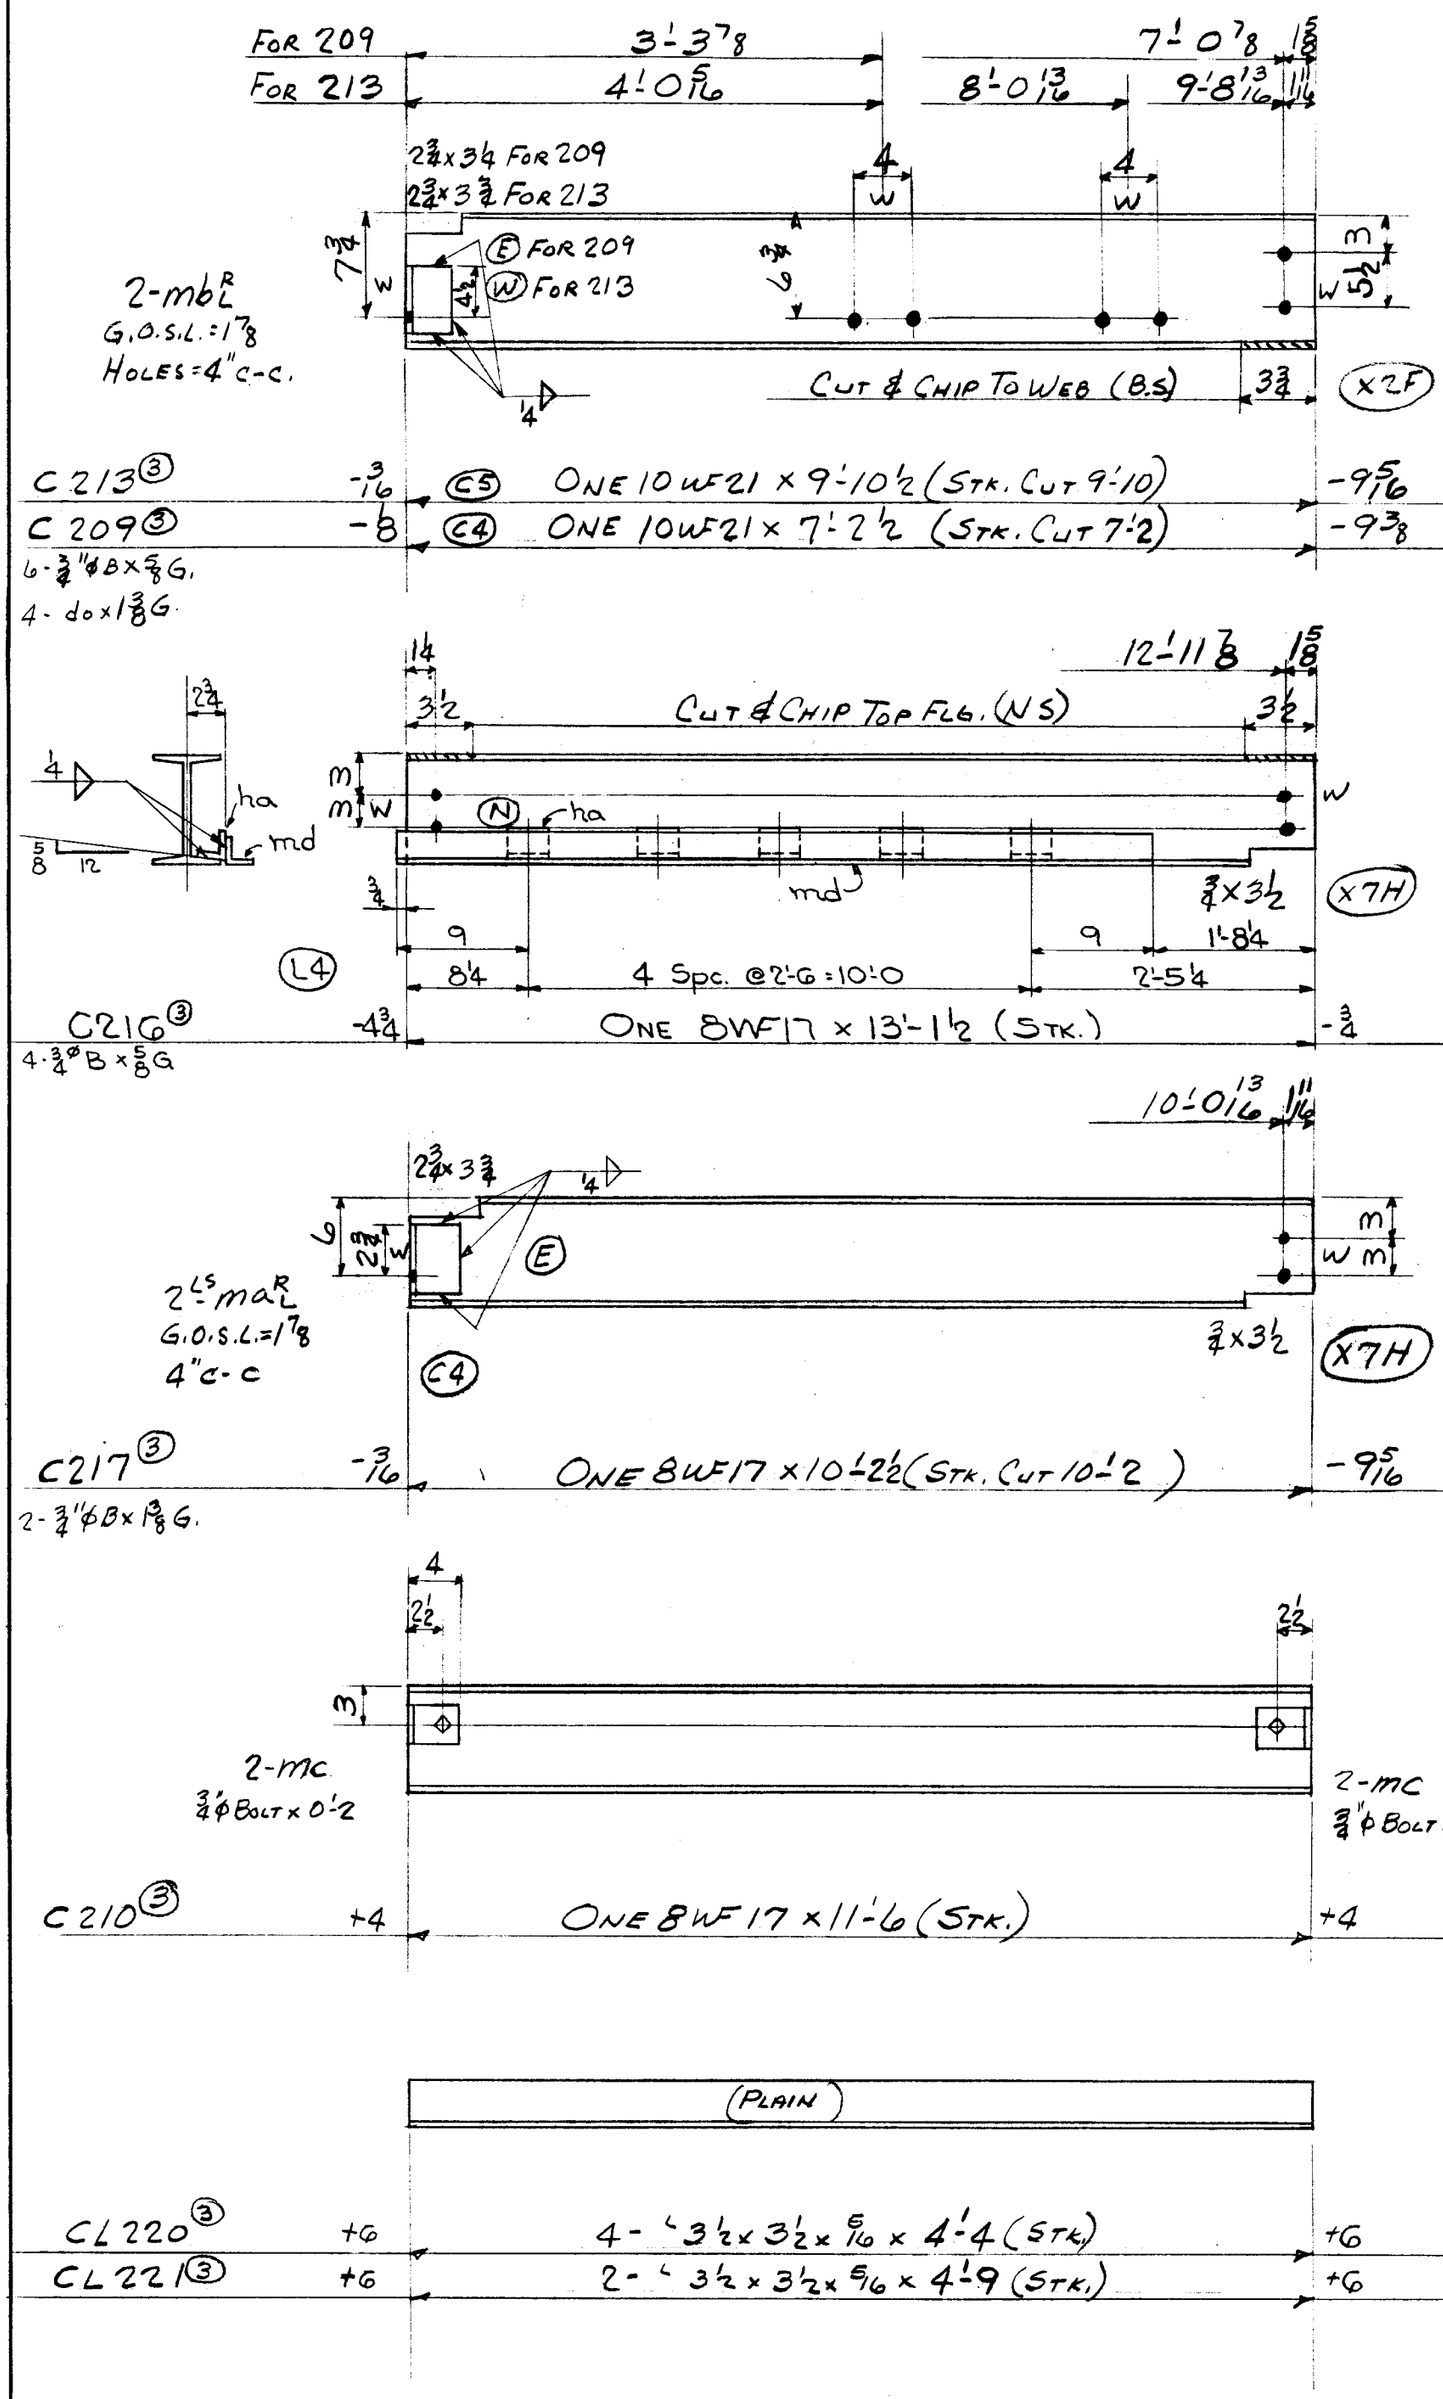

WEIGHT	NO. PCS.	ASS'M MK.	SHAPE	LENGTH		REMARKS	ORDERED
	2	PAINT					
14	4	mb^R_L	L 3 x 3 x 3/8	0	5 3/4		
206							
151							
373	TOTAL						
1	PAINT						
45	ONE	md	L 2 x 2 x 5/16	11	6		
5	5	ha	L 2 x 2 x 5/16	0	3		
230							
281	TOTAL						
1	PAINT						
5	2	ma^R_L	L 3 x 3 x 3/8	0	4		
173							
179	TOTAL						
1	PAINT						
12	4	mc	L 6 x 4 x 3/8	0	3		
1	2	3/4"ϕ BOLTS		0	2		
196							
210	TOTAL						
115							
68							

TOTAL	ORD.	PLATES	STD.	BOLT	RIV.	BAR	SM. STD.	PAINT	WELD
1226			1219	1				6	

DET.	DATE	CHK'R.	DATE	IN CHARGE
F.L.G.	Dec. 3, 54	R.C.C.	12-14-54	C.F.

RIVETS UNLESS NOTED	CONTRACT NO.	SHEET NO.	REVISIONS	CONTRACT NO.	SHEET NO.
NONE OPEN HOLES 13/16" ϕ ~~UNLESS NOTED~~			1-11-55: App'l. Changes to C216, CL220 & CL221 1-24-55: No. Pcs. added for md & ha. 3-3-55: C216 made 5" shorter	4090	B787

LOT #7 WELD