


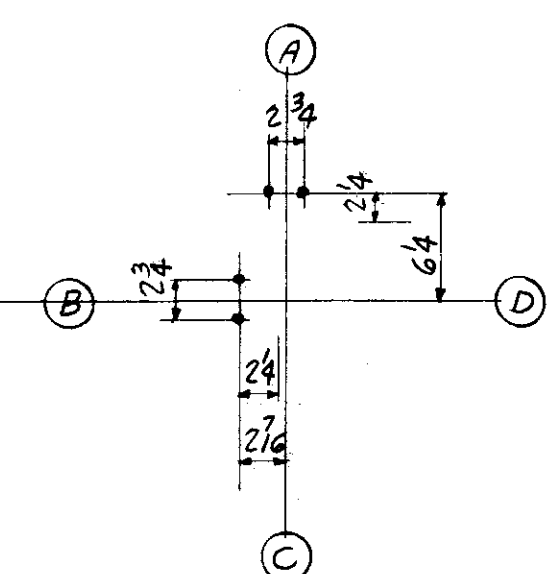

LOT 7      WELD