


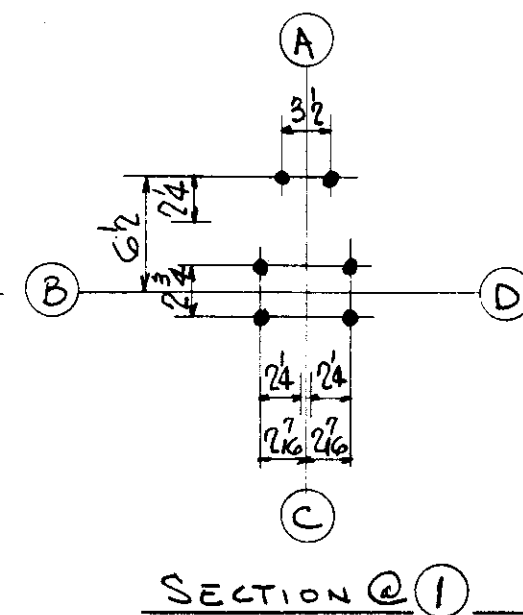

LOT 8 WELD

DET LWS DATE 9-29-54
CHK'R CZ DATE 11-17-54
IN CHARGE FISHER