


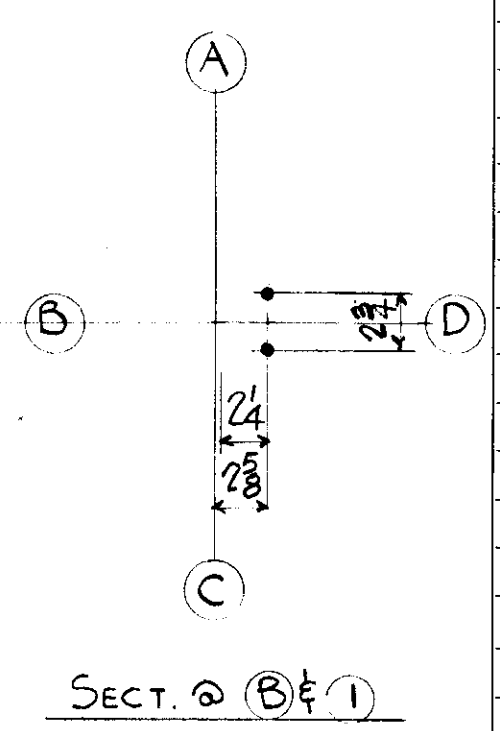

16- $\frac{3}{4}$ " ϕ B x 2 $\frac{1}{6}$ " G

TOTAL	ORD.	PLATES	STD	BOLT	RIV.	BAR	SM. STD.	PAINT
3356	3314		25					17
REVISIONS 11-12-54: Shortened col. approval change 12-13-54: COVER IT. NO ADDED. REV. 1/3/55 Cov. R removed by Engr						CONTRACT NO. 4090		SHEET NO. C3

SLAB

LOT 1 WELD