



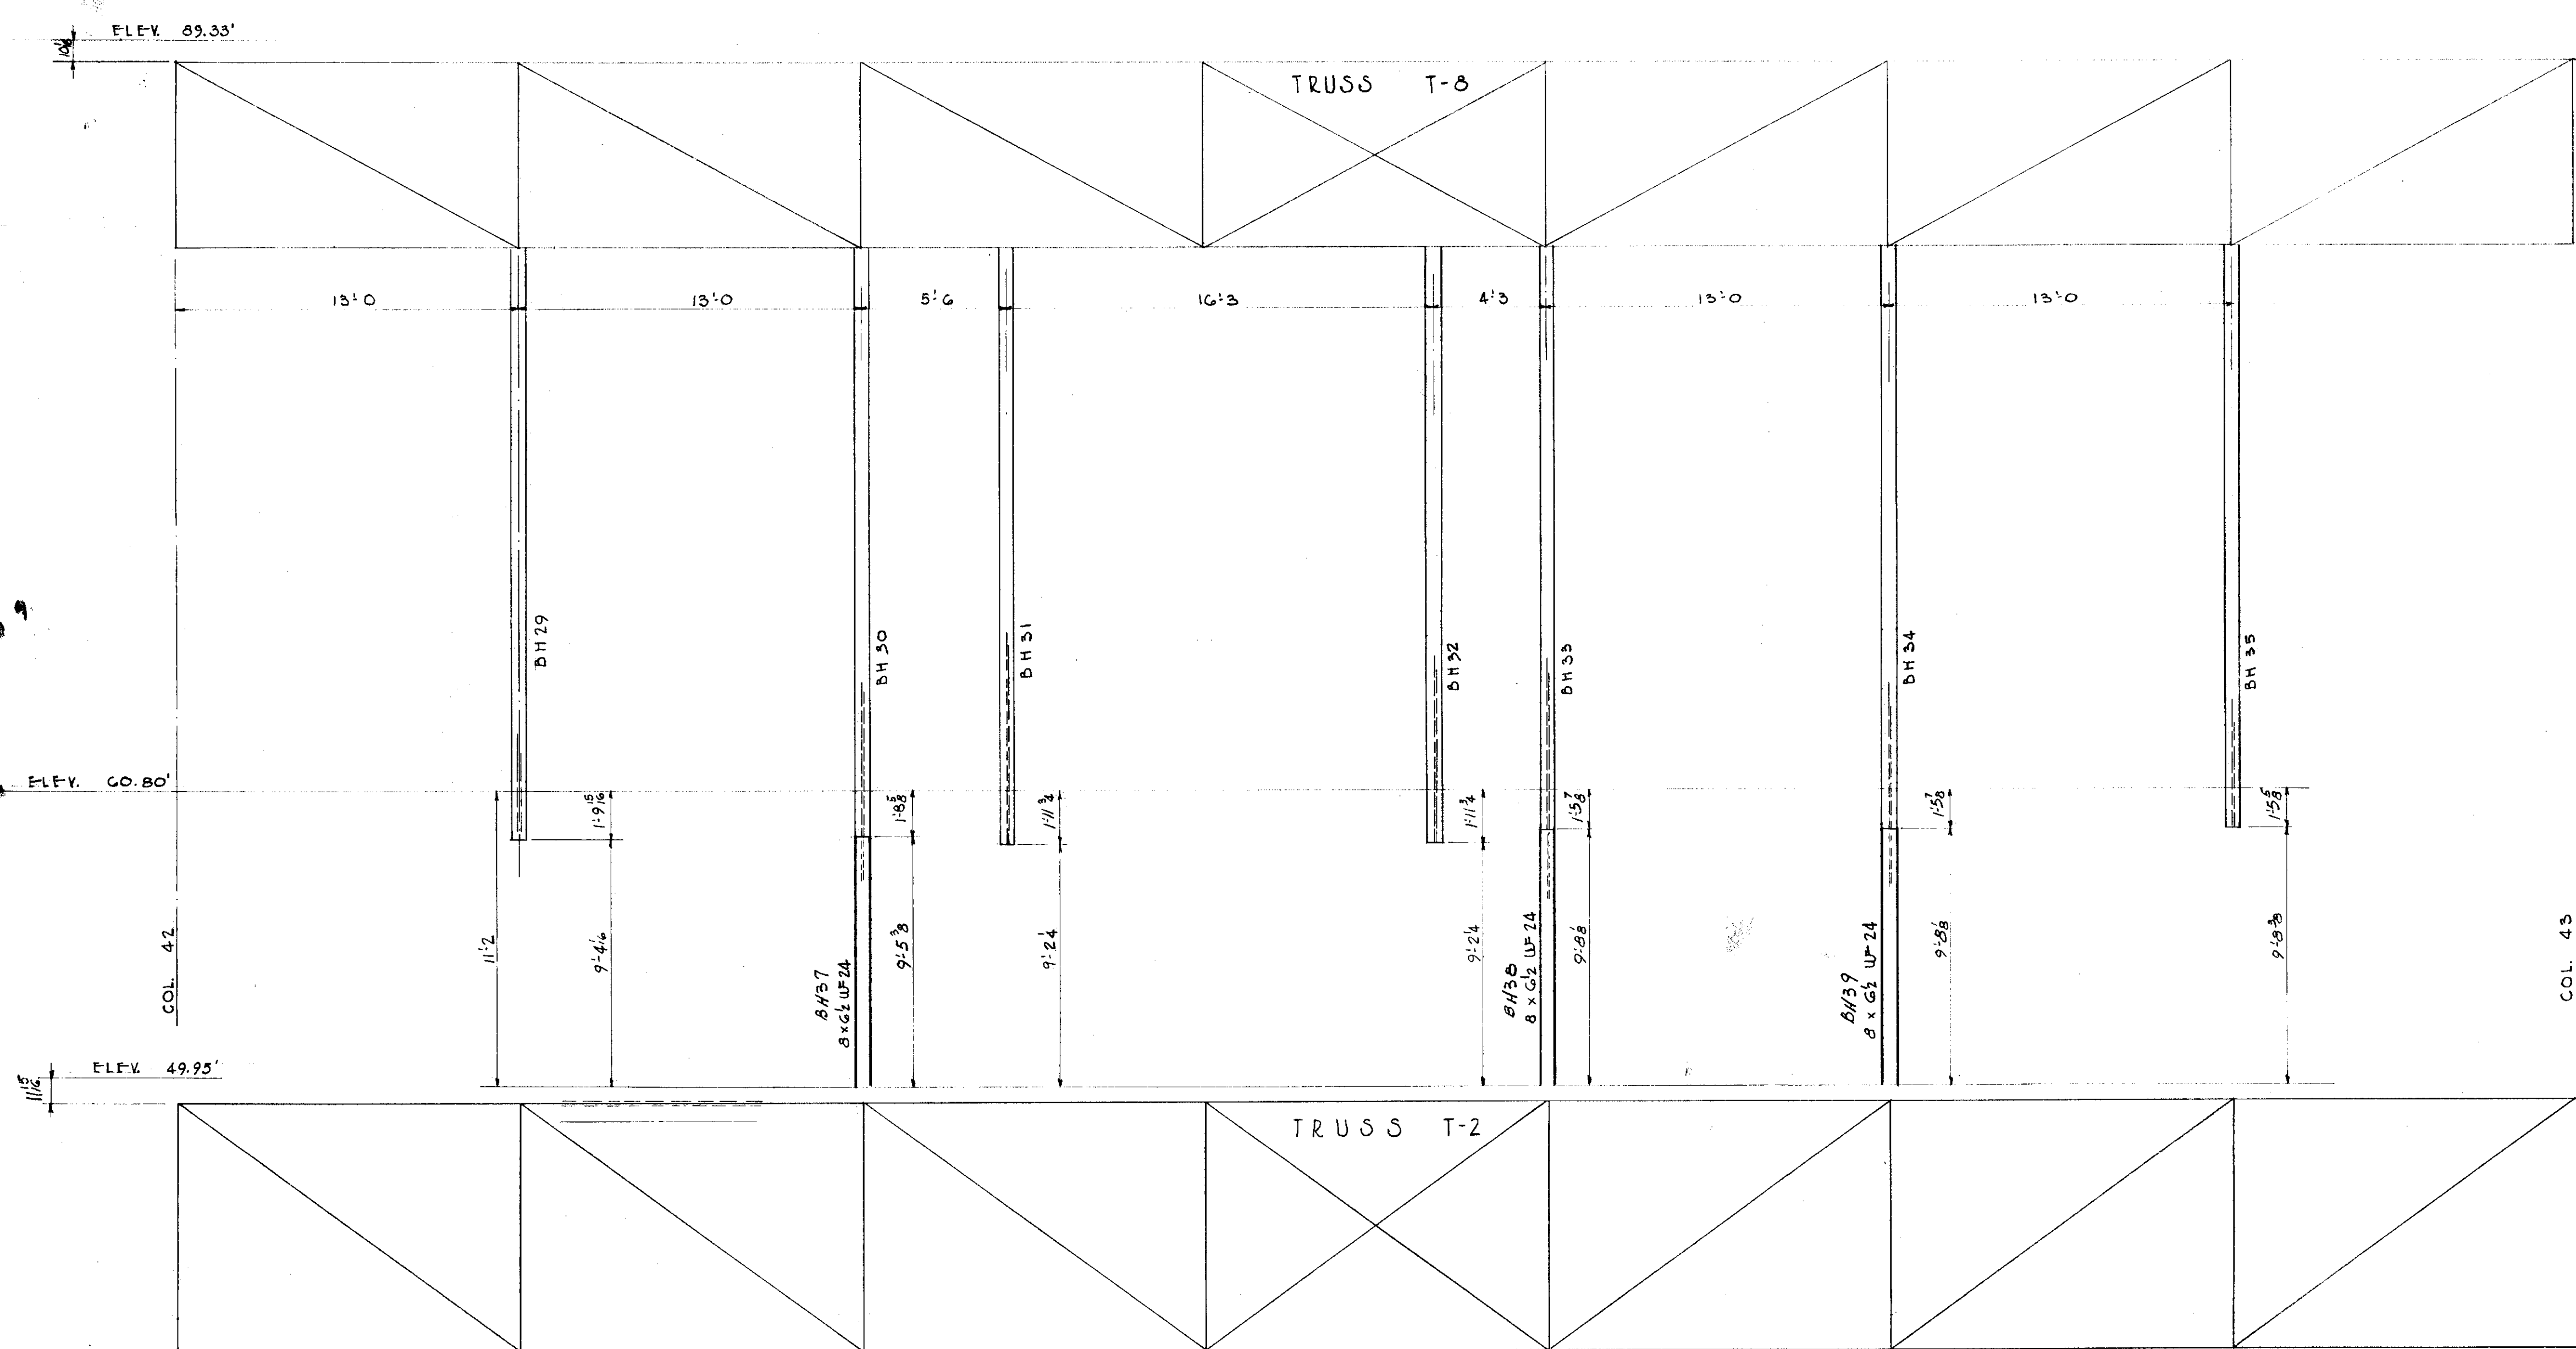

E L E V A T I O N

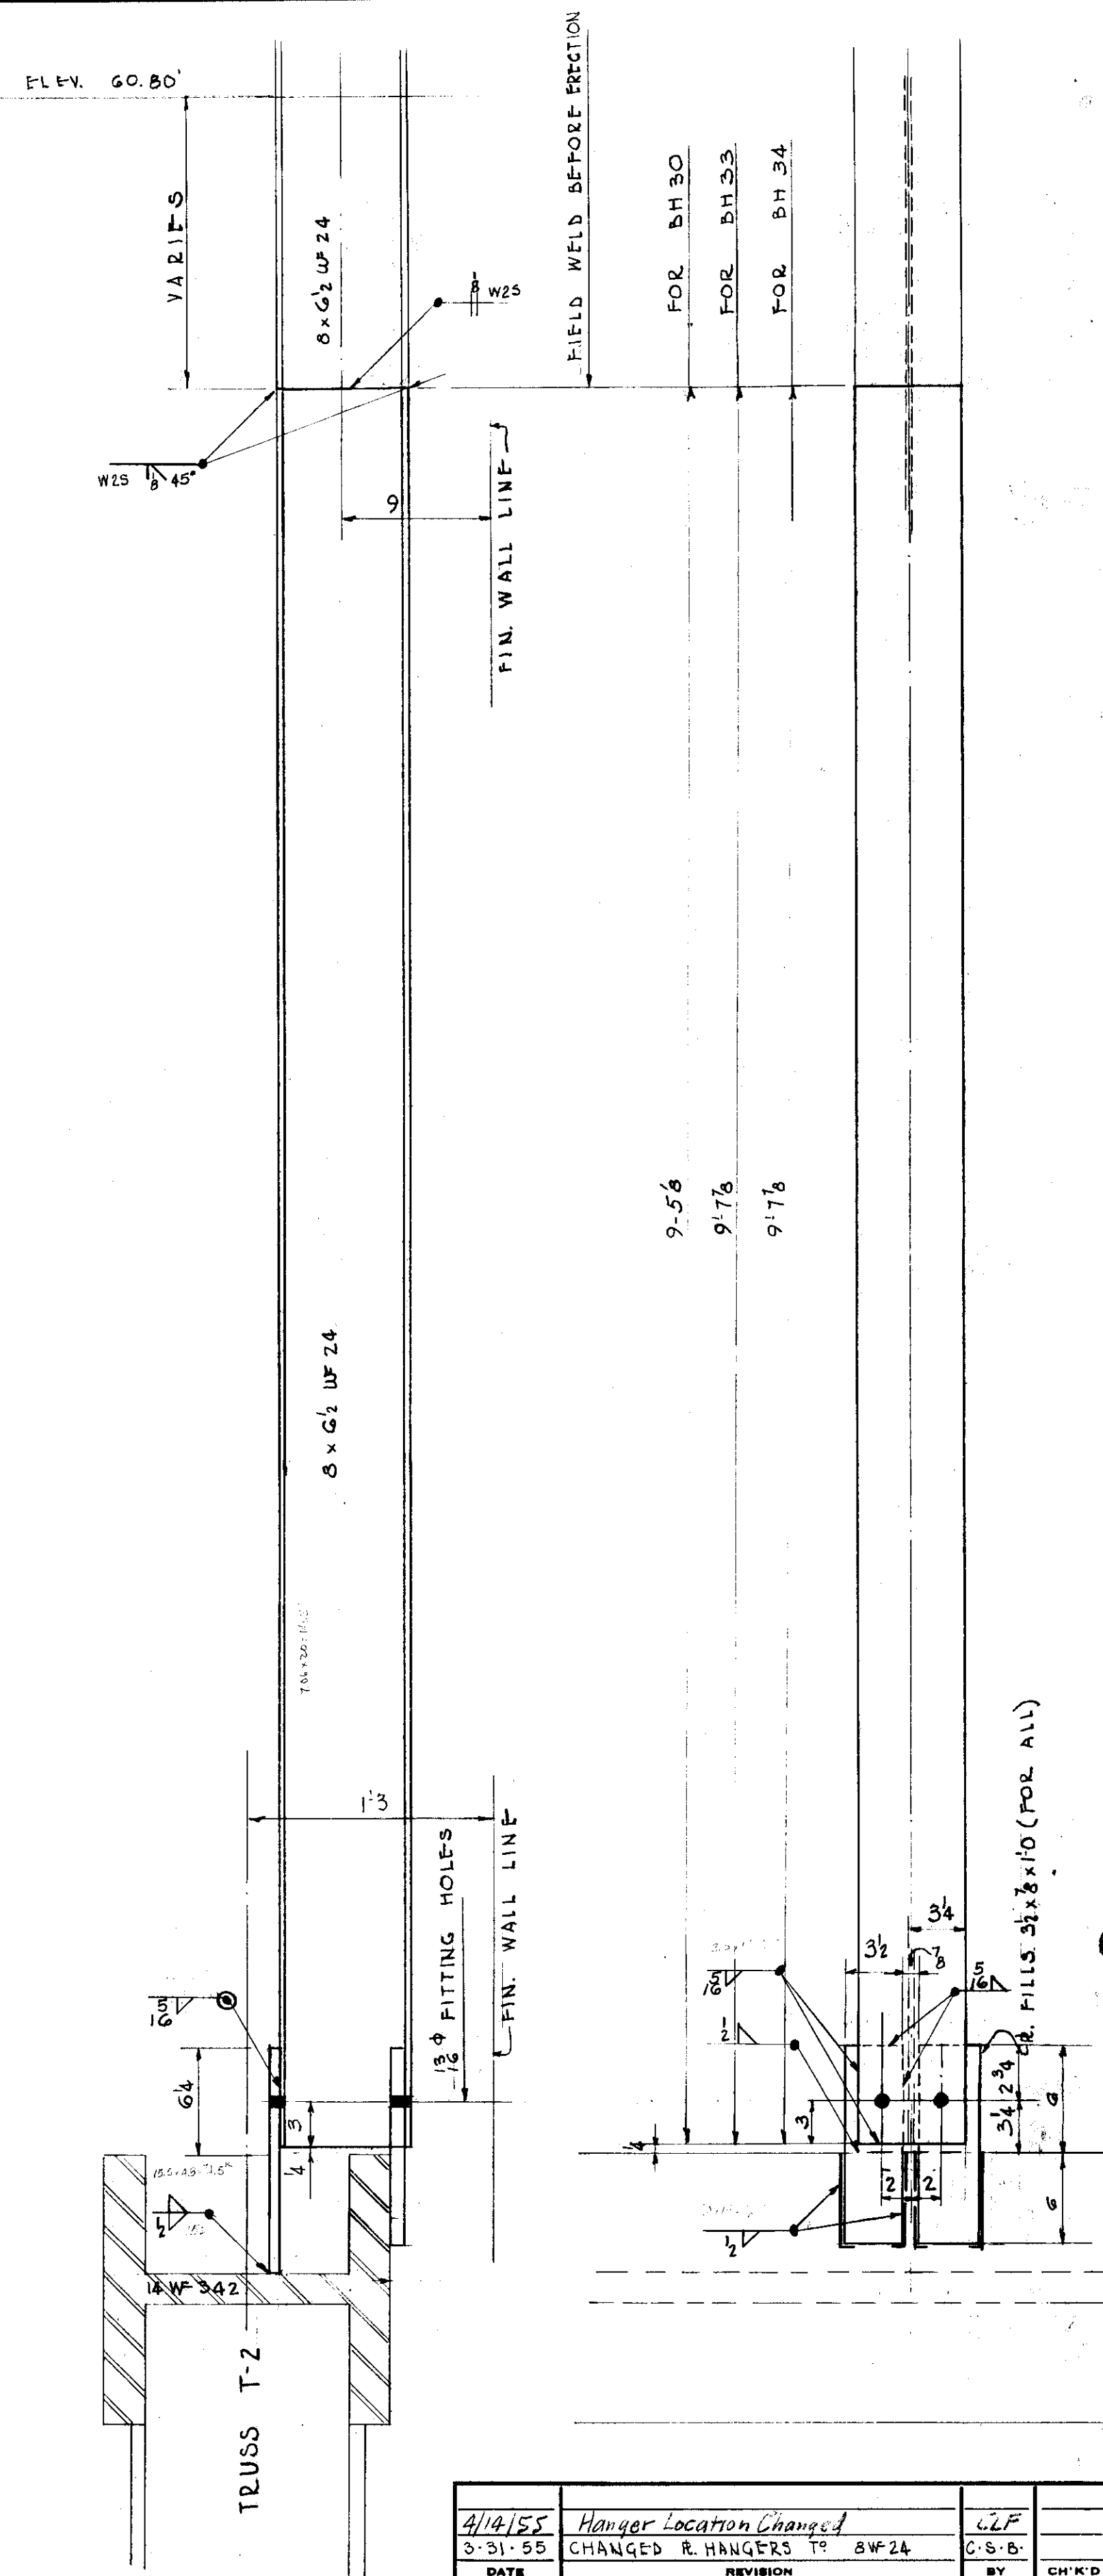

4/14/55	Hanger Location Changed	CLF
3:31:55	CHANGED R. HANGERS TO 8"x24"	C.S.B.
DATE	REVISION	BY

CH'K'D

Lehigh Structural Steel Co.

ALLENTOWN, PA.

SUPPLEMENTARY HANGERS

HARTFORD PUBLIC LIBRARY

HARTFORD, CONN.

IN CHARGE OF DRAWN BY CHECKED BY SCALE	C. Linker, D.E.K. DATE: APRIL 05 DATE: _____ DATE: _____	CONTRACT NUMBER SHEET NUMBER
		4090 D-102