


LEHIGH STRUCTURAL STEEL CO.
ALLENTOWN, PA.

WEIGHT

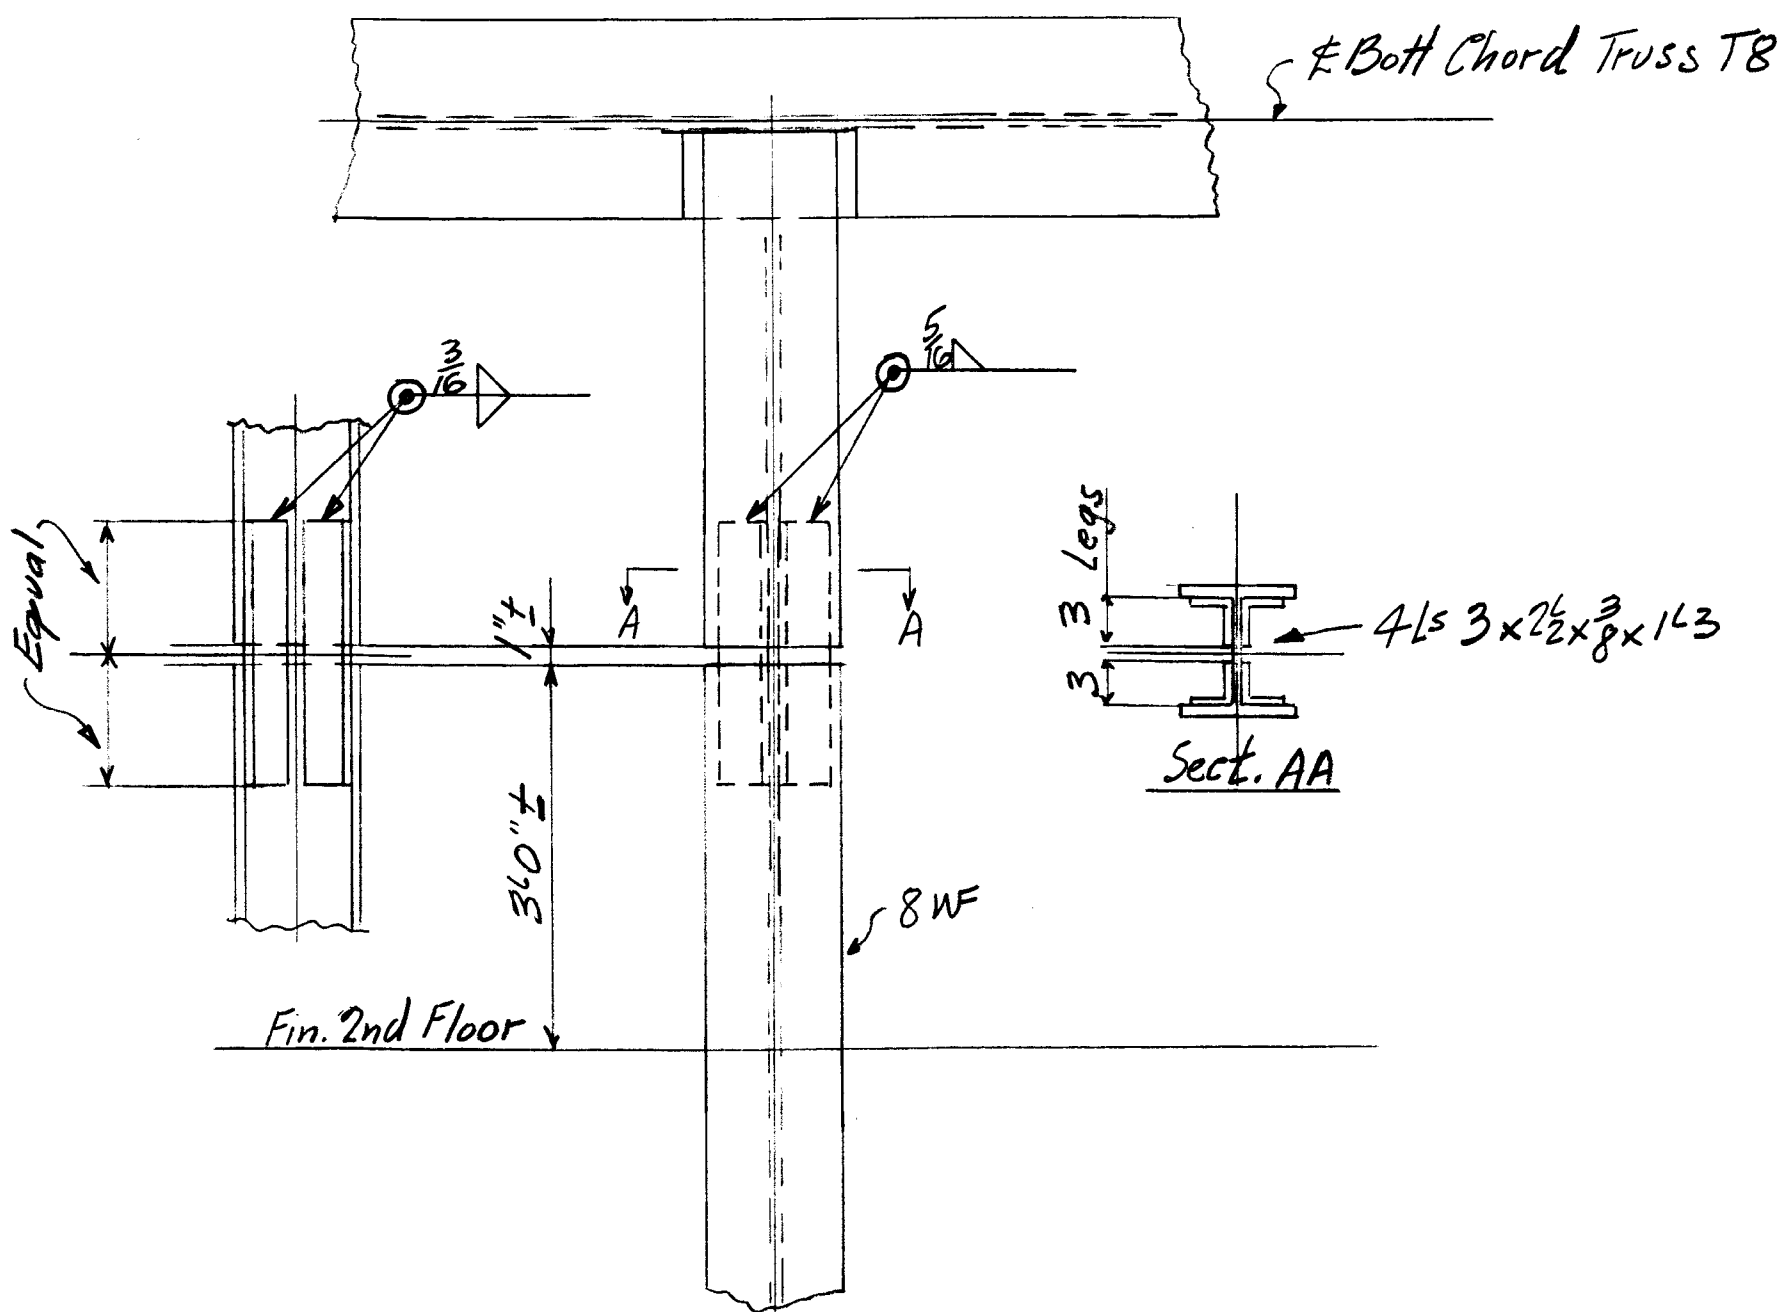

Proposed Alteration to 5 Members Below Truss T8[®]
(Field to determine members to be altered.)

HARTFORD PUBLIC LIBRARY
HARTFORD, CONN.

TOTAL	ORD.	PLATE	STD.	BOLT	RIV.	BAR	SM. STD.	PAINT
-------	------	-------	------	------	------	-----	----------	-------

DRWERS	UNLESS NOTED	DET.	DATE
		CHK'R	DATE
		IN CHARGE	CLF

REVISION

CONTRACT NO.

SHEET NO.

4090

FD20