



LEHIGH STRUCTURAL STEEL CO.
ALLENTOWN, PA.

WEIGHT

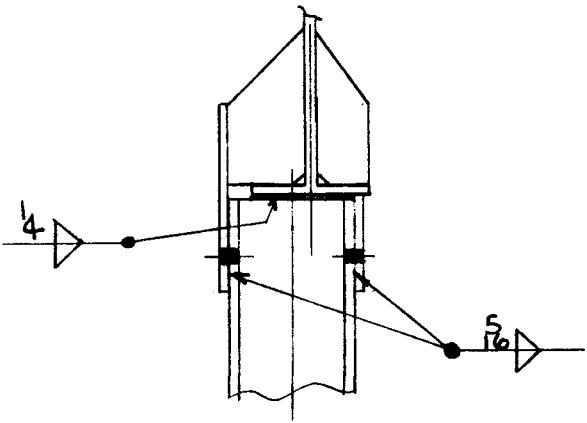

RCS-CZ. E.R.M.


X6A

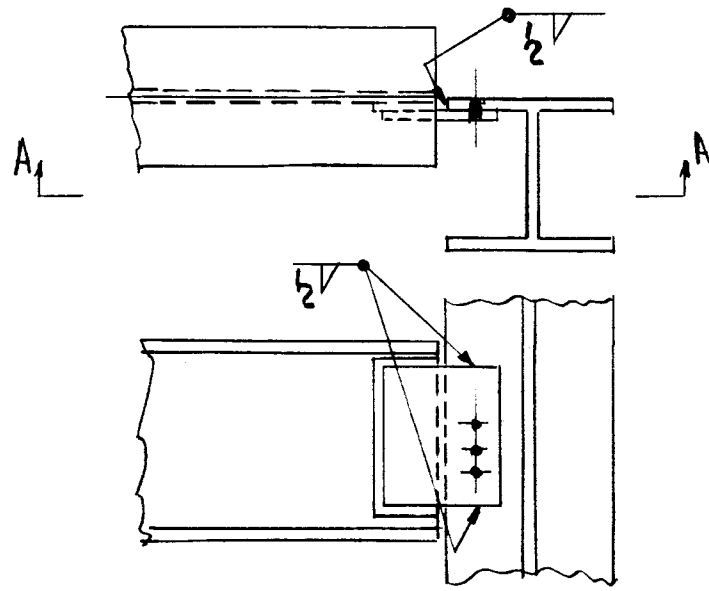

LWS-RCC.


SECT. A-A

X6B

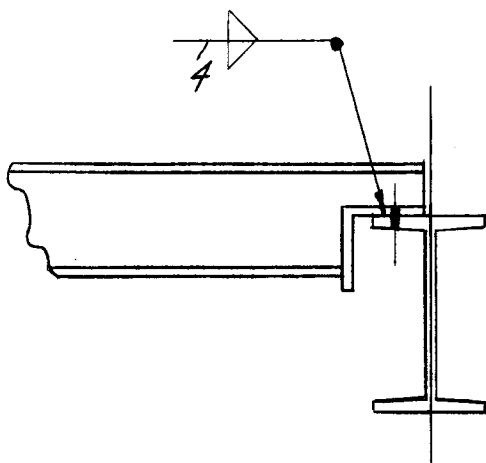


F.F.
J.B.O.-RCC.

X6C

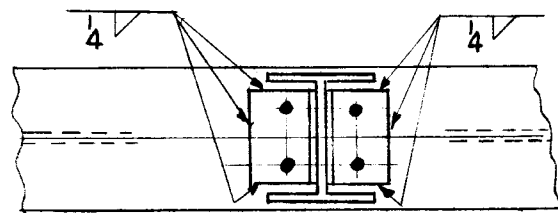


F.L.G.

X6D

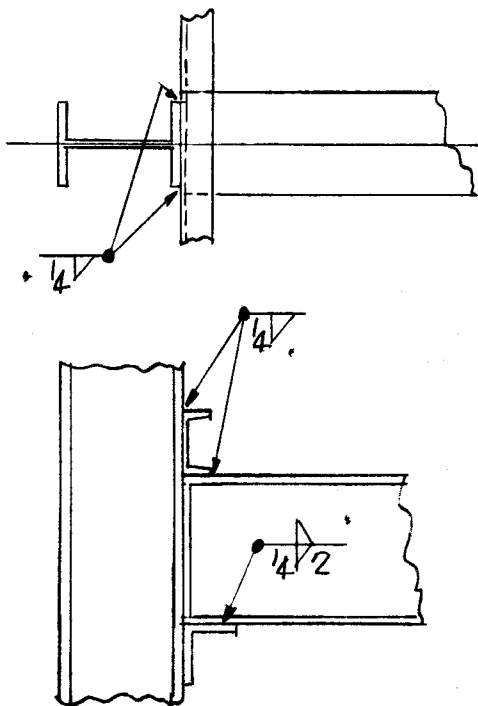


LWS-CZ

X6E

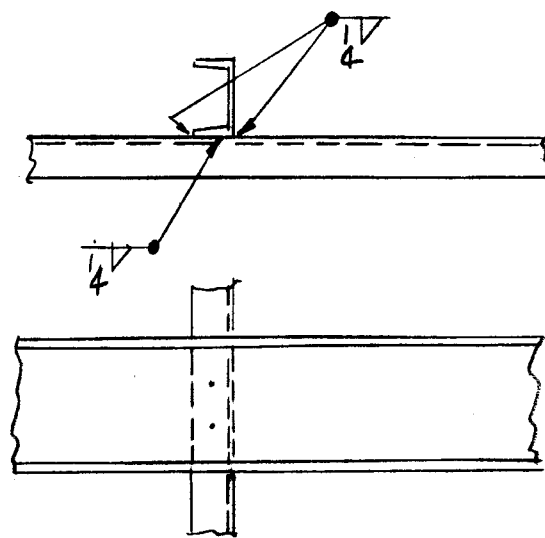

LWS-CZ


X6F

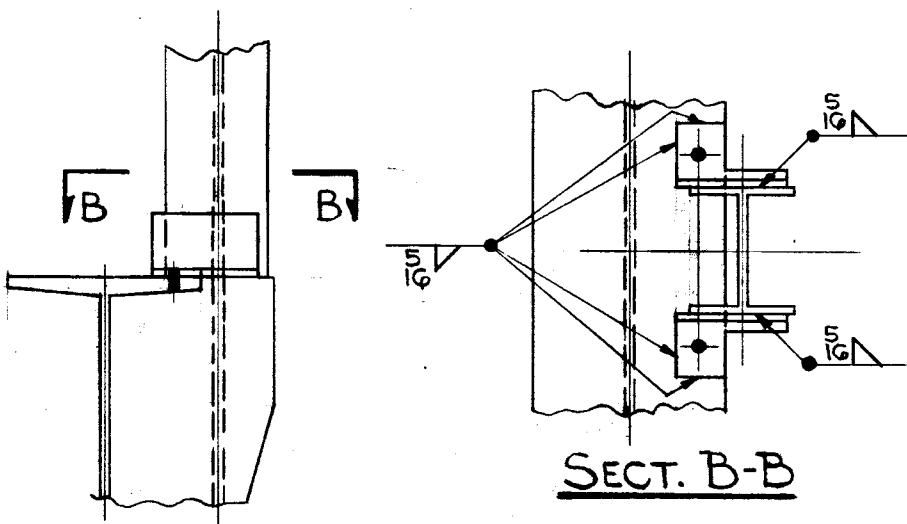

LWS-RCC.

SECT. B-B

X6G

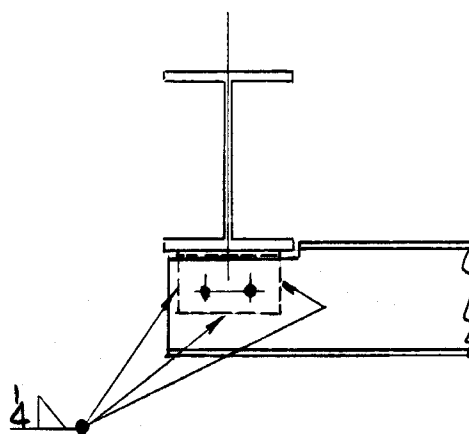

LWS-RCC.

X6H

THE HARTFORD PUBLIC LIBRARY
HARTFORD - CONNECTICUT

TOTAL	ORD.	PLATE	STD.	BOLT	RIV.	BAR	SM. STD.	PAINT

RIVETS	UNLESS NOTED	DET.	DATE
OPEN HOLES	UNLESS NOTED	CHK'R	DATE
		IN CHARGE	FISHER

REVISION
1-11-55: App'l. Changes to X6B & X6G

CONTRACT NO.

4090

SHEET NO.

X6