
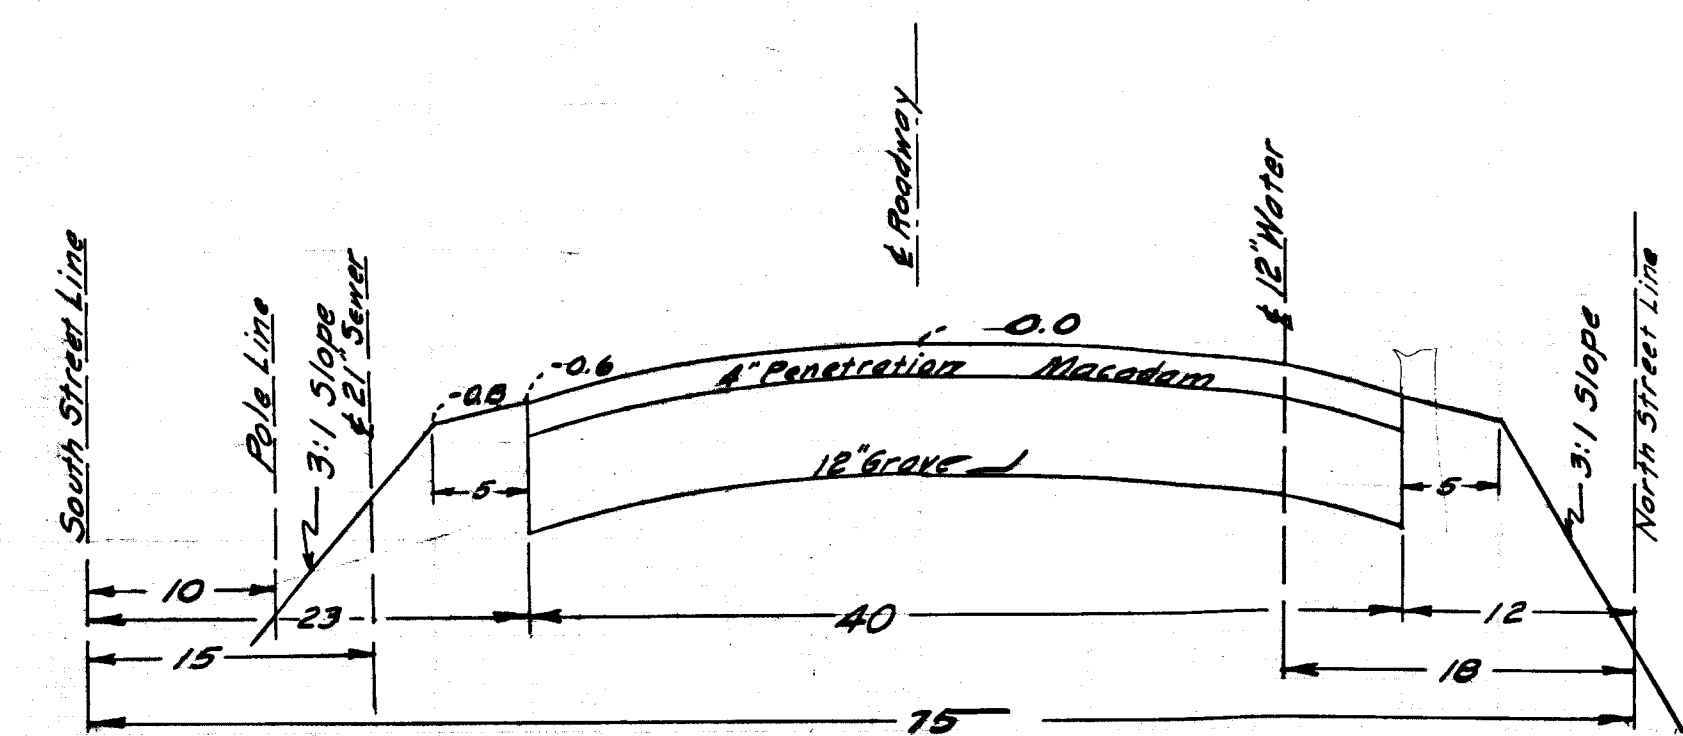


FISHFRY STREET
 WEST SERVICE ROAD TO WESTON ST.
 CURB PROFILE
 STATIONS MEASURED ON LINE 43 NORTH OF SOUTH ST. LINE
 SCALE ~ VER. 1"=4', HOR. 1"=40'
 NOTE BOOK
 DAY BOOK No

(19)

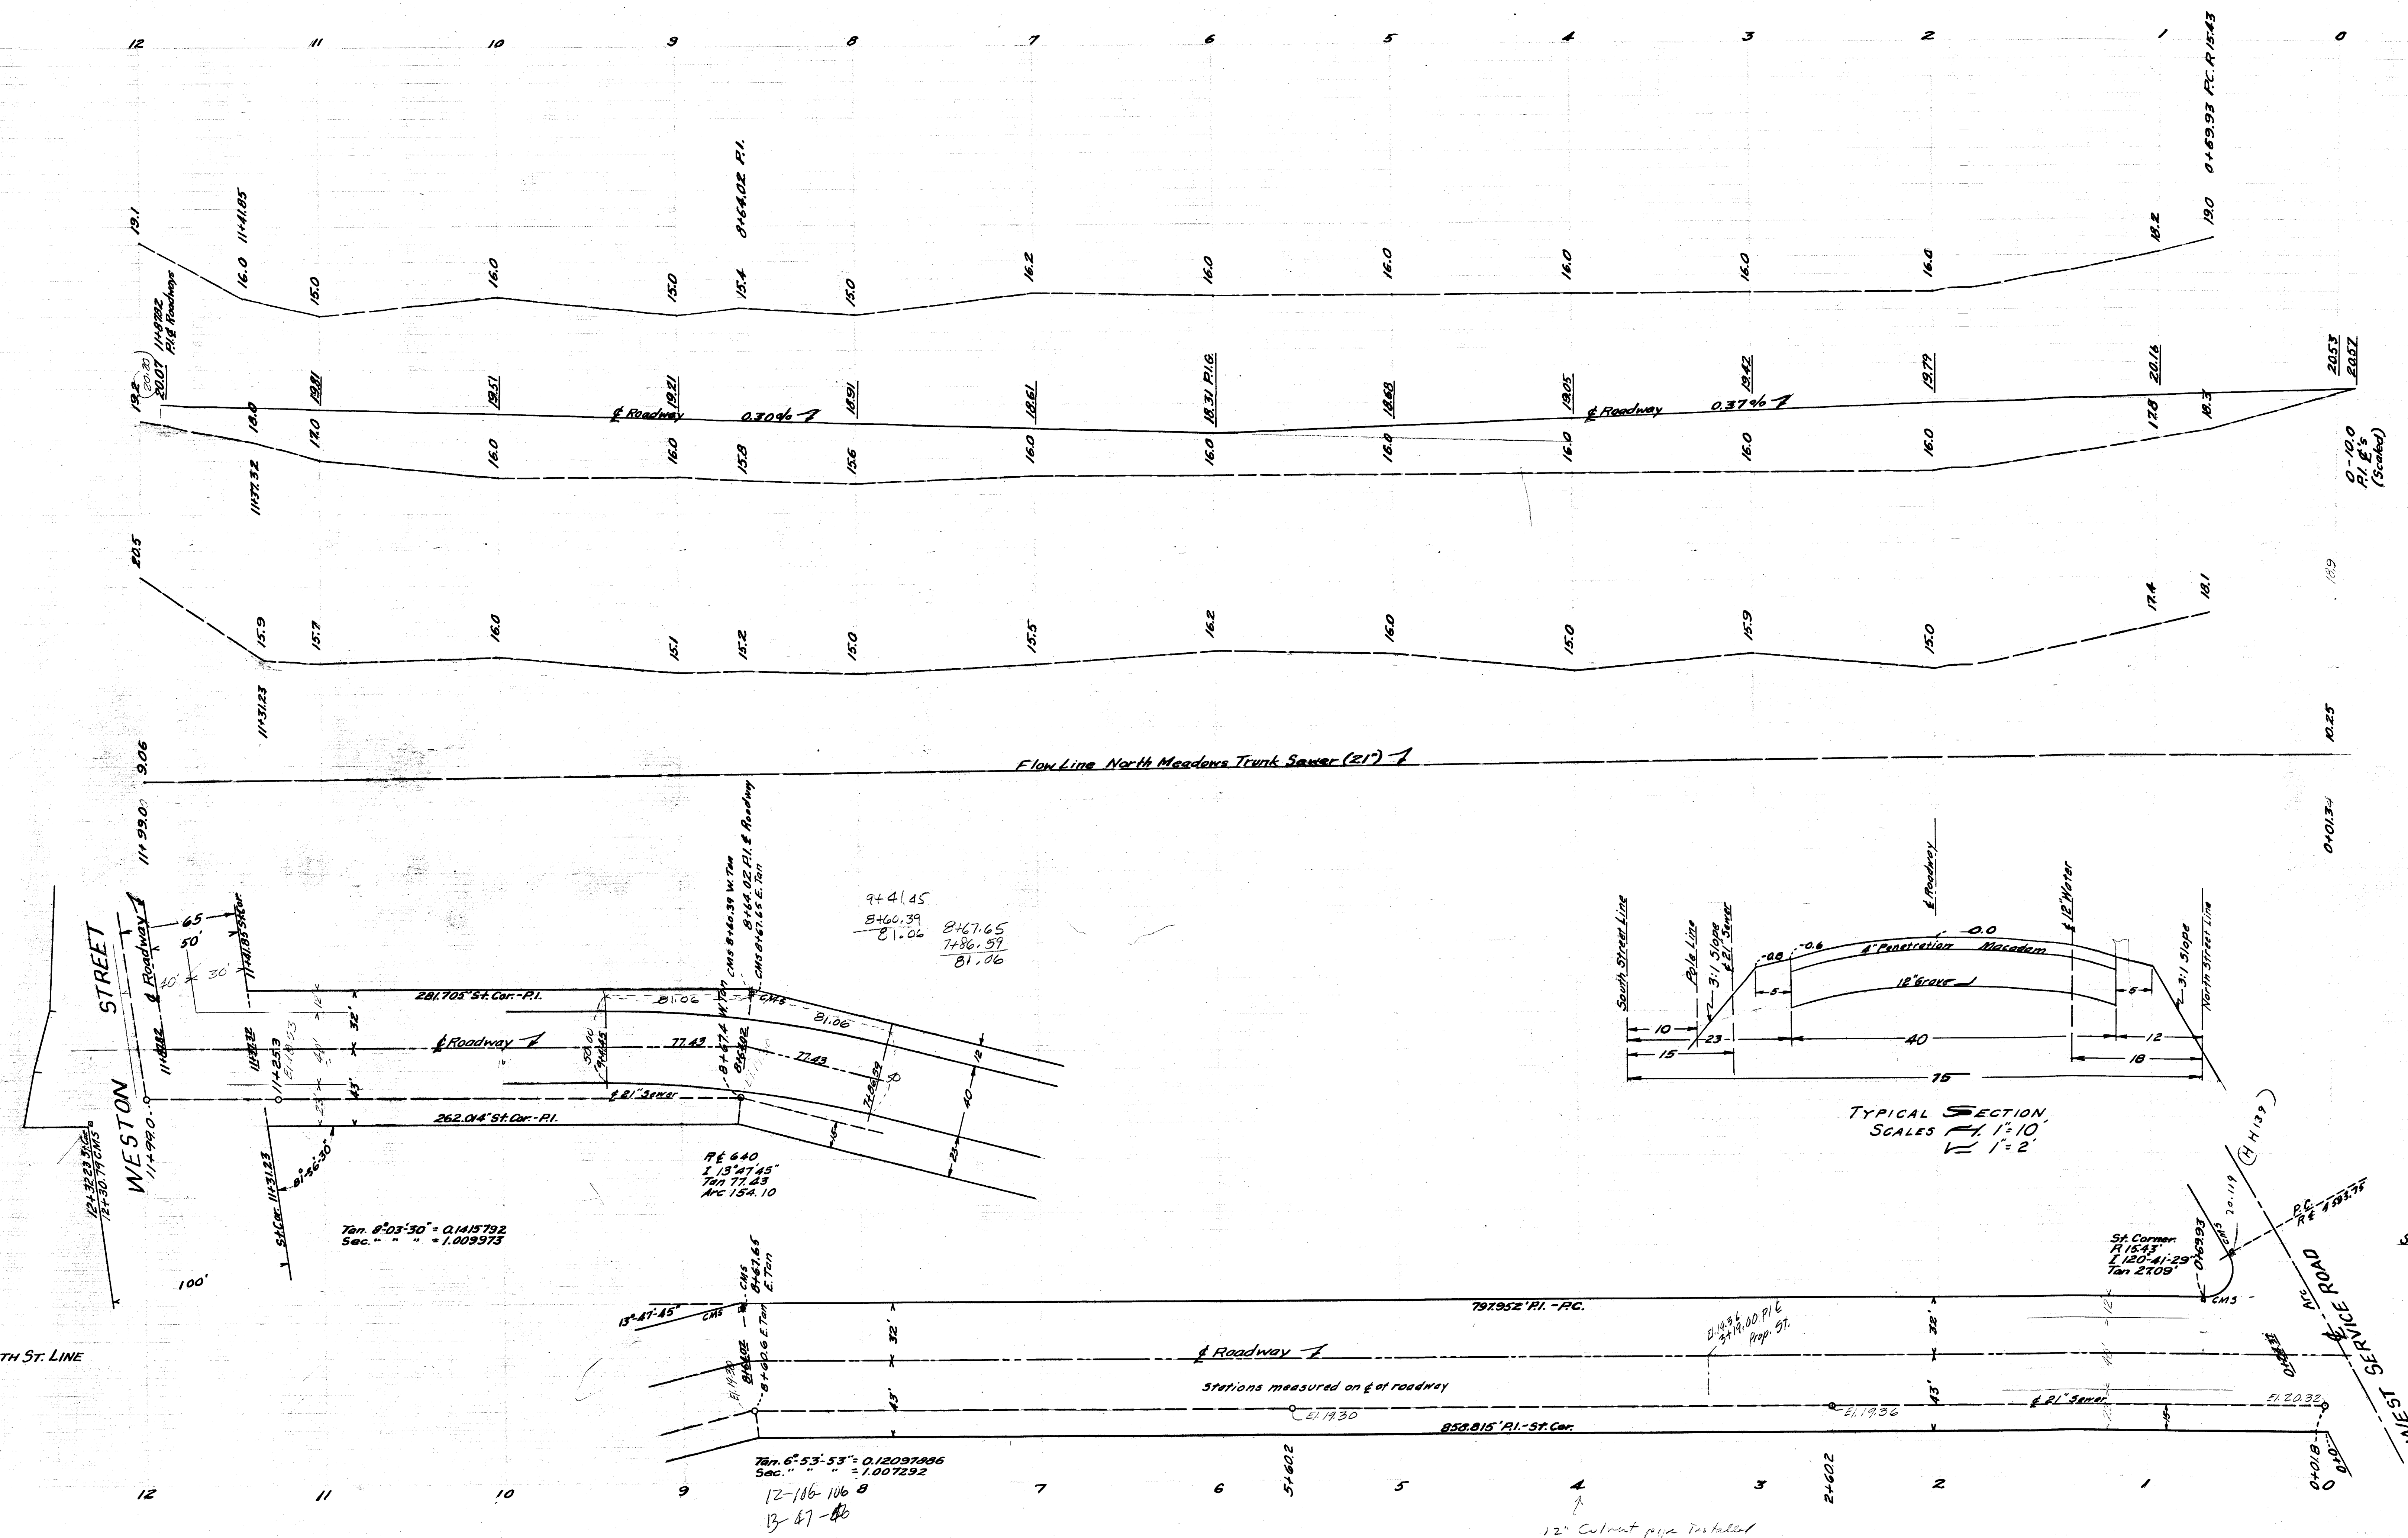

See Tracing 18/3
 56/120

CITY OF HARTFORD
 DEPARTMENT OF ENGINEERING
 09336 FSA