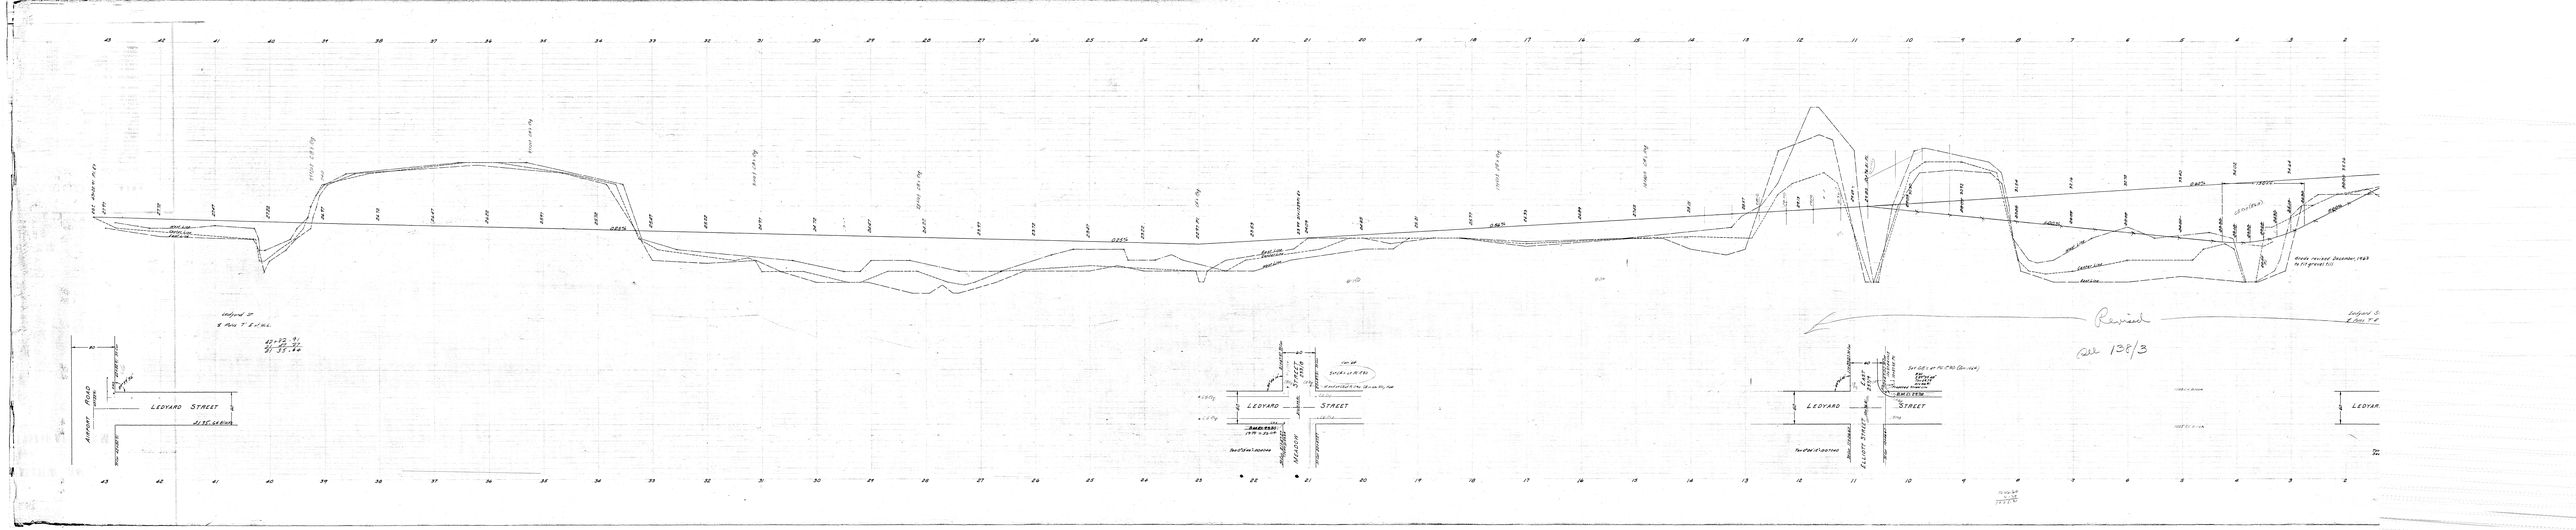
Revised
LEDYARD STREET
AIRPORT ROAD
LEDYARD
STREET
ELLIOTT STREET
MEADOW