


154

154

B.M. - N. end and top of steel wheel guard
northernmost garage door Market St.
side of Sears-Roebuck (N. side of door)
52.952

MARKET STREET

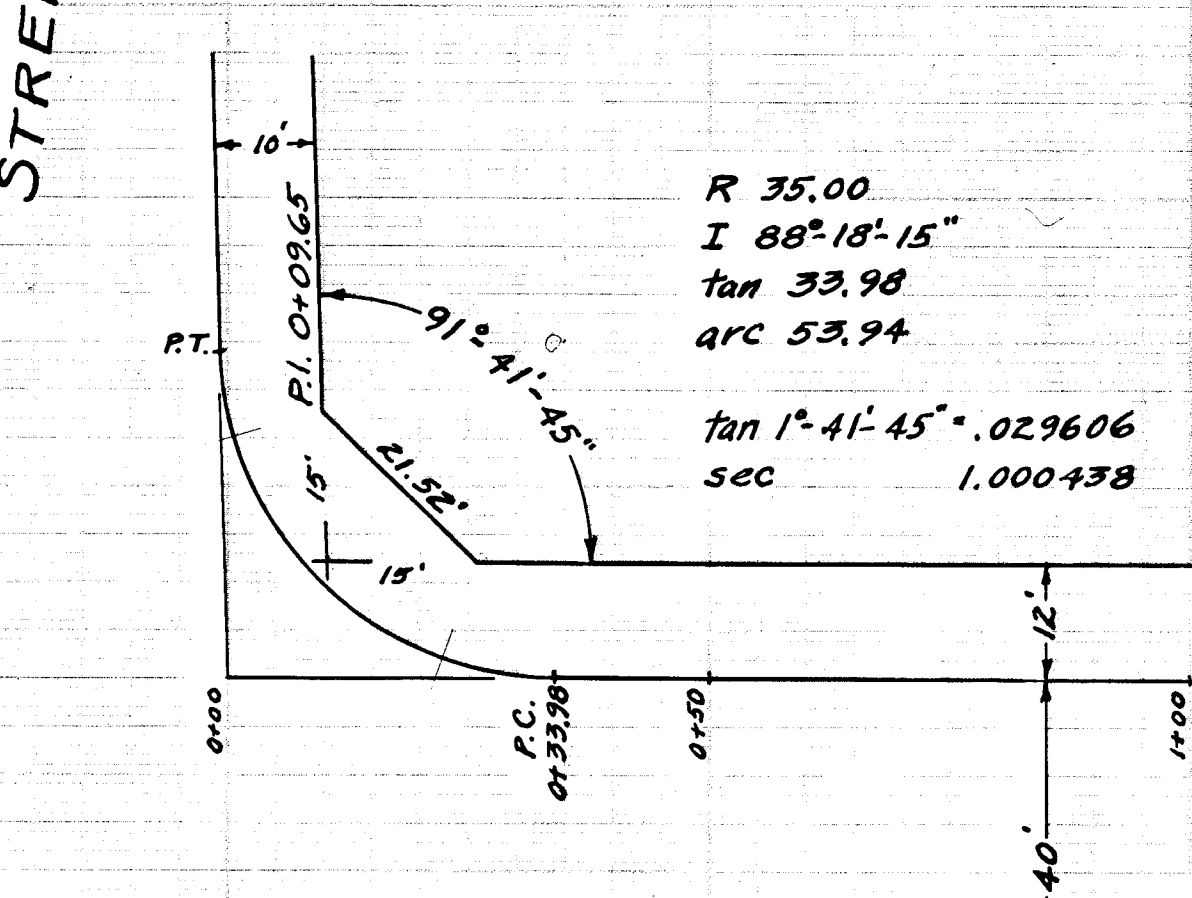

See Revised Plan
421-11-B




STATE STREET PROFILE

Scale Horiz. 1"=20'
Vert. 1"=2'

Daybook No. 09602A January 1960

* Amended 9-28-61 to conform to data
on profile 421-11-B
A Revised 9-12-62 - C.B. locations changed

CITY OF HARTFORD
DEPARTMENT OF ENGINEERING

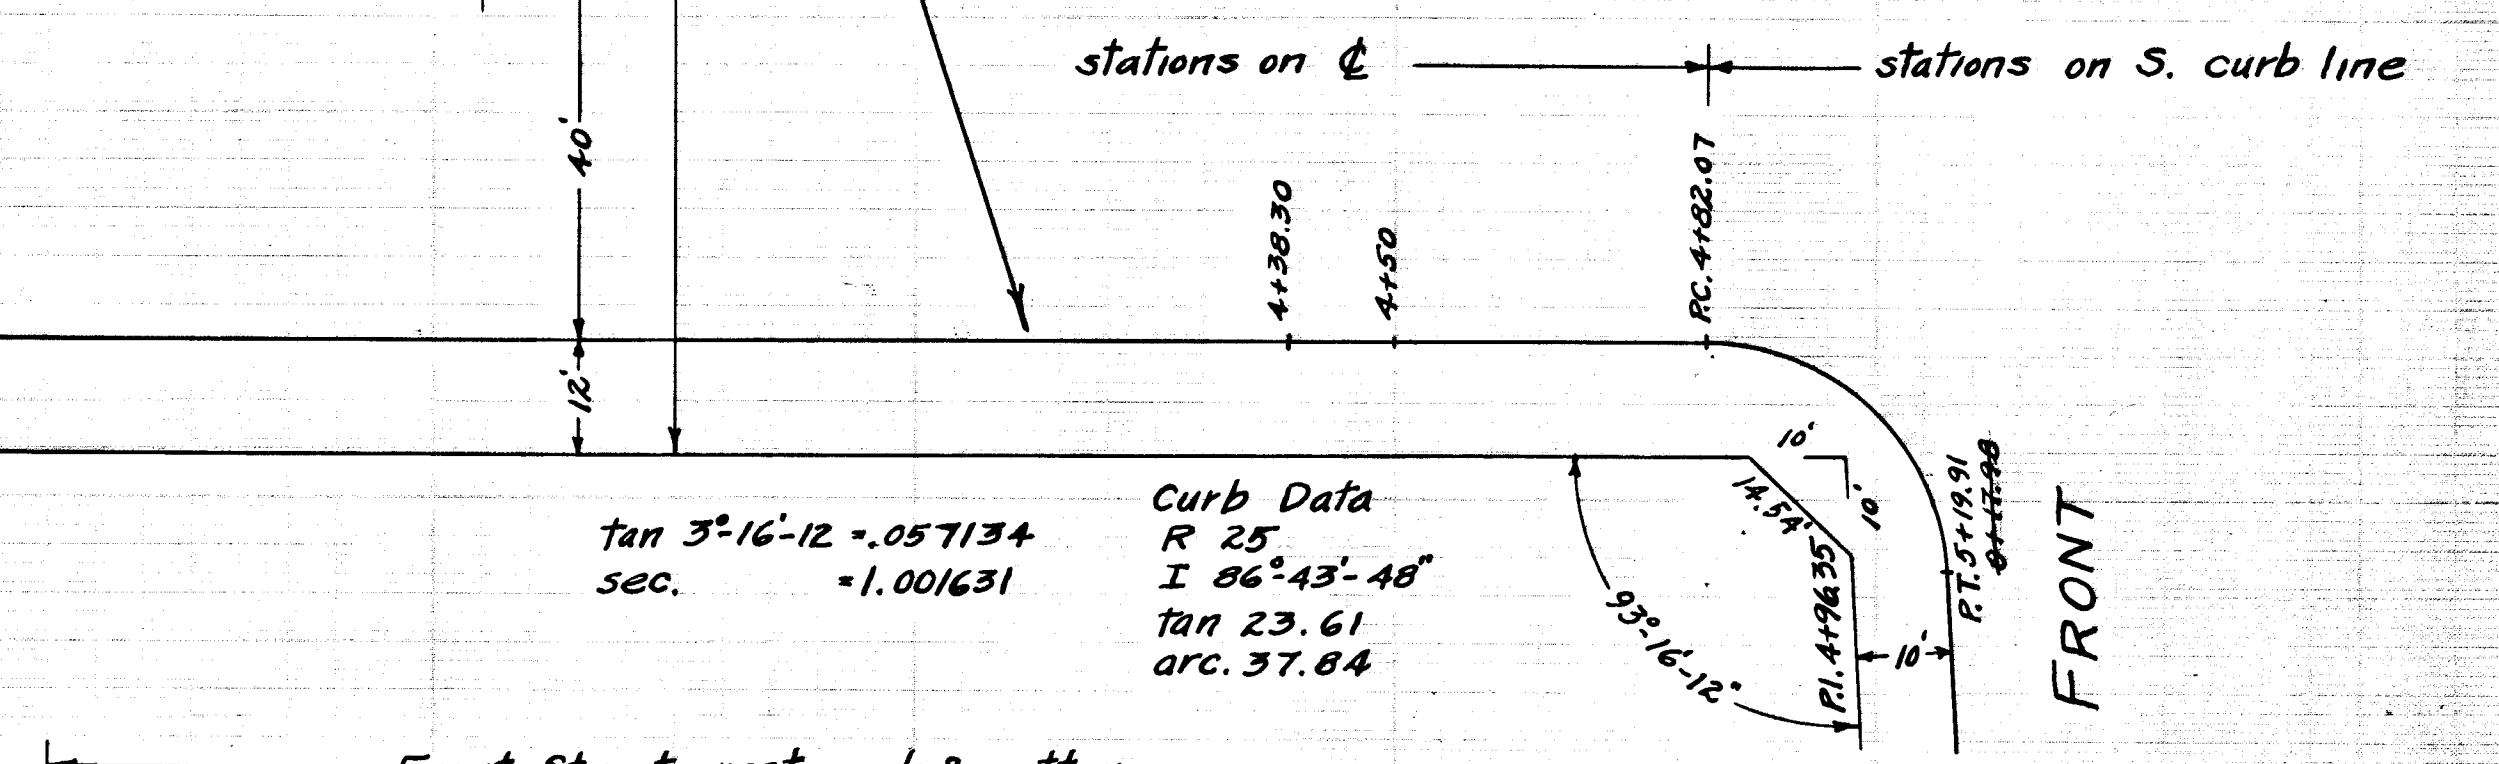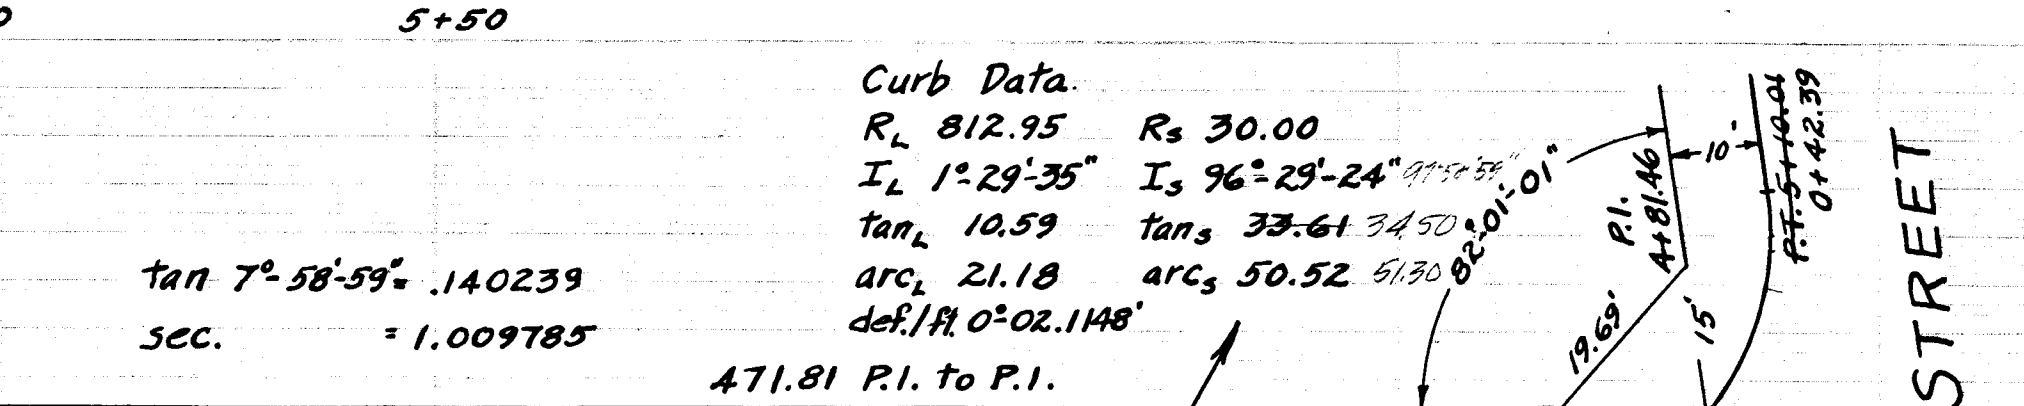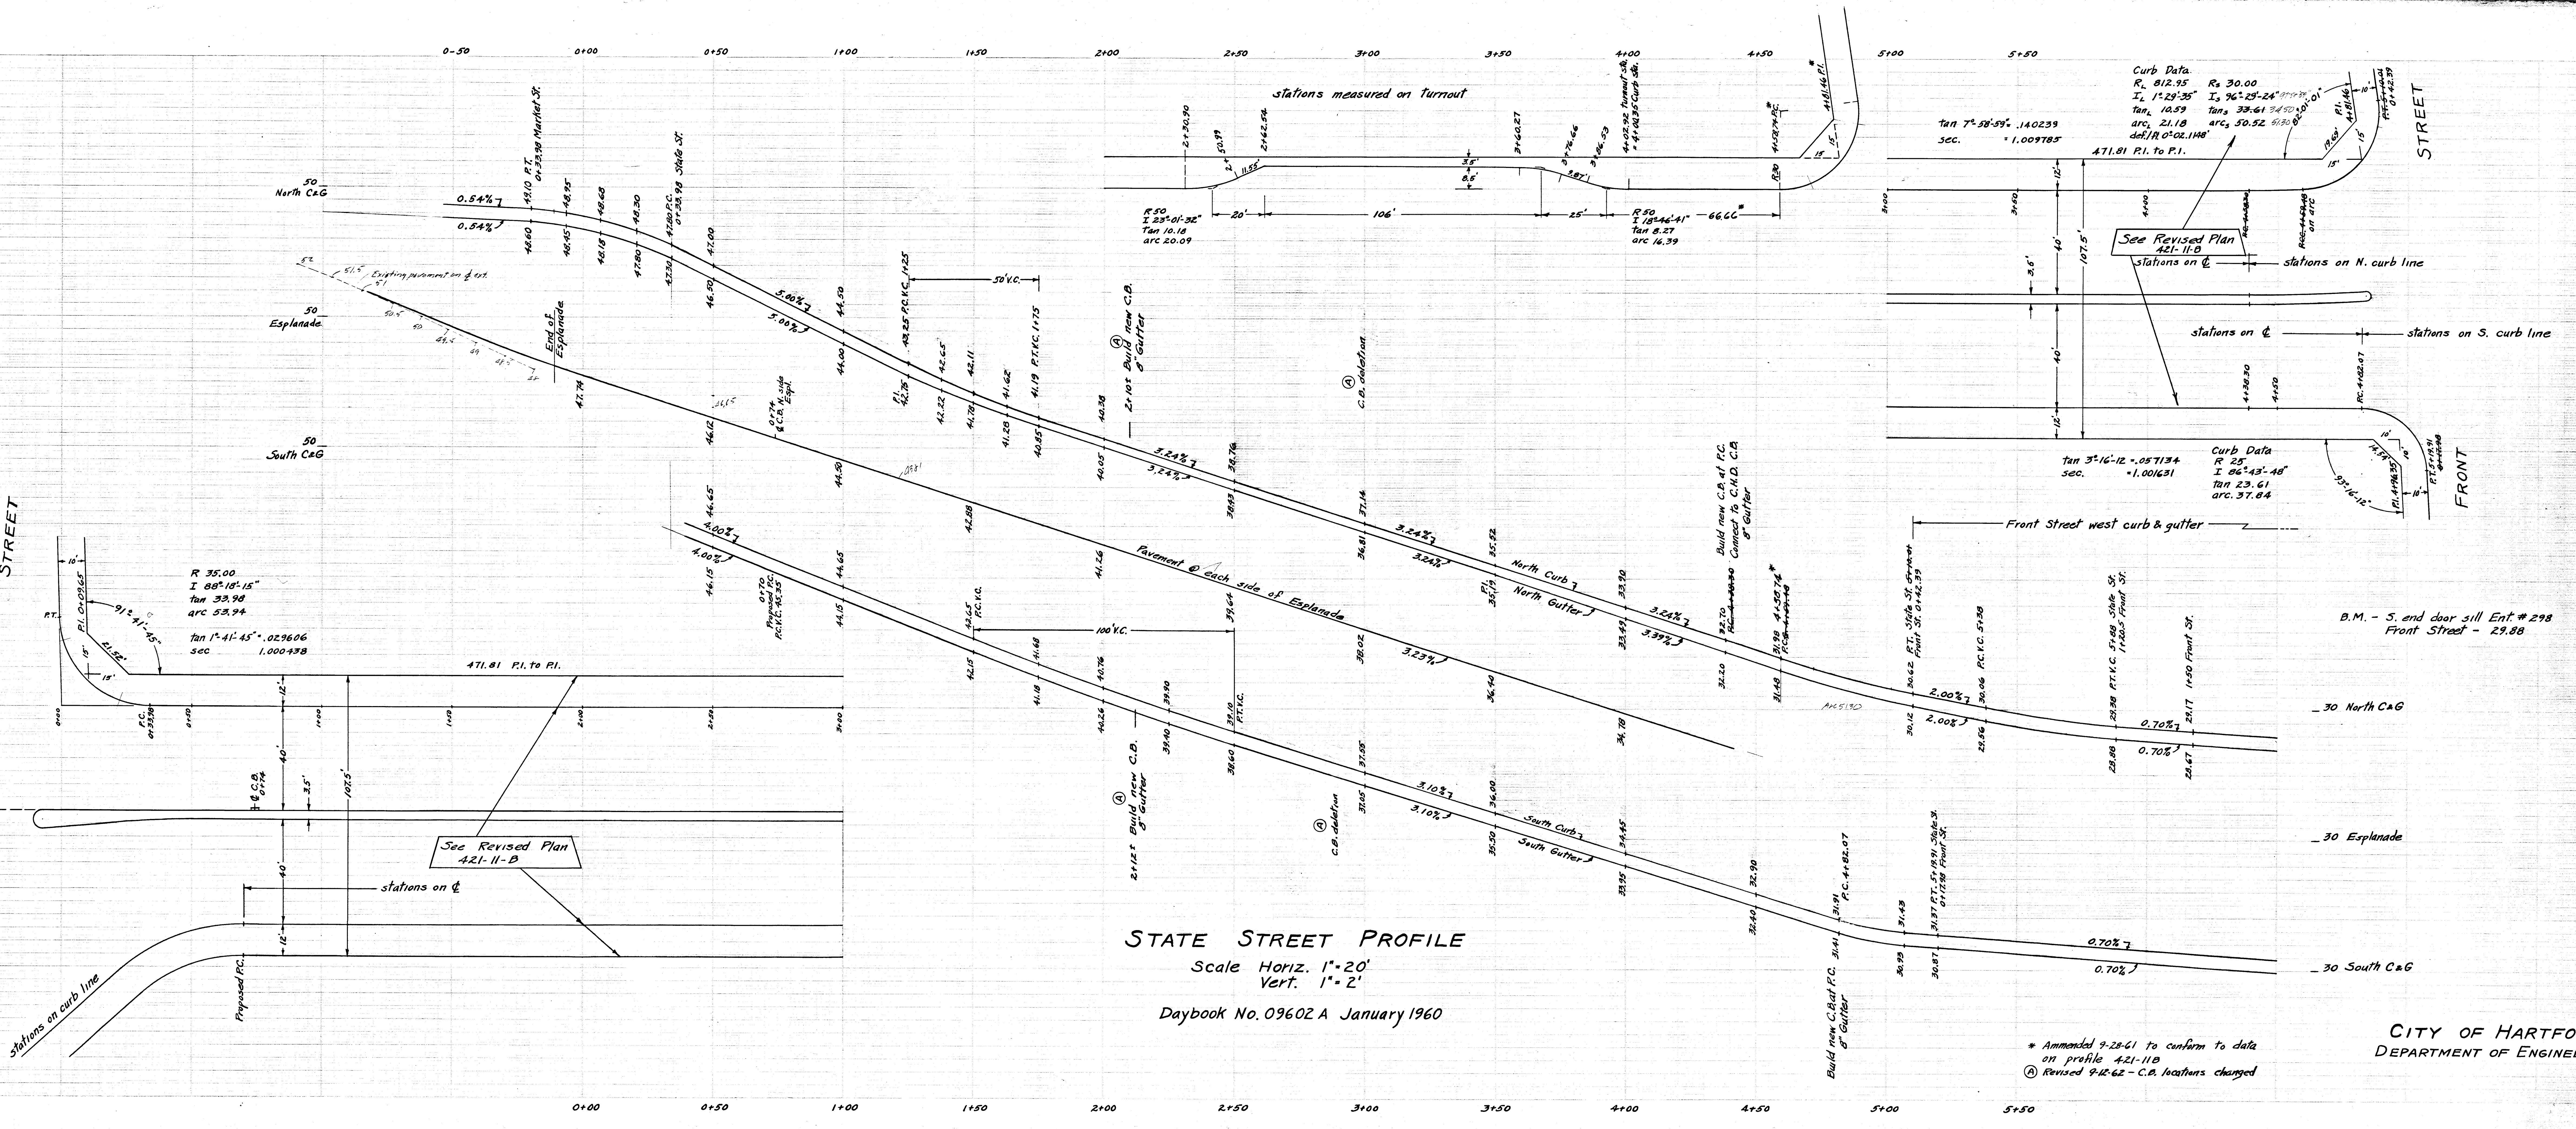

B.M. - S. end door sill Ent # 298
Front Street - 29.88

- 30 North C&G

- 30 Esplanade

- 30 South C&G