




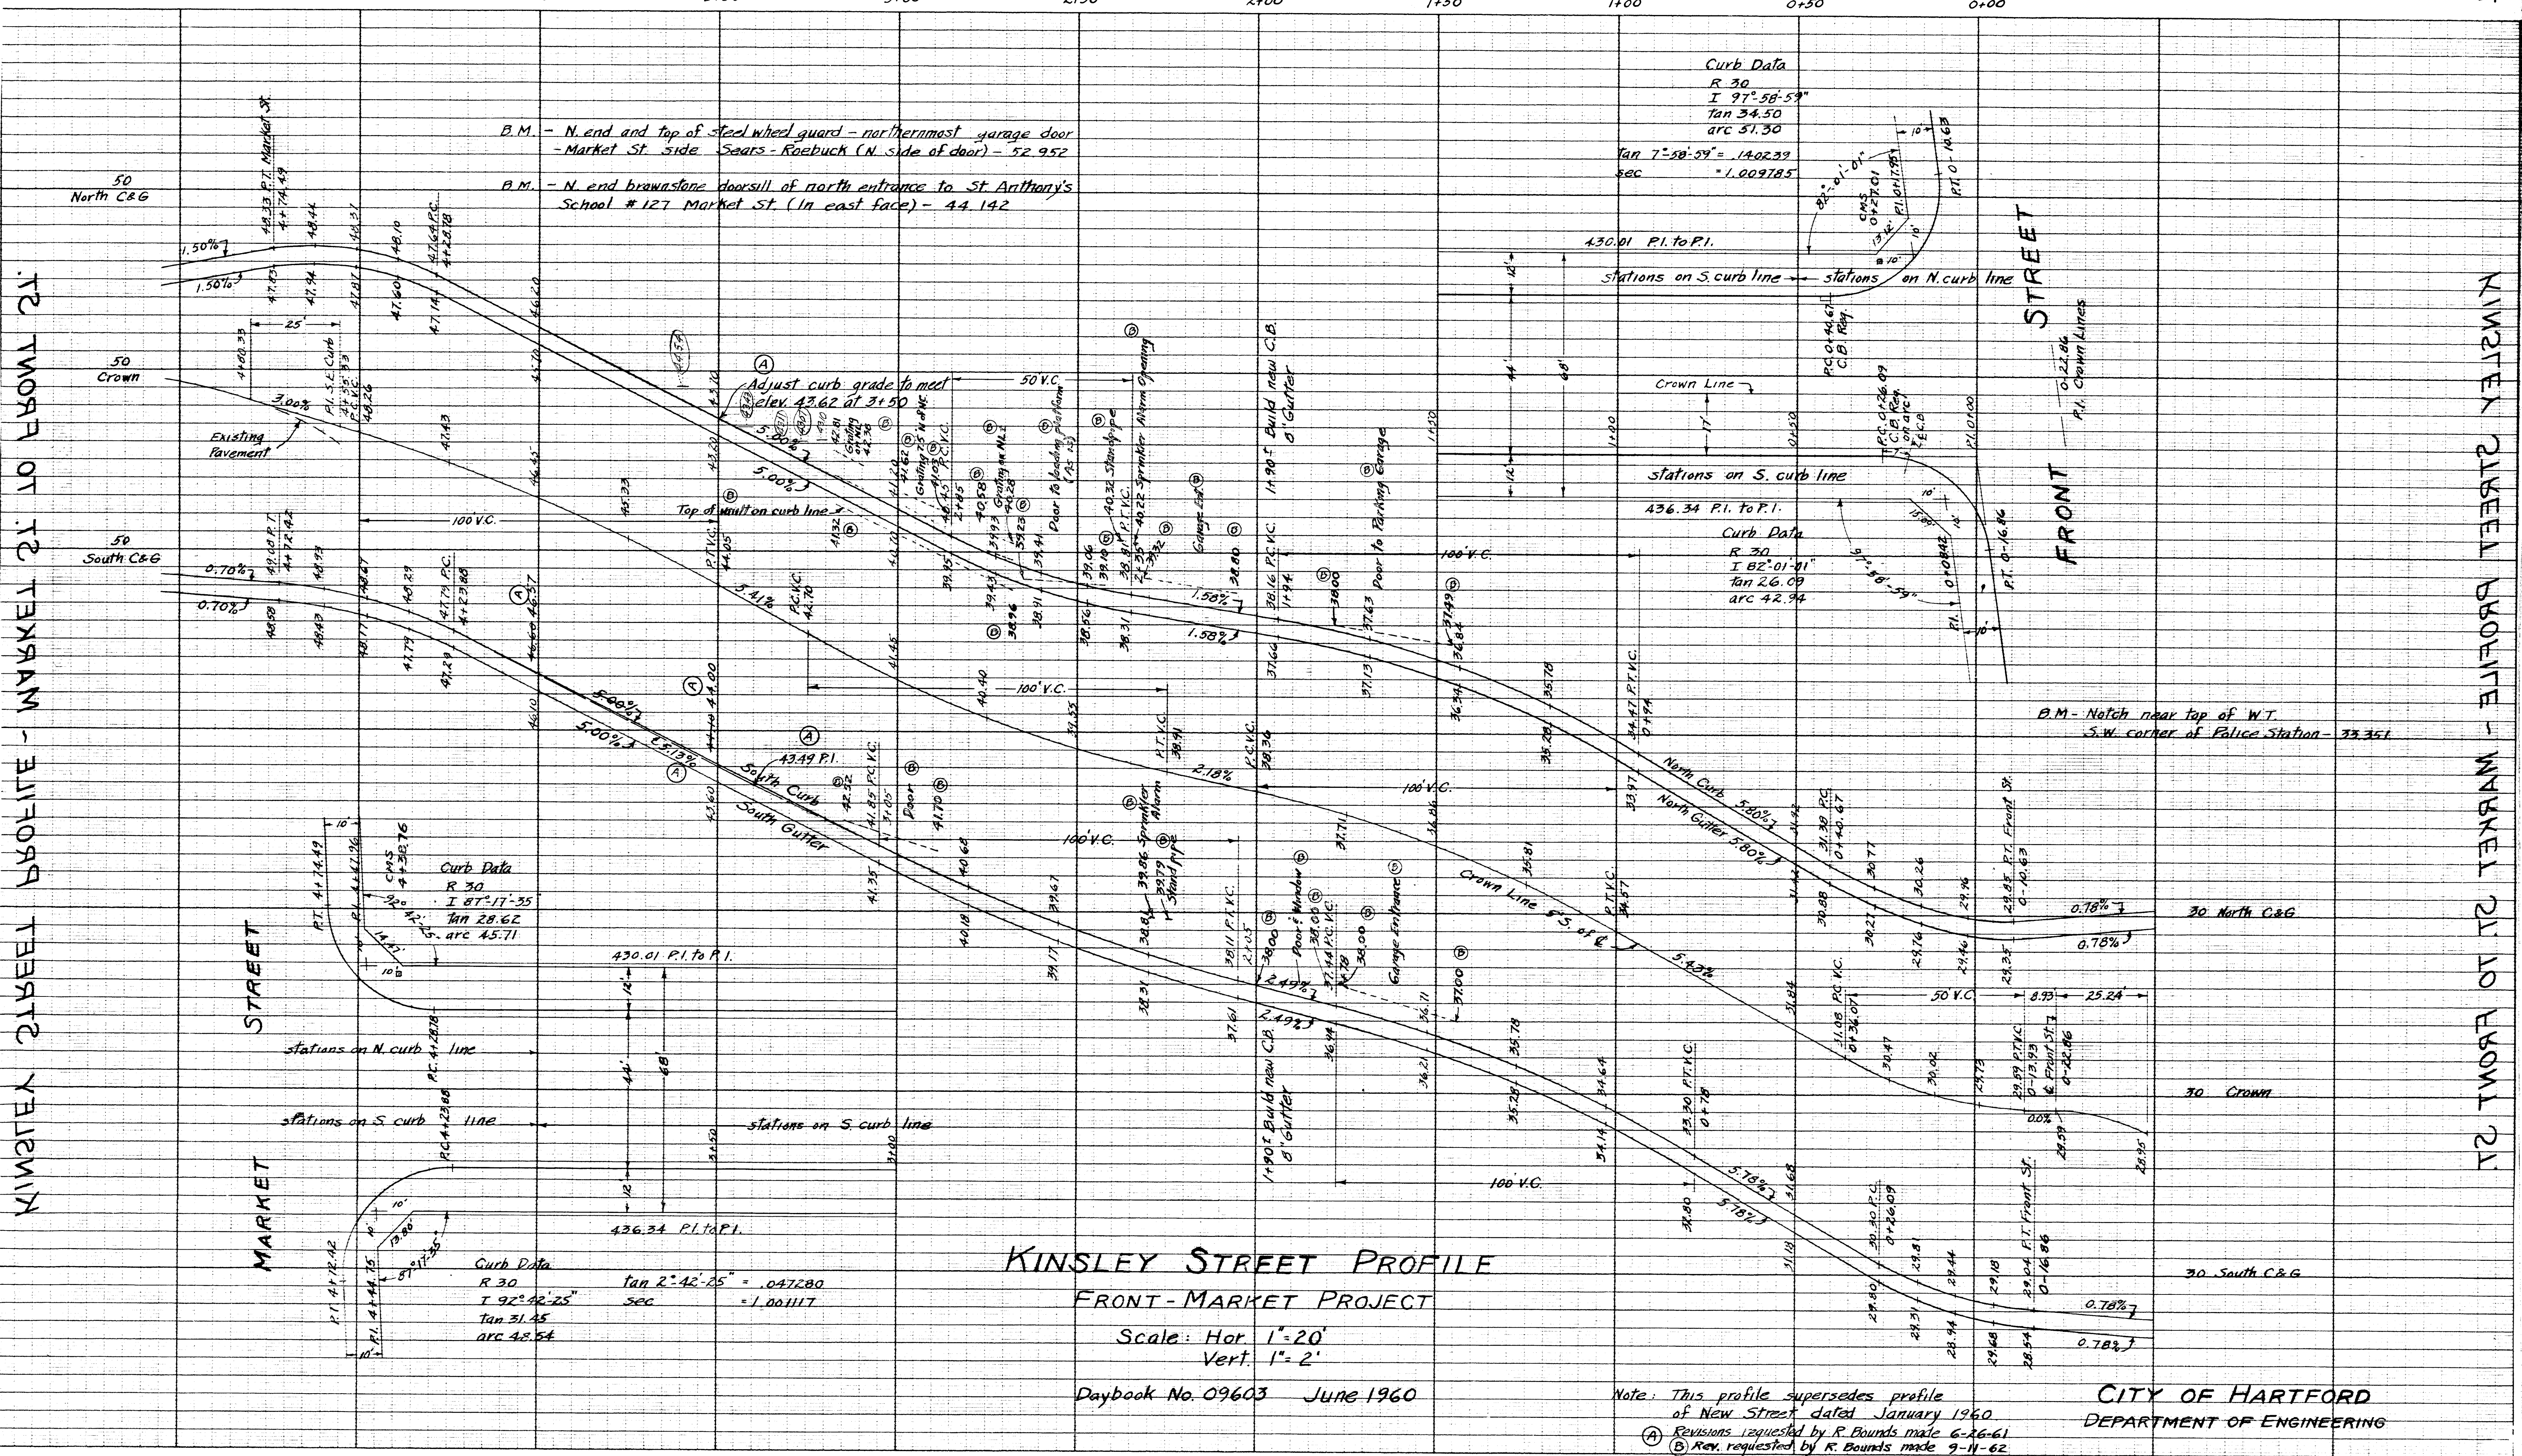

KINSLEY STREET PROFILE

FRONT - MARKET PROJECT

Scale: Hor 1"=20'
Vert 1"=2'

Daybook No. 09603 June 1960

Note: This profile supersedes profile of New Street dated January 1960
(A) Revisions requested by R. Bounds made 6-26-61
(B) Rev. requested by R. Bounds made 9-11-62

CITY OF HARTFORD
DEPARTMENT OF ENGINEERING