

Existing Contours

5/23

NEW BRITAIN AVENUE

NEW BRITAIN AVENUE TO BROADVIEW TERRACE
20' STREET WIDENING

5/23

Curb Corner
R25
152°40'00"
Tan 12.37
Arc 22.98


Street line data on Tracing 242/57

Curb Line
R129.15
141°35'30"
Tan 49.05
Arc 93.75
Det/H: 0°19.3093'

STONE STREET

NO. 36' Roadway
by "Topics"
June 1973

Crown Line: Former East Curb Line

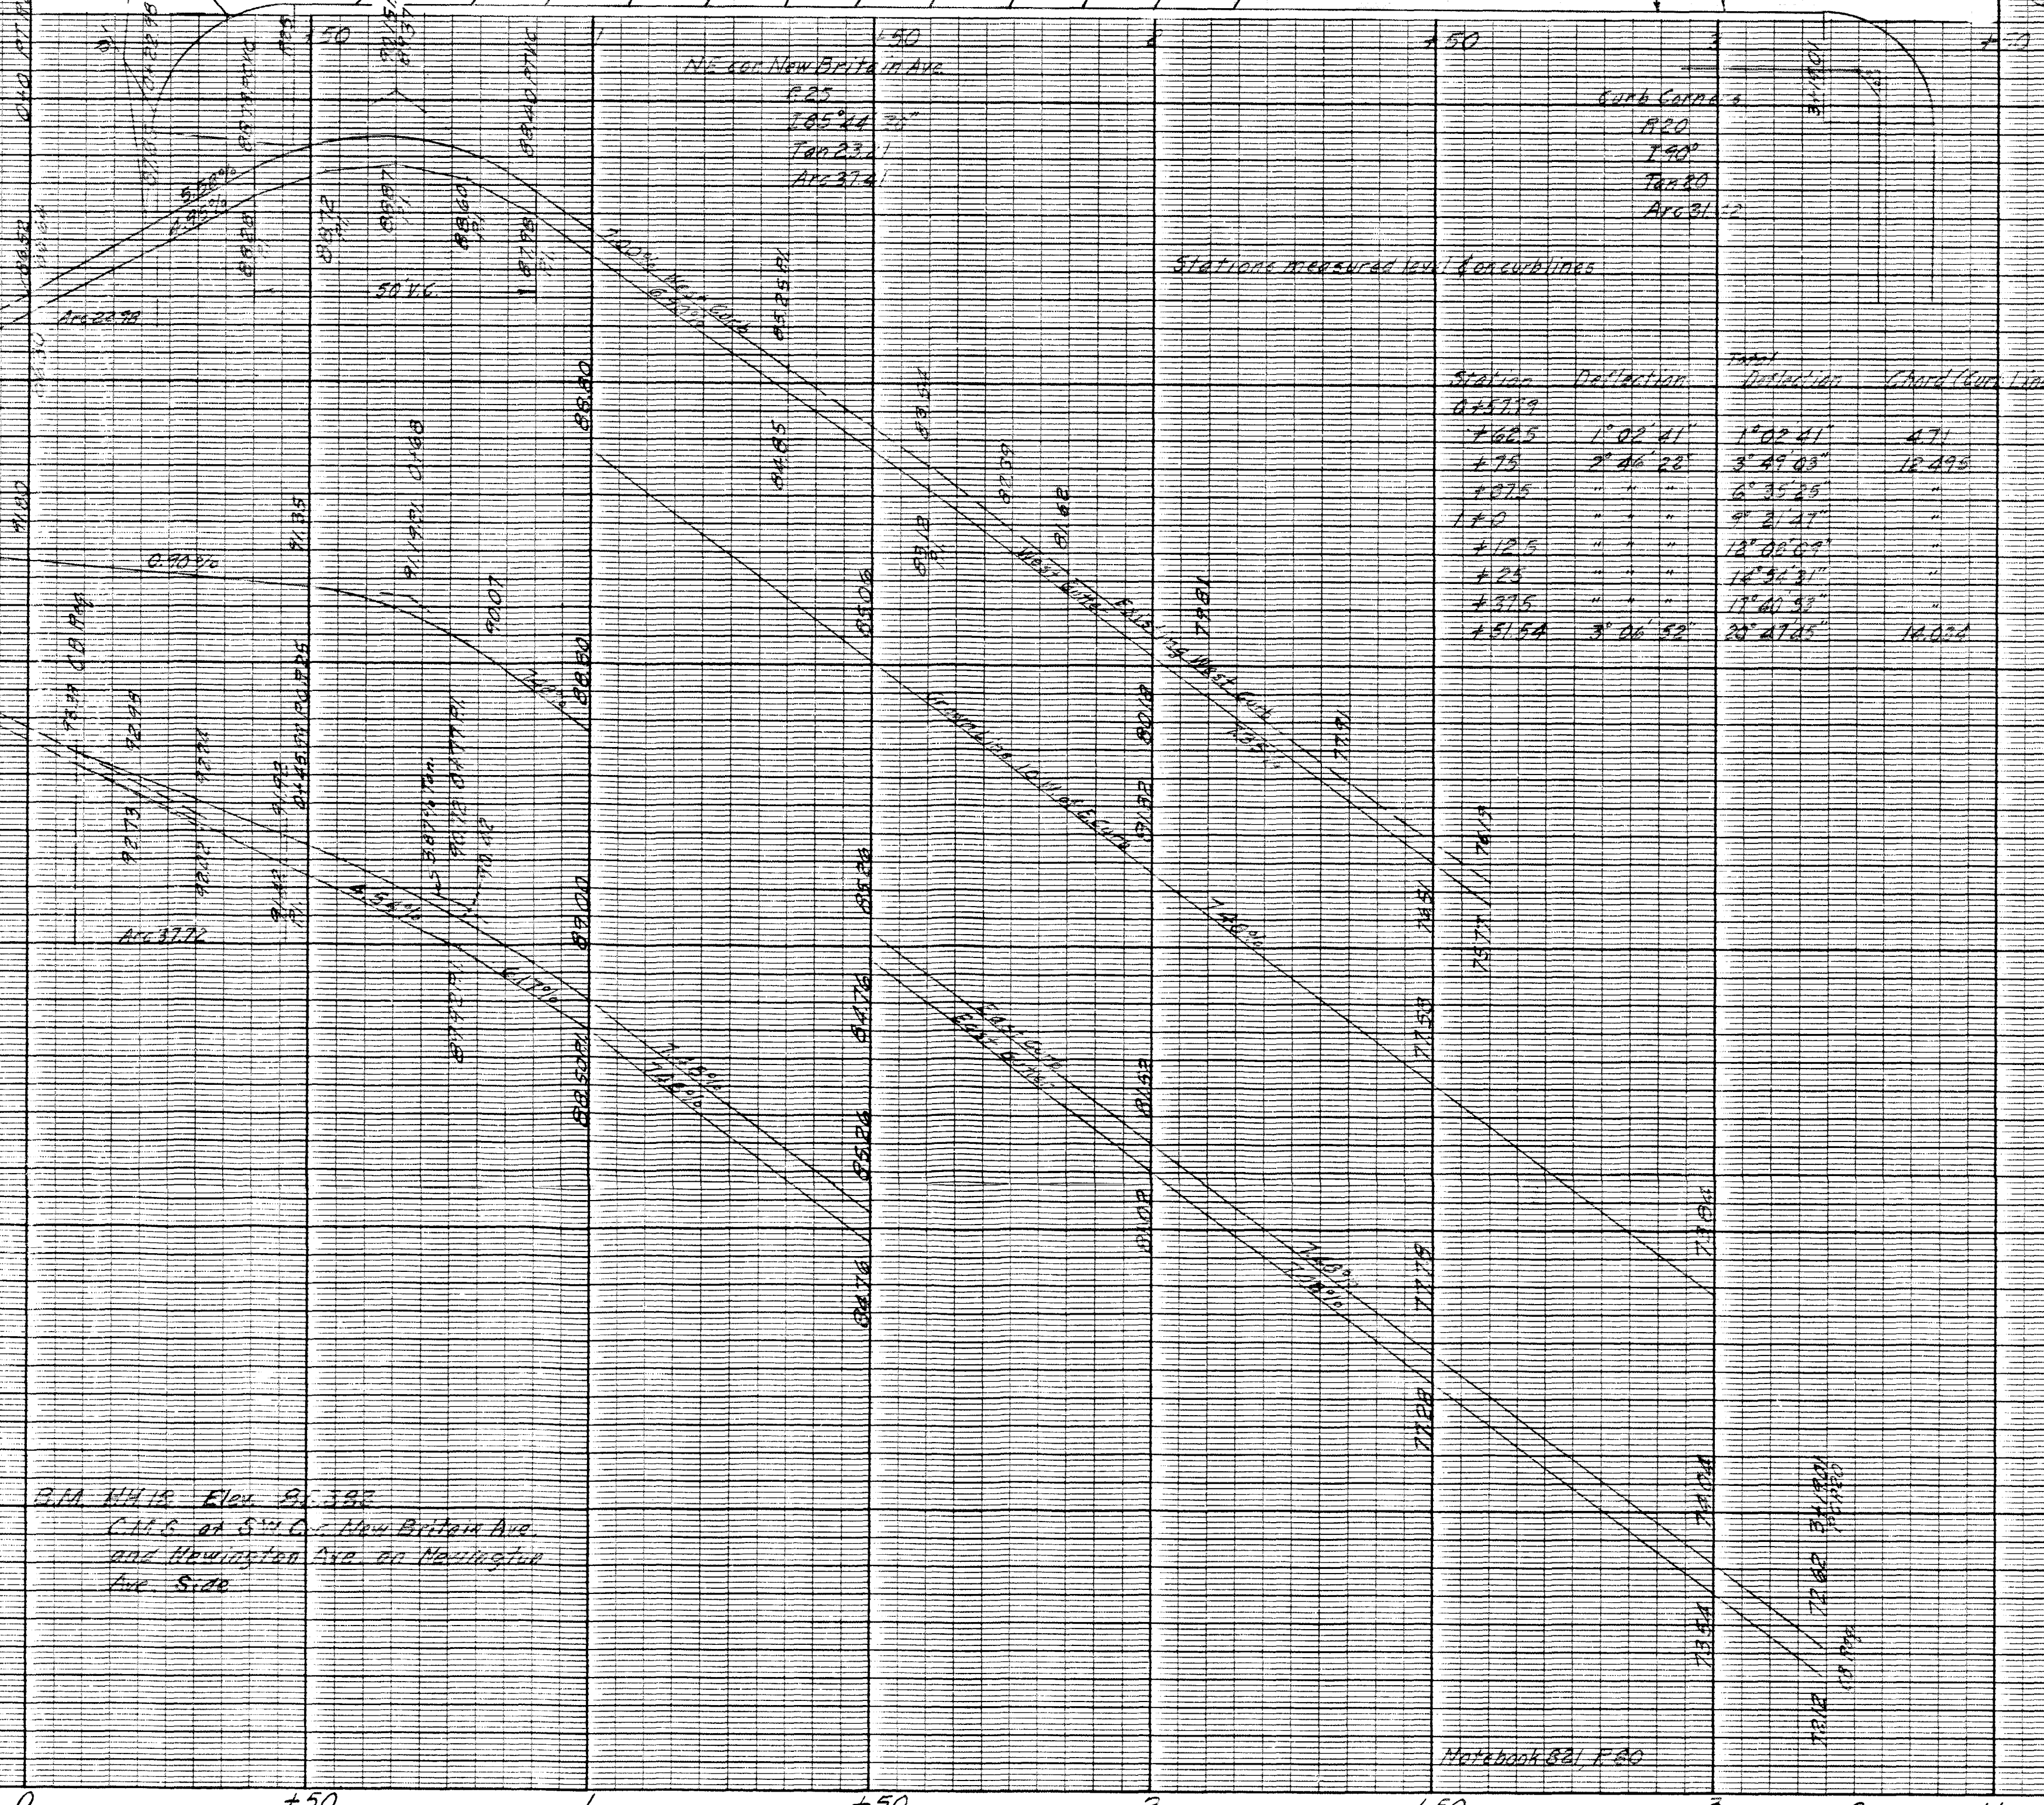

B.M. 141.12 Elev. 91.382
C.M.S. at S.W. Cor. New Britain Ave.
and Huntington Ave. on Huntington
Ave. S. 20'

Metabook 881, F. 80

CITY OF HARTFORD

DEPARTMENT OF ENGINEERING

SCALE H. 1"=20' OCTOBER 1969

DAYBOOK No. 09976

NEW BRITAIN AVENUE TO BROADVIEW TERRACE
20' STREET WIDENING

5/23