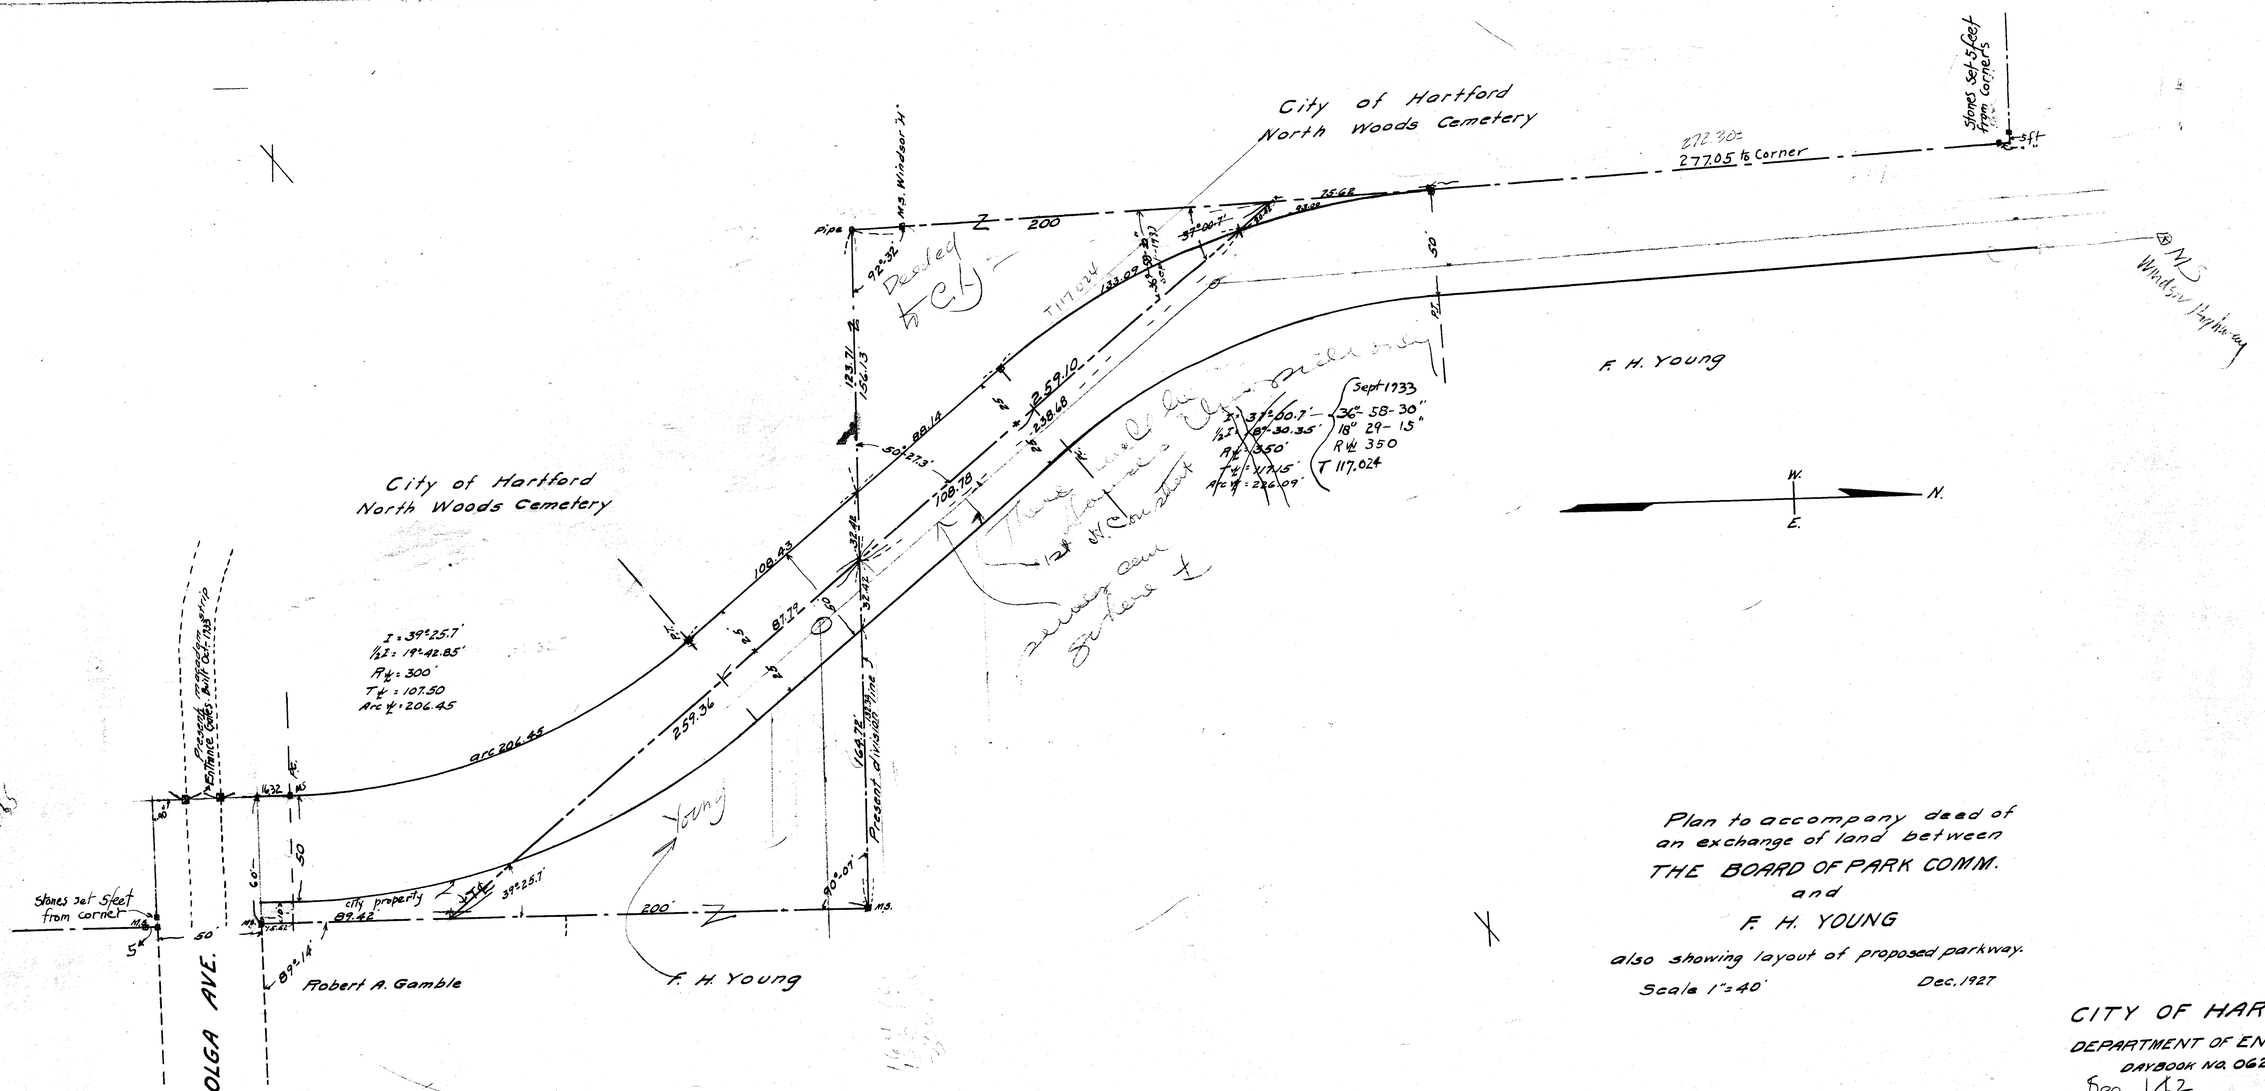

Plan to accompany deed of an exchange of land between
THE BOARD OF PARK COMM.
and
F. H. YOUNG
also showing layout of proposed parkway.
Scale 1" = 40'
Dec. 1927

CITY OF HARTFORD
DEPARTMENT OF ENGINEERING
DAYBOOK No. 06291
Sec 142
10