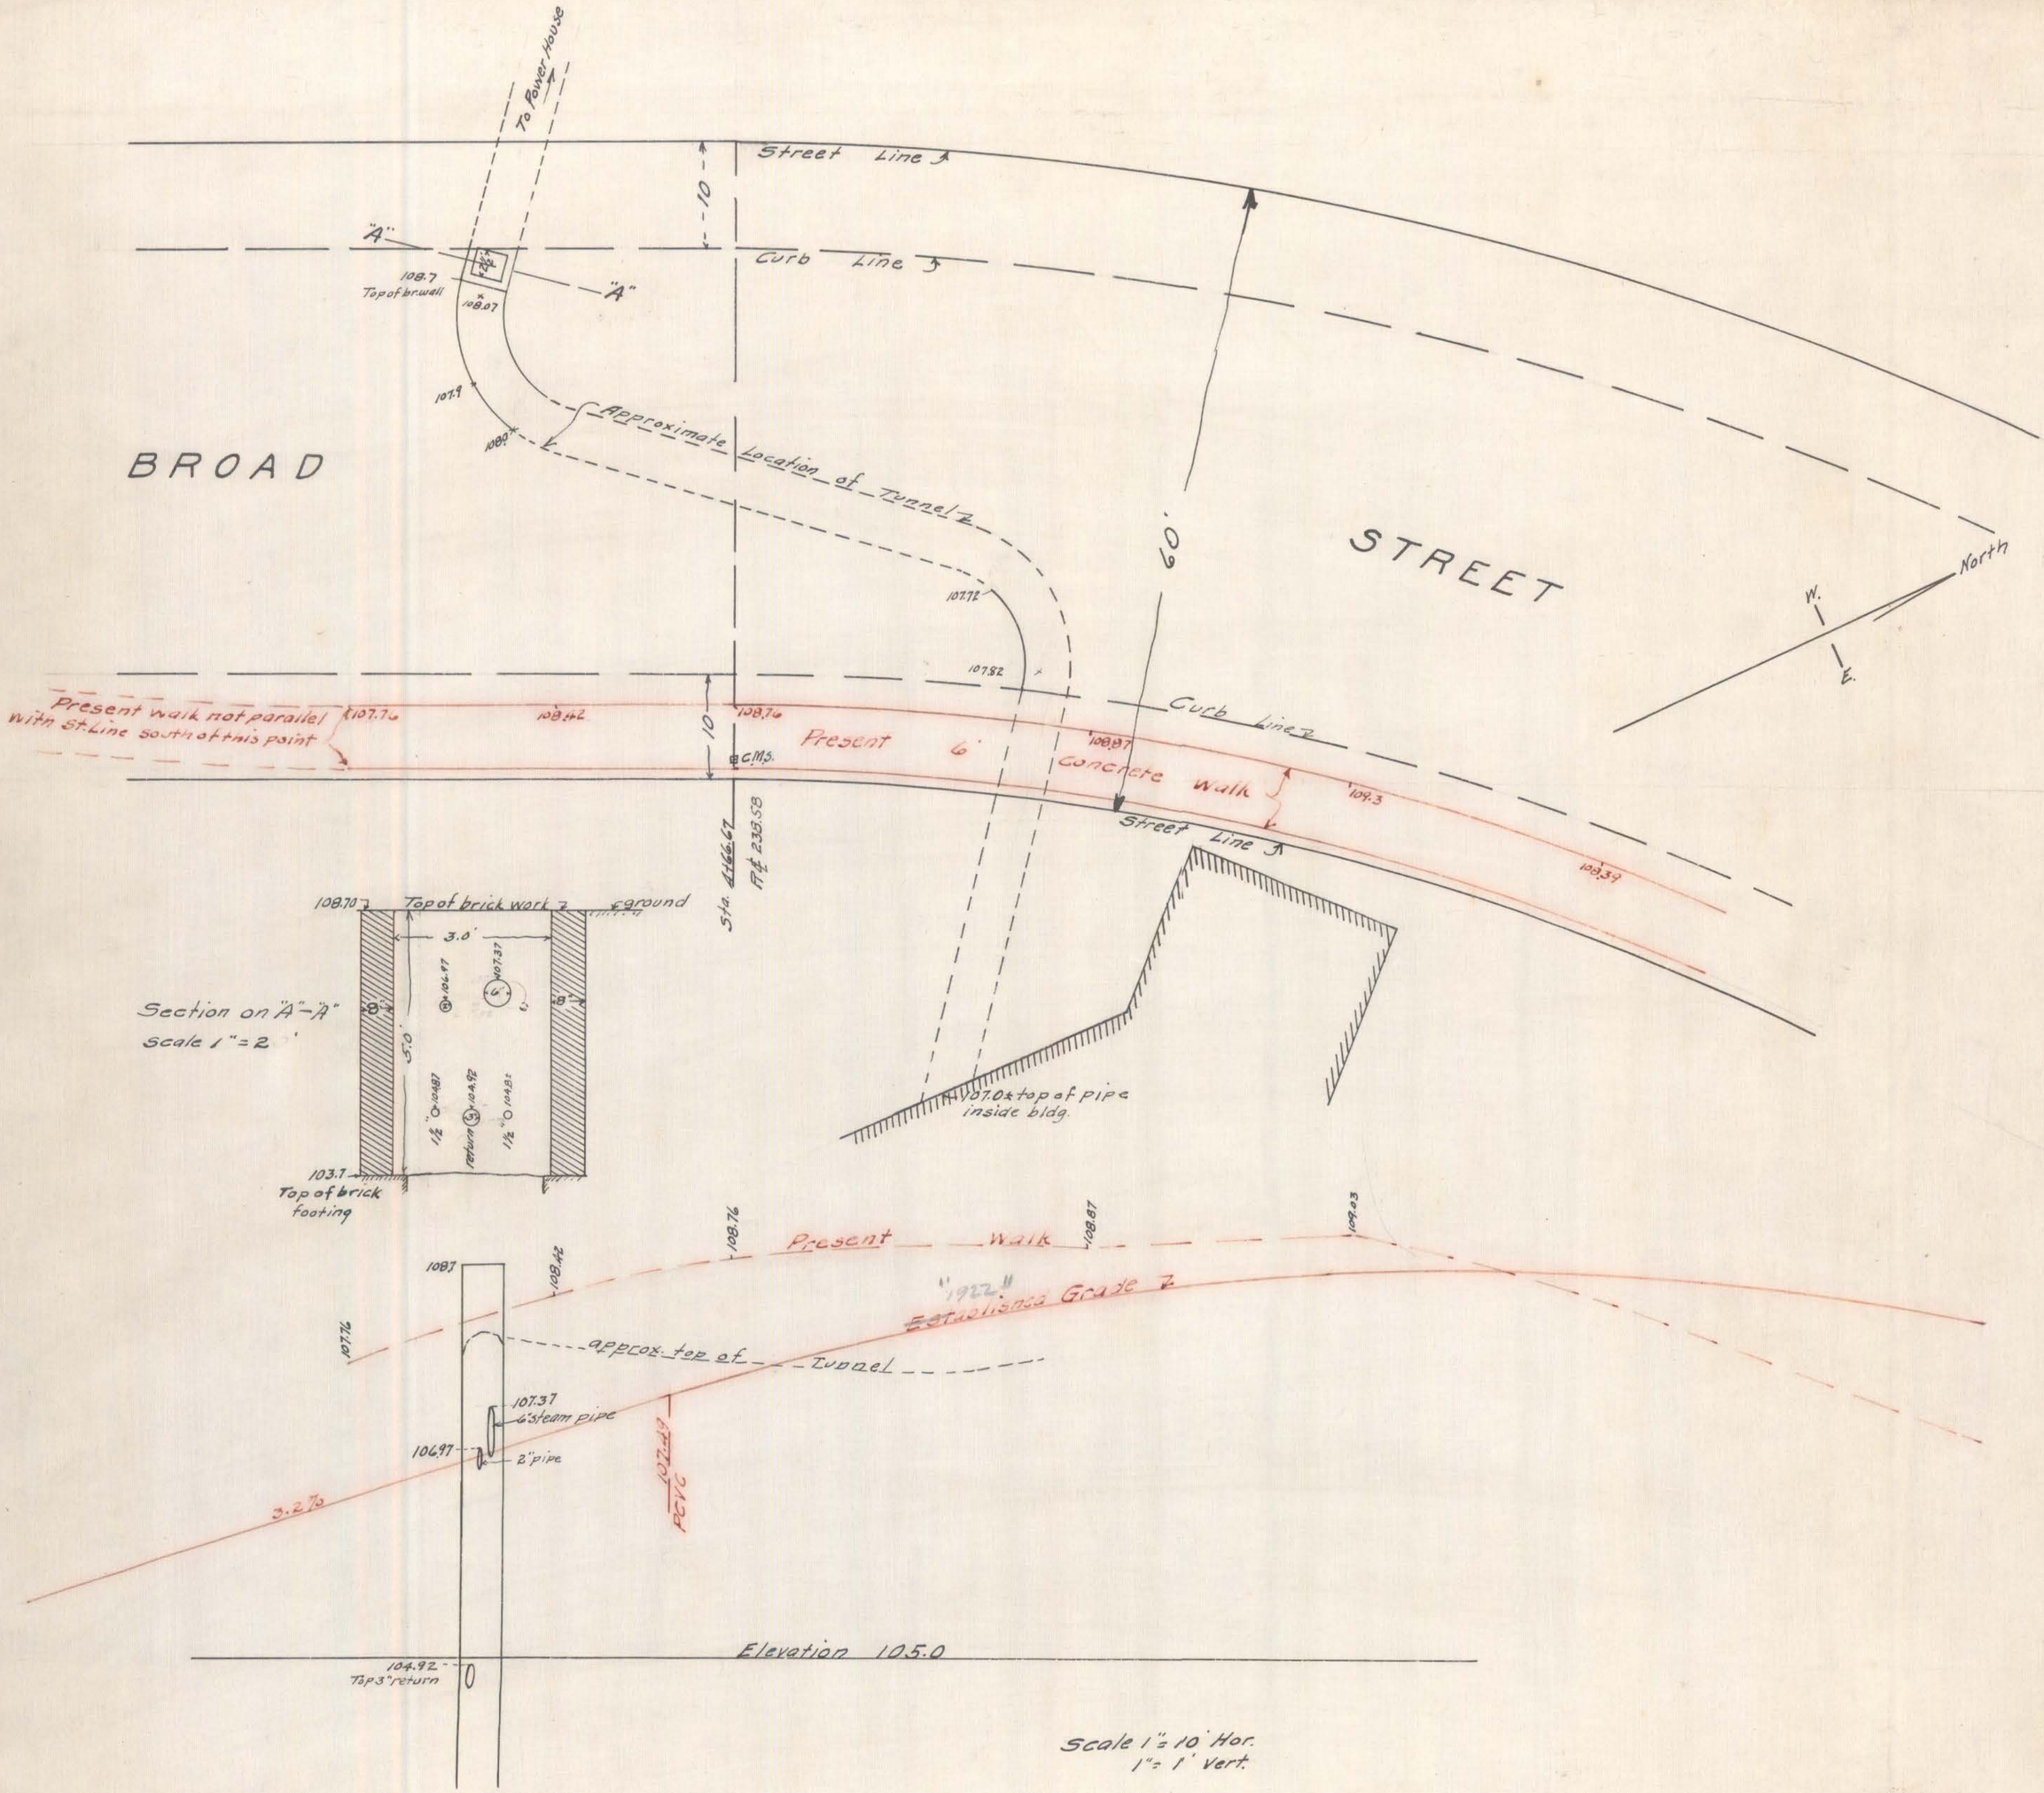

Daybook No. 06808