


Grades given to Post Office Engineer May 1930

B.M. west end granite door sill "433 Church st "Gordon Bldg" elev. 44.855
 B.M. extreme north end north door sill "39.41 Hoadley Place elev. 56.58
 B.M. N.W. cor. Bond Annex, belt course 4.6 above ground, High st. elev. 63.99
 B.M. east end east window sill Foot Guard armory, Foot Guard place. elev. 63.175
 Note book 553. Tracing $\frac{204}{3}$.

Scale 1" = 40'

C. Note July 1931- Proposed Elevations of curb and walk- in Red.
 (used by Malmfeldt and Co. Architects).

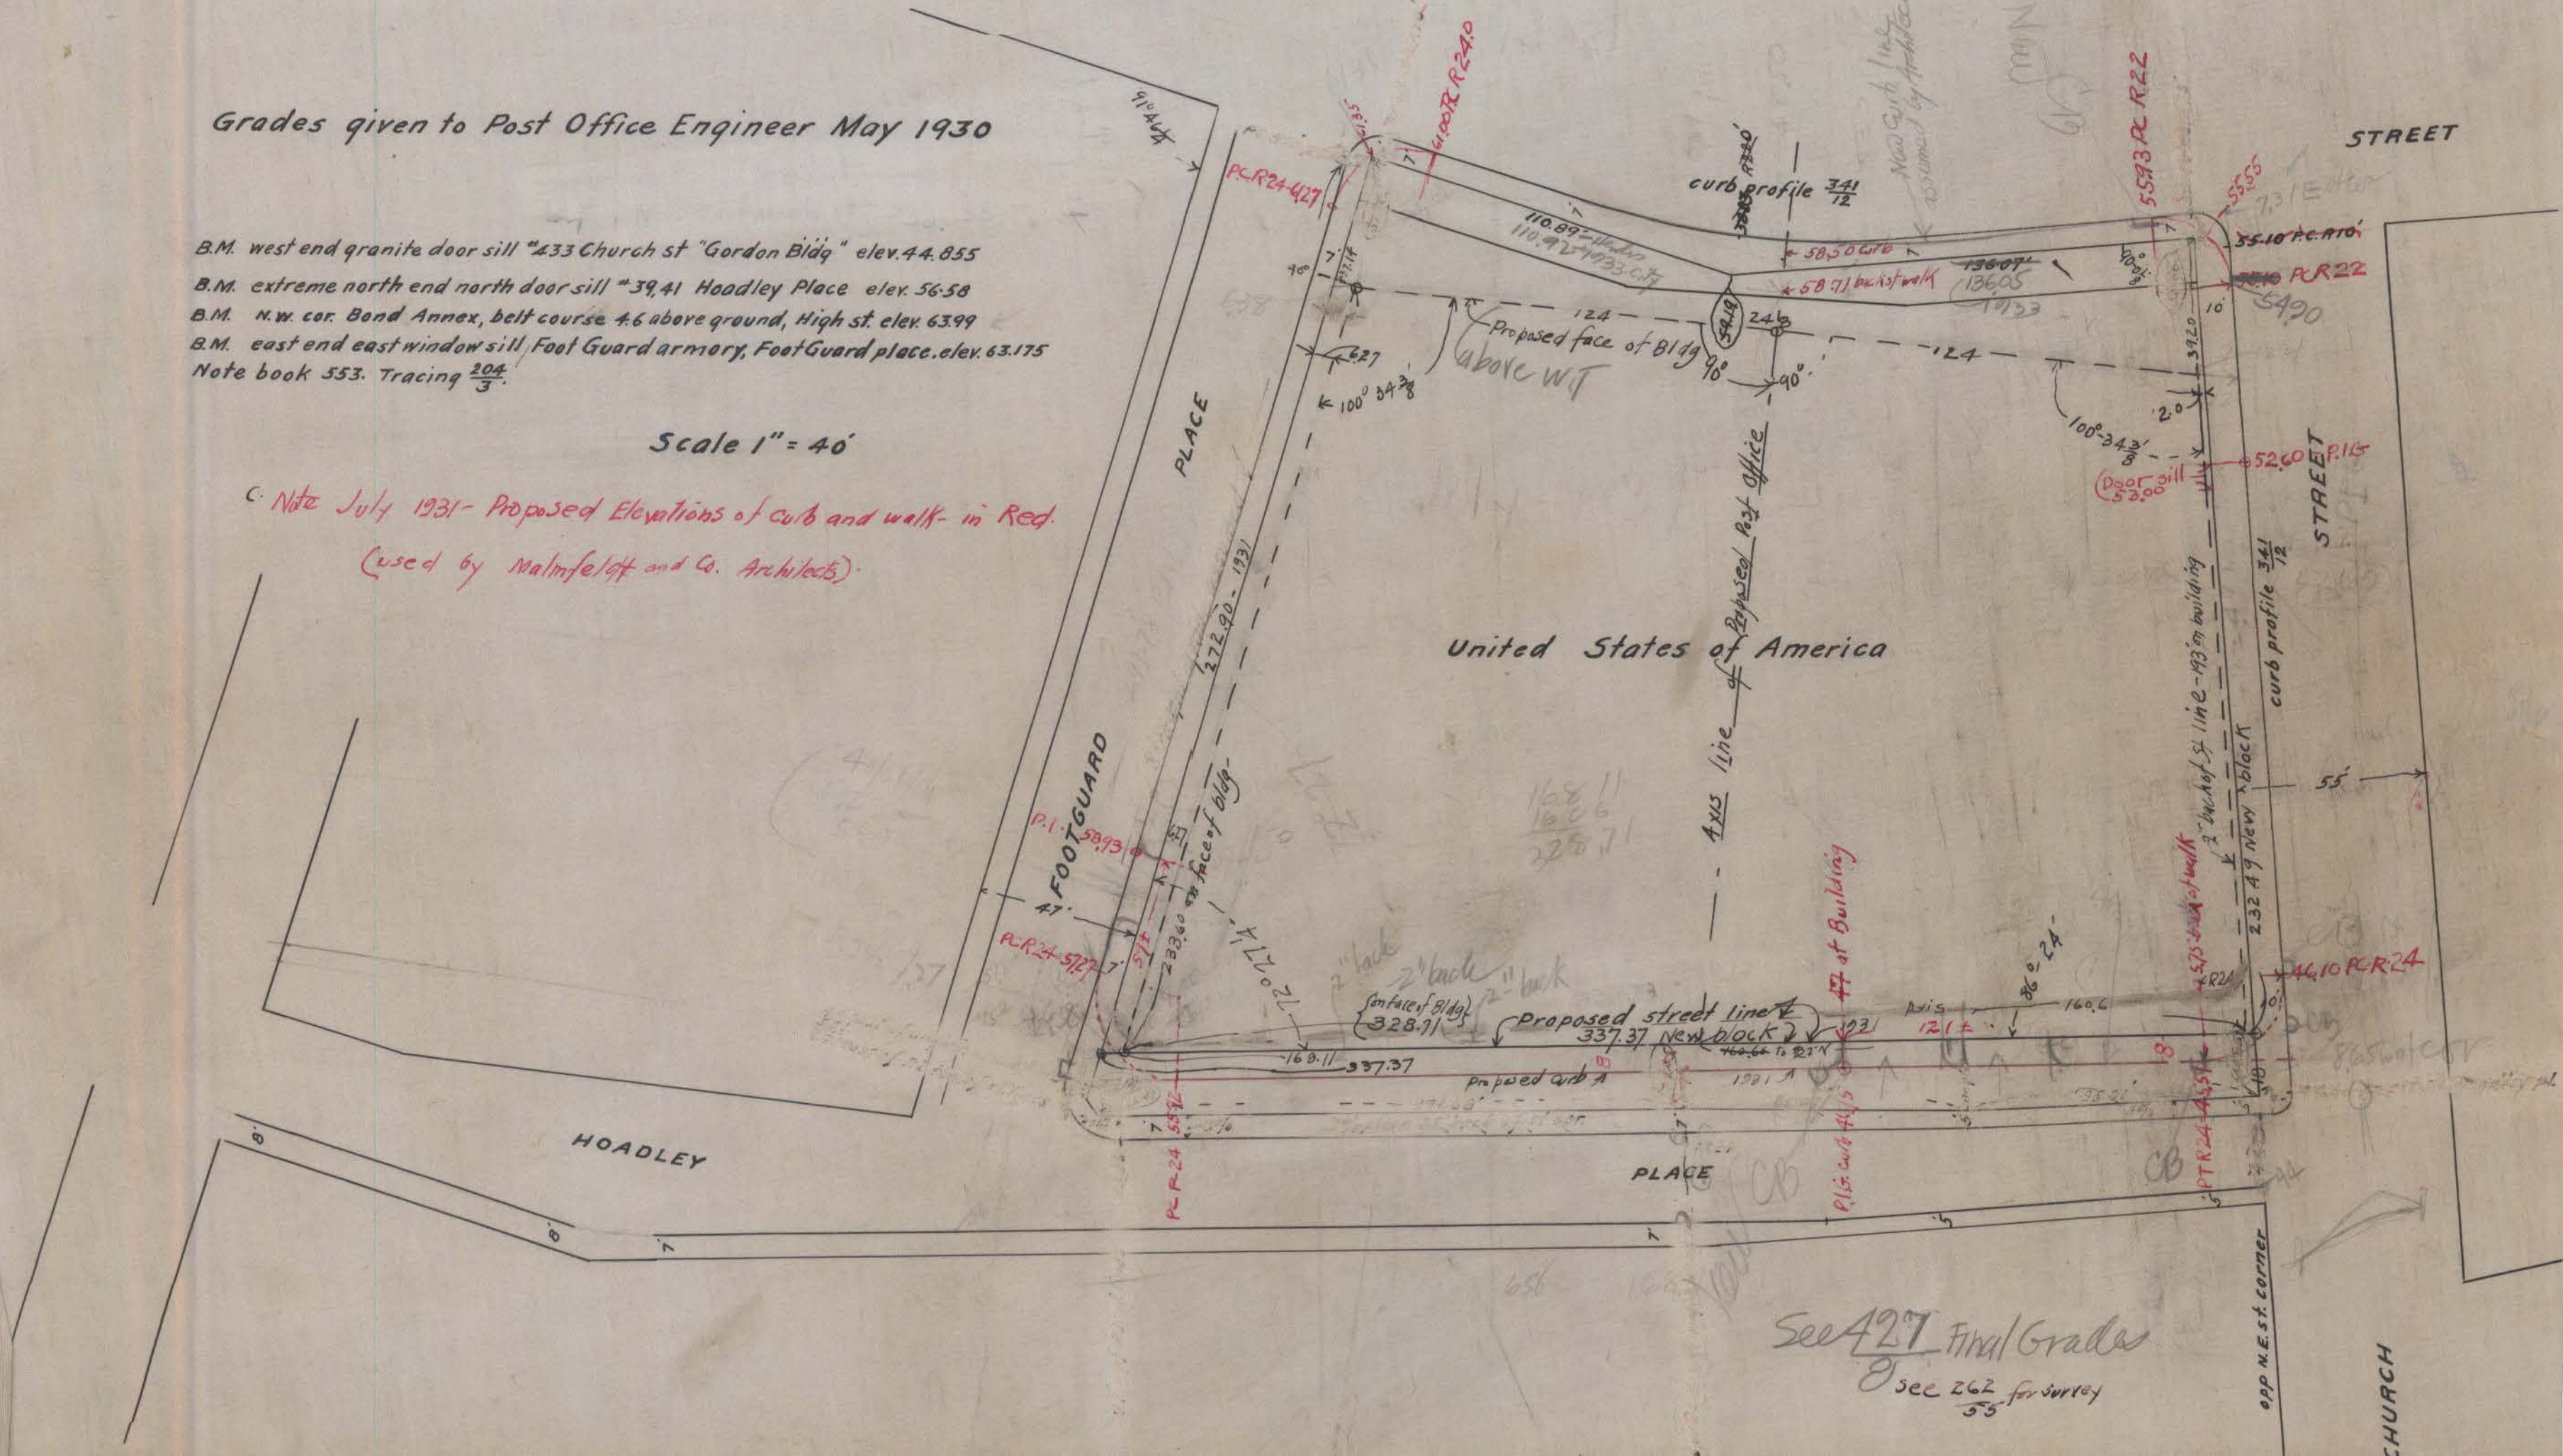

See 427 Final Grades
 See 262 for survey