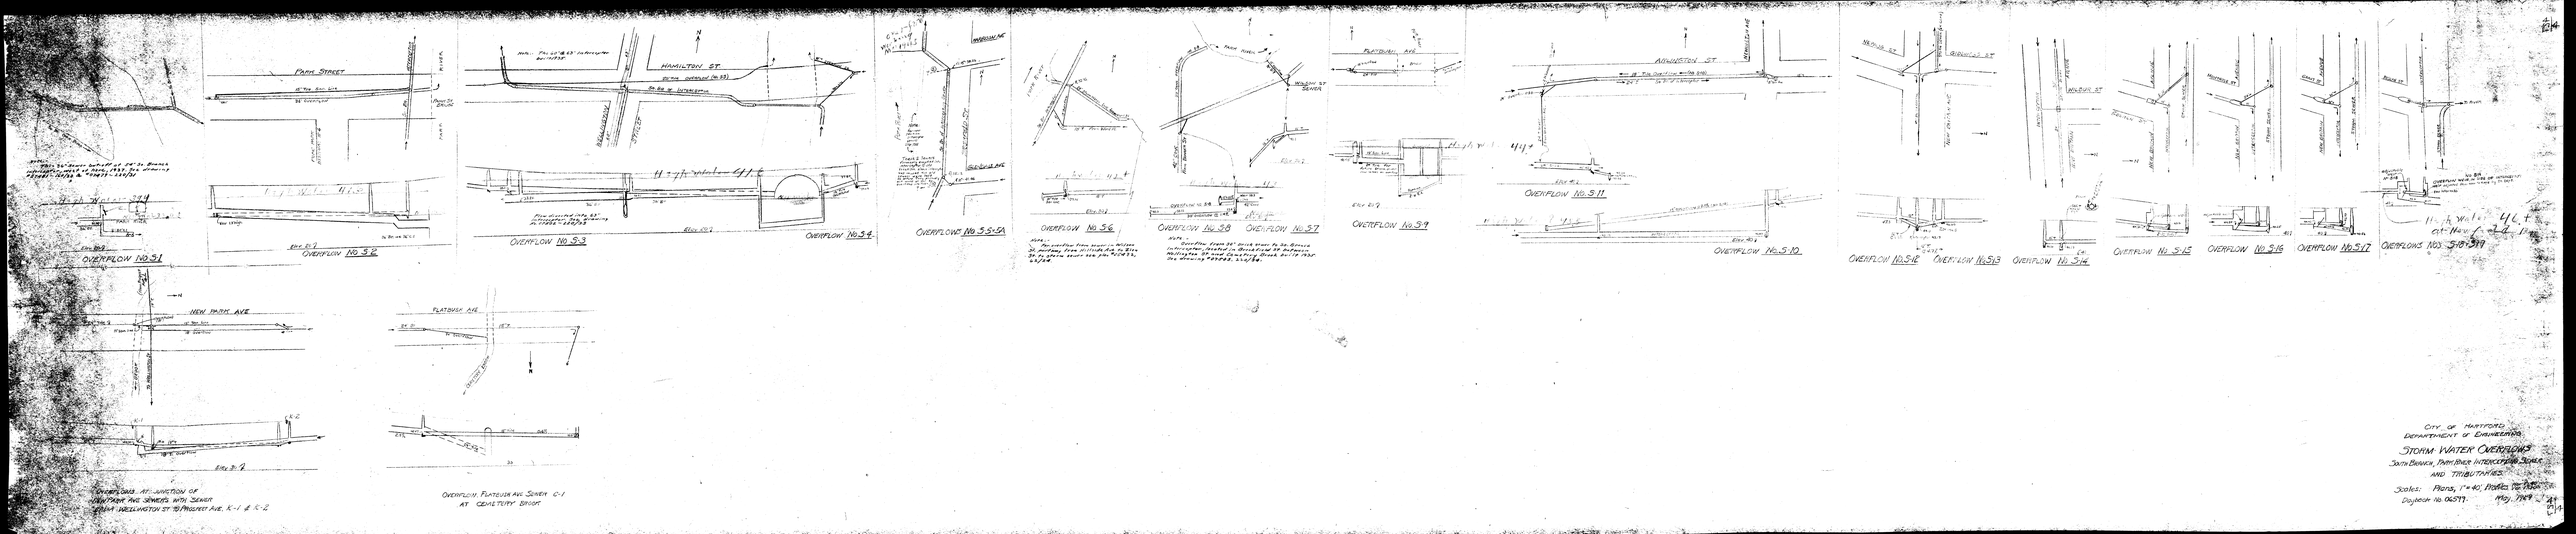


CITY OF HARTFORD
DEPARTMENT OF ENGINEERING

STORM WATER OVERFLOWS

SOUTH BRANCH, PARK RIVER INTERCEPTOR SEWER
AND TRIBUTARIES

Scales: Plans, 1" = 40', Profiles 1" = 10'
Drawn No. 0577. May, 1969