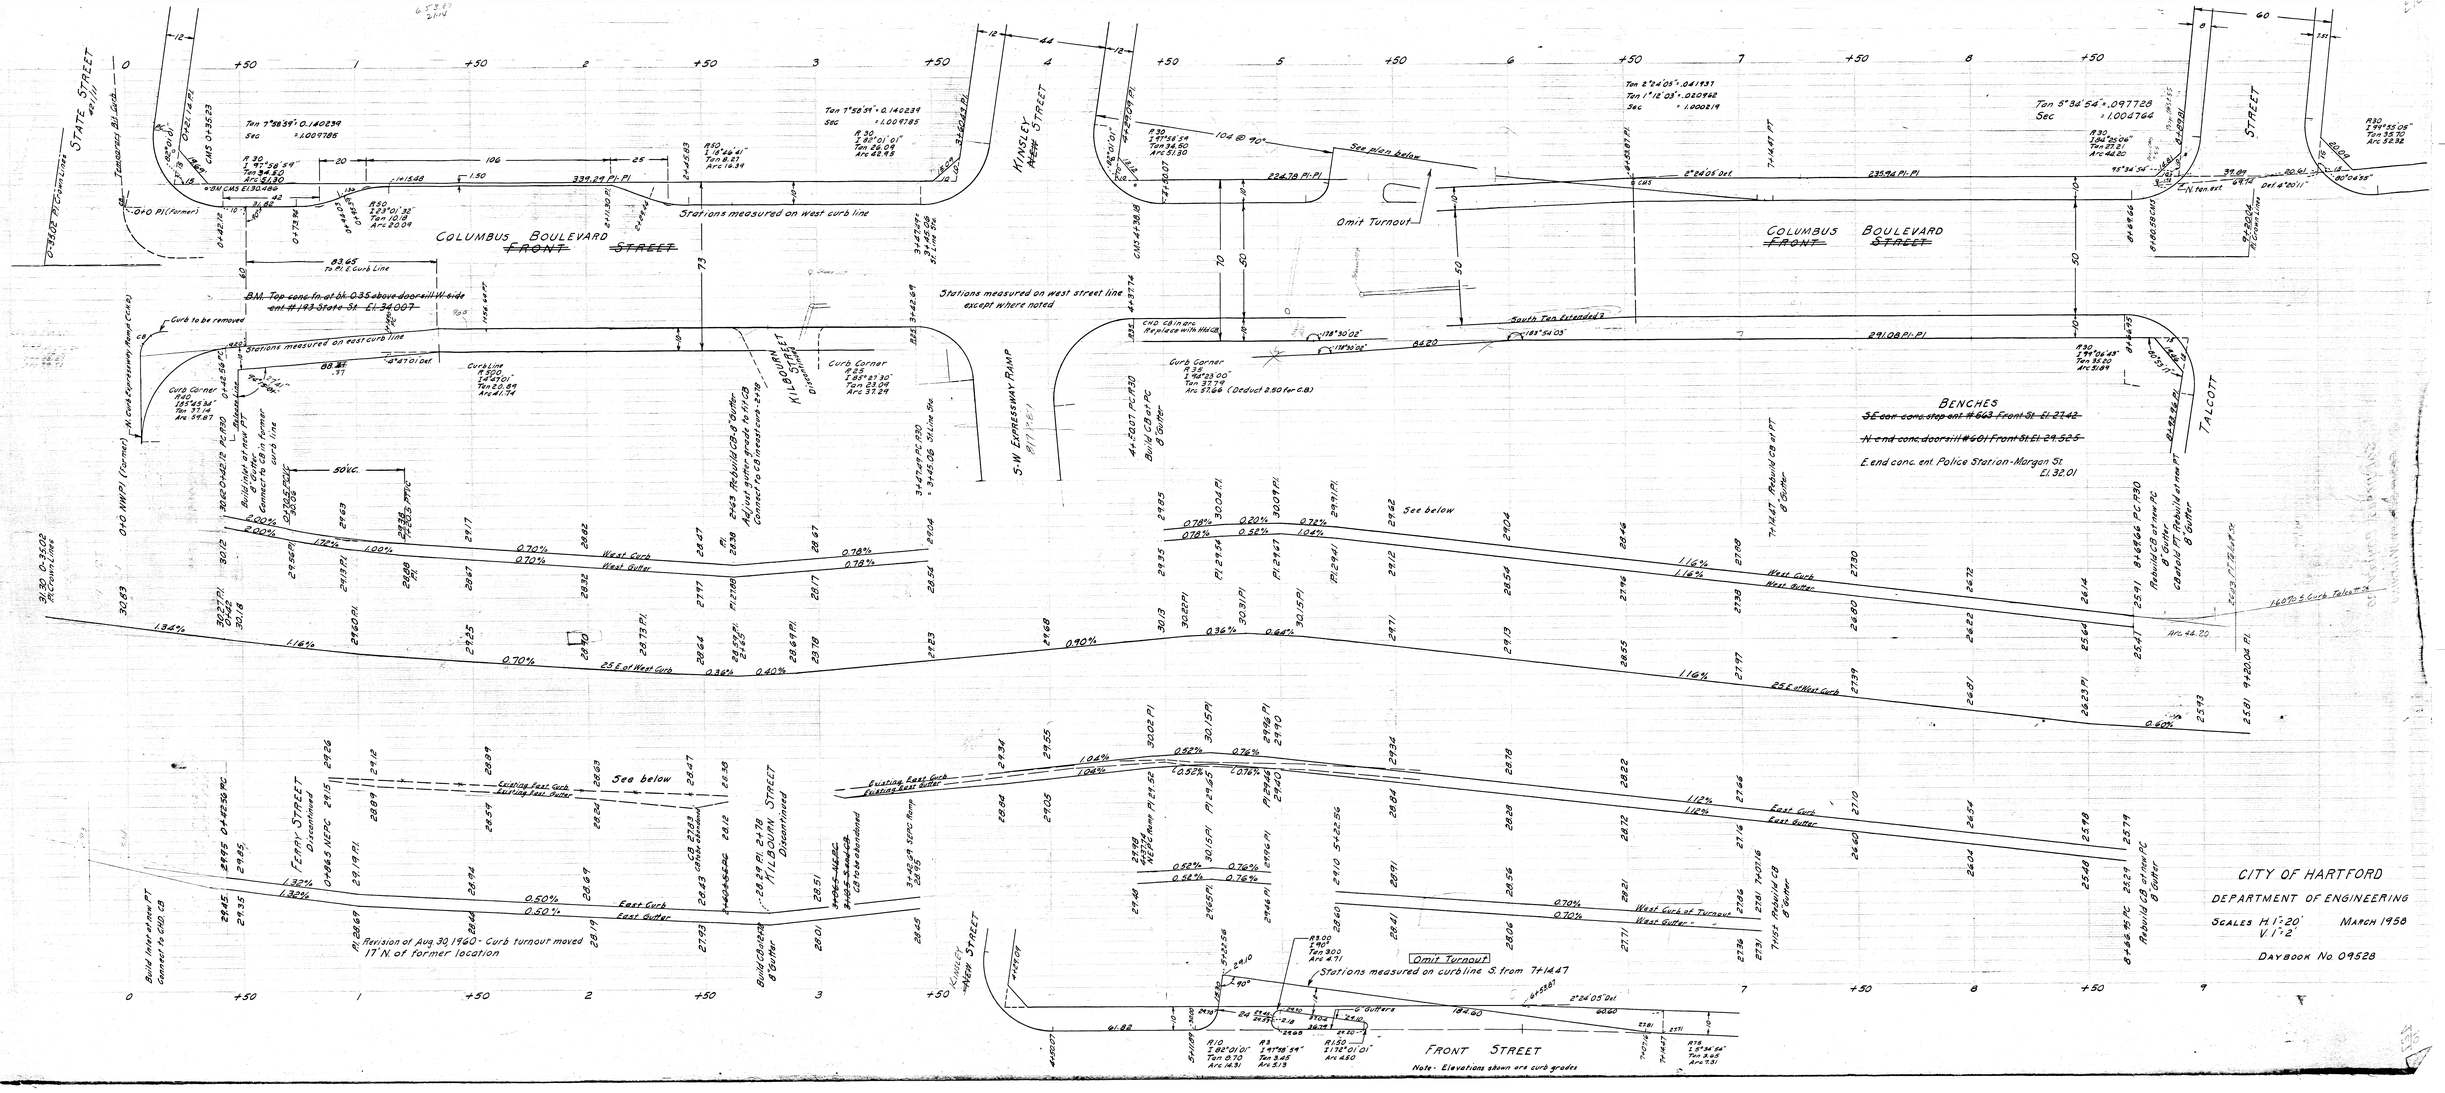
STATE STREET
COLUMBUS BOULEVARD
~~FRONT~~ ~~STREET~~
Stations measured on west curb line
Stations measured on west street line except where noted
Stations measured on east curb line
KINSLEY AVE STREET
S-W EXPRESSWAY RAMP
TALCOTT STREET
Omit Turnout
See plan below
See below
BENCHES
~~SE corr conc step ent #603 Front St El 27.42~~
~~N end conc doorsill #601 Front St El 29.525~~
E end conc. ent. Police Station-Morgan St. El. 32.01
FERRY STREET Discontinued
Revision of Aug 30 1960 - Curb turnout moved 17' N. of former location
Omit Turnout
Stations measured on curbline S. from 7+14.47
FRONT STREET
Note - Elevations shown are curb grades
CITY OF HARTFORD
DEPARTMENT OF ENGINEERING
SCALES H 1"=20' V 1"=2
MARCH 1958
DAYBOOK No 09528