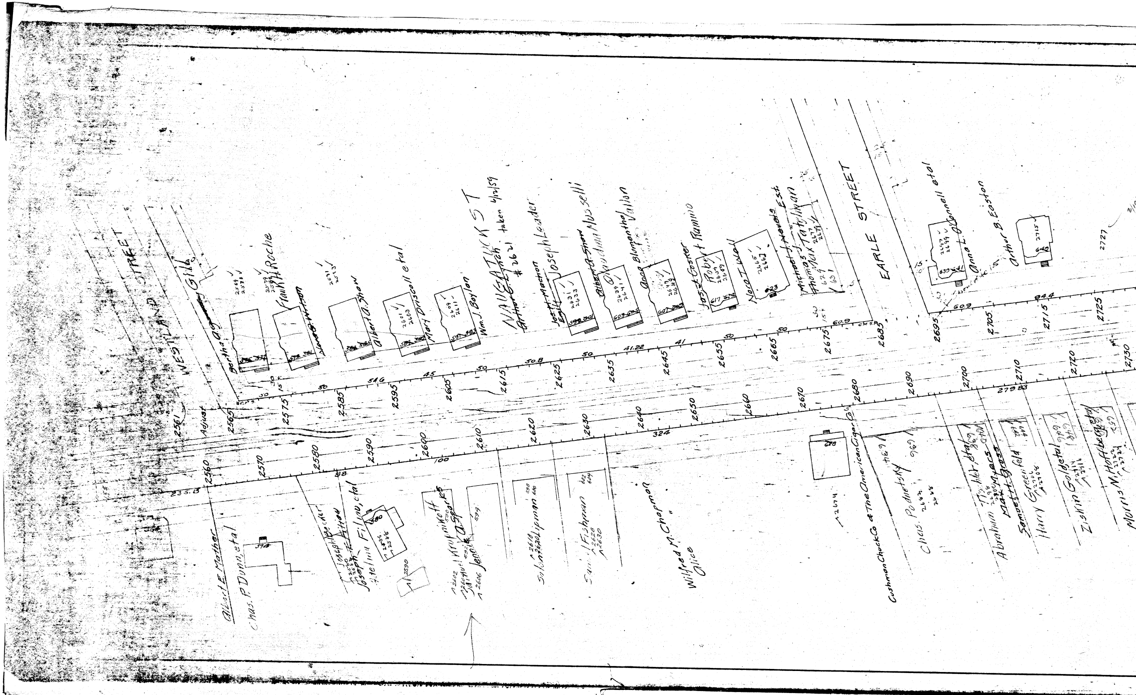

WESTLAND STREET
Gill
Bertha A.
2569
2571
Frank H. Roche
2579
2581
Nancy Hudson
2591
2593
Albert A. Shaw
2601
2603
Mary Driscoll etal
2609
2611
Wm. J. Boylan
NAUGATUCK ST
Arthur E. Lynch · taken 4/12/59
# 2621
Jos. H. Machon
Emily
Joseph Leader
2631
2633
Albert A. Shaw
Chiodinna Musselli
2639
2641
Anna Blumenthal
Vallon
2647
2649
Jos. & Gosker
Robert Ramino
2657
2659
Nora T. Wall
2665
2667
Michael J. Nevers Est.
Thomas J. Tatlimon
2677
2679
EARLE STREET
Anna L. O'Connell etal
2697
2699
Arthur B. Easton
2715
2727
Adjust
2561
2565
2575
2585
2595
2605
2615
2625
2635
2645
2655
2665
2675
2685
2695
2705
2715
2725
2730
2560
2570
2580
2590
2600
2610
2620
2630
2640
2650
2660
2670
2680
2690
2700
2710
2720
54.6
45
50
50.8
41.22
41
60.9
94.4
233.13
88
100
324
279.83
Albert E. Mather
Chas. P. Dunn, etal
574
Joseph Beider
Joseph F. Filino, etal
Adeline
580
2586
2590
Krupnikoff
A. Sparks
Jennie
594
2602
2606
Solomon Lipman
598
600
2618
2620
Samuel Fishman
602
604
2628
2630
Wilfred M. Chapman
Alice
628
2674
Cushman Chuck Co & The American Cigar Co.
Chas. Podnetsky
2682
2688
Abraham Tischler, etal
Max Myers
Matt H. Gross
Samuel Greenfeld
Harry Greenfeld
2706
2708
Zishkin Goldetal
2714
2716
Morris N. Hoffberg etal
2722
2724

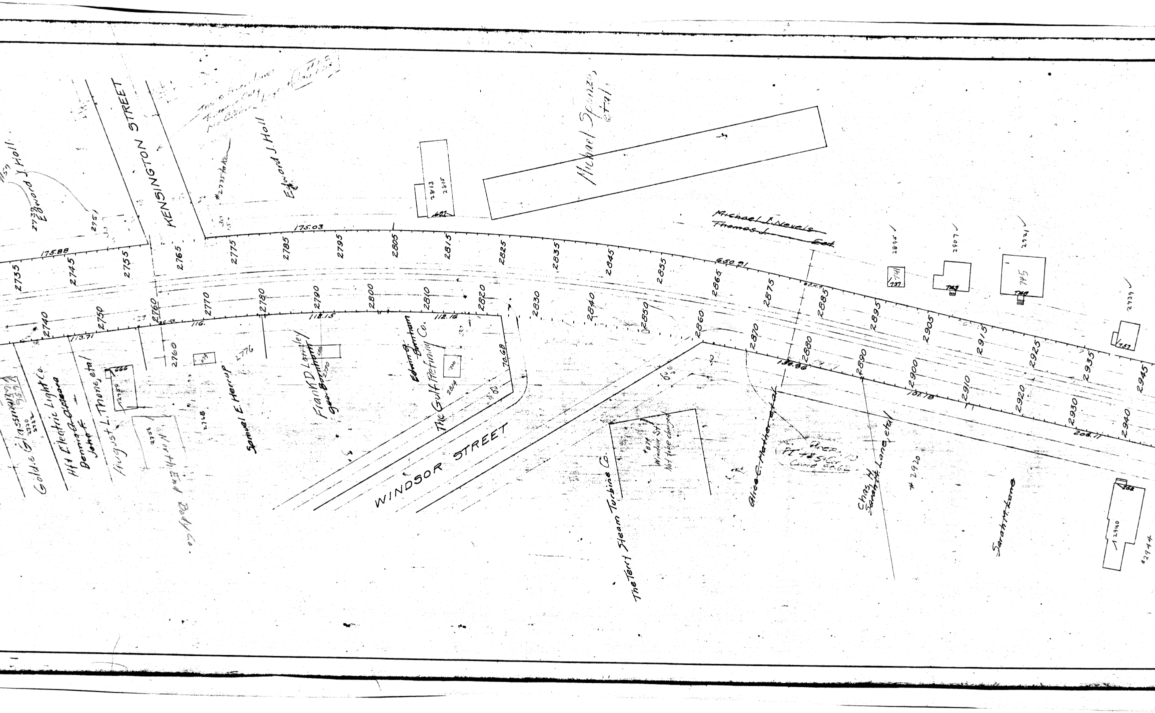
KENSINGTON STREET
WINDSOR STREET
Edward J. Holl
Edward J. Holl
Michael Sponzo, et al.
~~Michael J. Nevels~~
Thomas J. Est
Goldie Glassman
Hfd Electric Light Co.
Bennett A. Cimeno
John F.
August L. Thone, et al
Samuel E. Herrup
Frank D. Lamley
Geo. Bonham
Edwin G. Bonham
The Gulf Refining Co.
The Terry Steam Turbine Co.
Windsor St. Not to be changed
Alice C. Hollher et al
Chas. H.
Sarah H. Lane, et al
Sarah H. Lane
175.88
175.03
650.91
113.71
116.
118.15
112.16
70.68
130.86
101.18
208.11
2735
2740
2813
2815
2776
2814
#2775
#2920
#2944
2895
2907
2921
2939
666
737
743
745
749
757
762

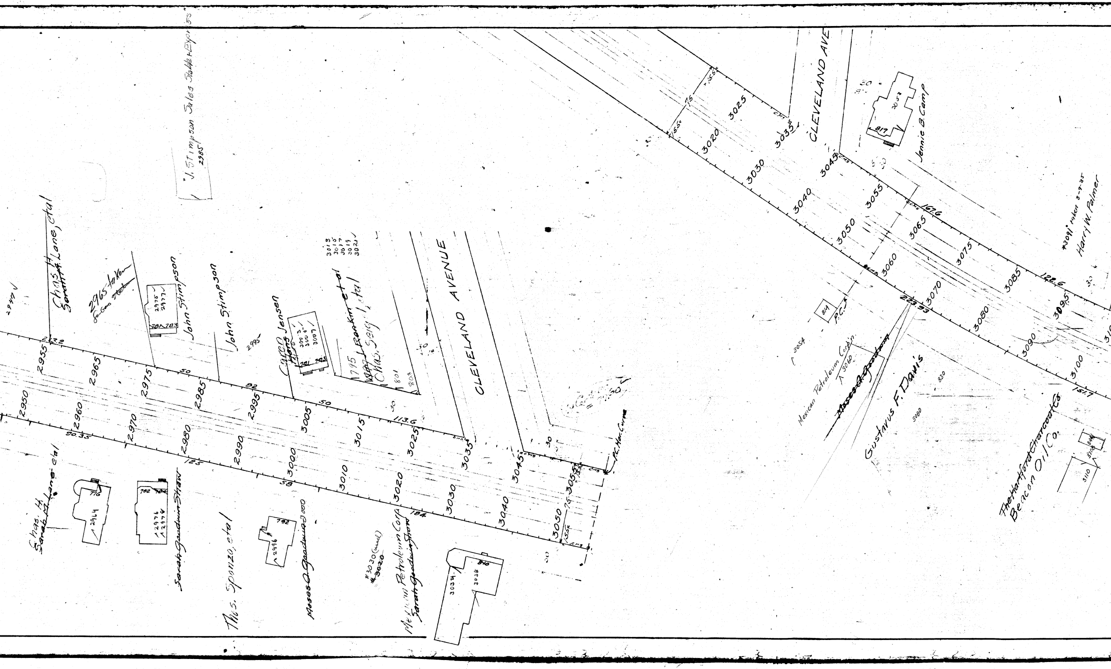
"J. Stimpson Sales Stable + Expr 55"
2985
Chas. H. ~~Sarah M.~~ Lane, et al
2947
2965 taken ~~[illegible]~~
John Stimpson
2975
2977
781 783
John Stimpson
2995
Caren Jensen
3003
3005
3007
791 793
3013
3015
3017
3019
3021
~~Wm J. Rankin et al~~
Chas. Seig'l, et al
795
801
803
CLEVELAND AVENUE
CLEVELAND AVE
213.2
2955
2965
2975
50
2985
82
2995
50
3005
3015
113.6
3025
3035
2950
2960
2970
2980
2990
3000
3010
3020
3030
3040
3050
90.35
125
58
184
3045
3055
P.C. Hor. Curve
Chas. H. ~~Sarah M.~~ Lane et al
776
2964
782 784
2976
2978
Sarah Goodwin Shaw
Thos. Sponzo, et al
792
2996
Moses O. Goodwin 3000
#3030 (used)
~~#3020~~
Mexican Petroleum Corp
~~Sarah Goodwin Shaw~~
3034
3038
810
3020
3025
75
15.5
3030
3035
3040
3045
3050
3055
3060
3065
3070
3075
3080
3085
3090
3095
3100
167.6
122.6
223.93
151.7
3052
817
Jennie B. Camp
#3091 taken 3-9-35
Harry W. Palmer
814
P.C.
3054
Mexican Petroleum Corp'n.
3060
~~Moses O. Goodwin~~
Gustavus F. Davis
830
3080
The Hartford Charcoal Co.
Beacon Oil Co.
844
3108
3110

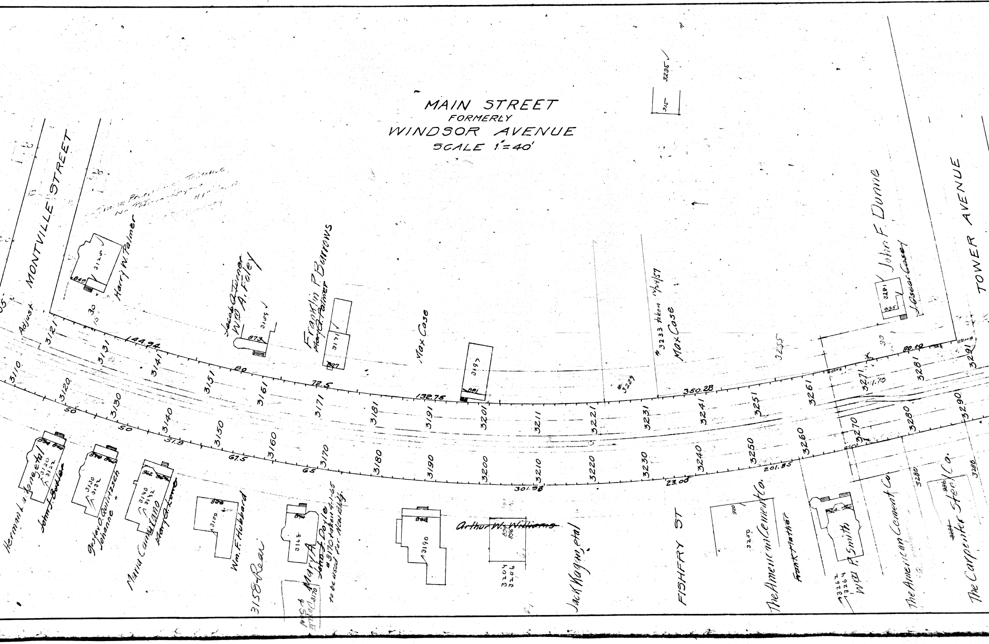
MAIN STREET
FORMERLY
WINDSOR AVENUE
SCALE 1"=40'
MONTVILLE STREET
TOWER AVENUE
FISHFRY ST
Adjust
Harry W. Palmer
3126
Jacob A. Ziner
Wm. A. Foley
Franklin P. Burrows
Harry A. Palmer
3171
Max Case
3197
#3233 taken 11/4/57
Max Case
3235
3229
3255
John F. Dunne
J. Oscar Casey
3281
144.94
80
72.5
132.75
350.28
80.10
3121
3131
3141
3151
3161
3171
3181
3191
3201
3211
3221
3231
3241
3251
3261
3271
3281
3291
3110
3120
3130
3140
3150
3160
3170
3180
3190
3200
3210
3220
3230
3240
3250
3260
3270
3280
3290
50
50
51.8
67.5
65
301.98
23.00
201.85
Herman Laione et al
~~John J. Butler~~
3120
3122
Gustav O. Quilitzsch
Johanne "
3130
3132
Maria Carmel Yano
~~Mary A. Lane~~
3140
3142
Wm. F. Hubbard
3150
3158-Rear
Mary A. Doyle
~~John J. Doyle~~
#3170 taken 4-1-65
to be used for New Bldg.
3168
3170
3190
~~Arthur W. Williams~~
Jack Wagner, et al
3204
3206
The American Cement Co.
~~Frank Mather~~
3250
Wm. P. Smith
3262
3264
The American Cement Co.
3280
The Carpenter Steel Co.
3286

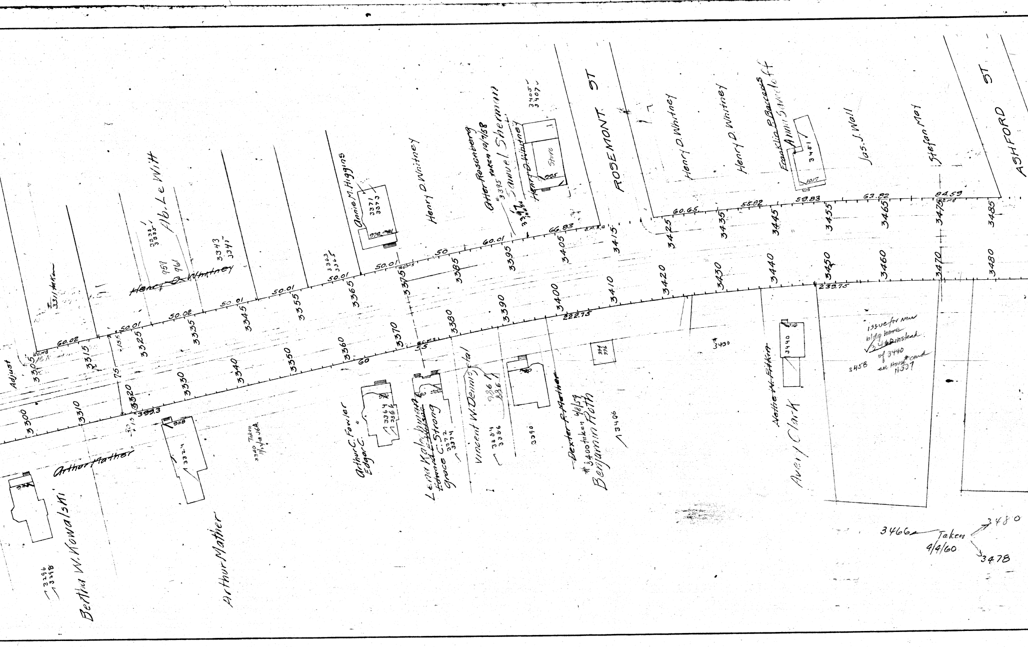
ROSEMONT ST
ASHFORD ST
Adjust
3311 taken
Alb. LeWitt
3333
3335
959
961
~~Henry D. Whitney~~
3343
3347
3363
3365
Annie M. Higgins
3371
3373
979
981
Henry D. Whitney
Otter Rosenberg
3395 taken 10/7/58
Samuel Sherman
3397
Henry D. Whitney
Store
995
3405
3407
Henry D. Whitney
Henry D. Whitney
Franklin P. Baccaus
Annie Sandloff
3451
1017
Jas. J. Wall
Stefan Moy
60.02
50.01
50.02
50.01
50.01
50.01
50.01
50
60.01
66.83
60.65
55.82
59.83
63.82
84.59
3305
3315
3325
3335
3345
3355
3365
3375
3385
3395
3405
3415
3425
3435
3445
3455
3465
3475
3485
3300
3310
3320
3330
3340
3350
3360
3370
3380
3390
3400
3410
3420
3430
3440
3450
3460
3470
3480
75
399.3
60
55
222.75
239.75
944
Arthur Mather
Bertha W. Kowalski
3296
3298
958
3324
Arthur Mather
3340 Taken 11/24/48 JGA
Arthur C. Fowler
Edgar C. "
3364
3366
Lena Kalebush
~~Edward C. Strong~~
Grace C. Strong
3372
3374
980
982
Vincent W. Dennis et al
986
3384
3386
990
3390
~~Dexter P. Mather~~
#3400 taken 4/8/59
Benjamin Roth
3406
994
996
3430
~~Nettie M. Pitkin~~
Avery Clark
1016
3440
issue for new bldg here
3458 instead of 3440
see House # card 11537
3458
3466
Taken 4/4/60
3480
3478

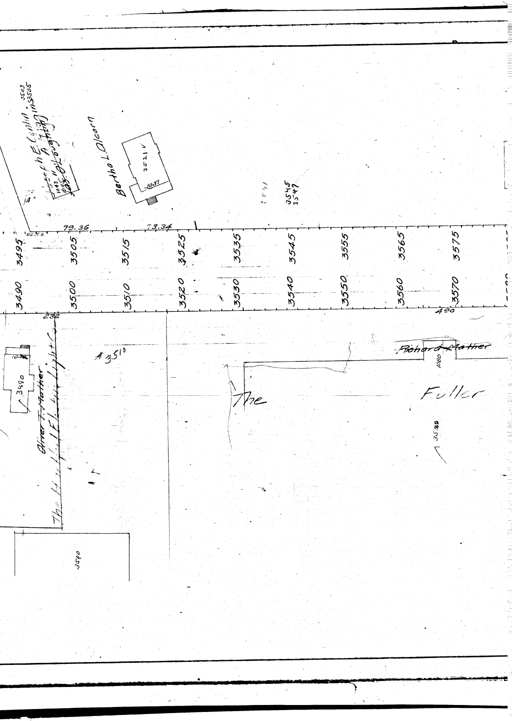
Bertha L. Olcorn
3503
3505
1043
14
3521
1051
3545
3547
79.36
73.34
3495
3505
3515
3525
3535
3545
3555
3565
3575
3490
3500
3510
3520
3530
3540
3550
3560
3570
232
490
Oliver F. Mather
The Ill. El. Light
3490
3510
~~Richard Mather~~
1080
The
Fuller
3580
3500