


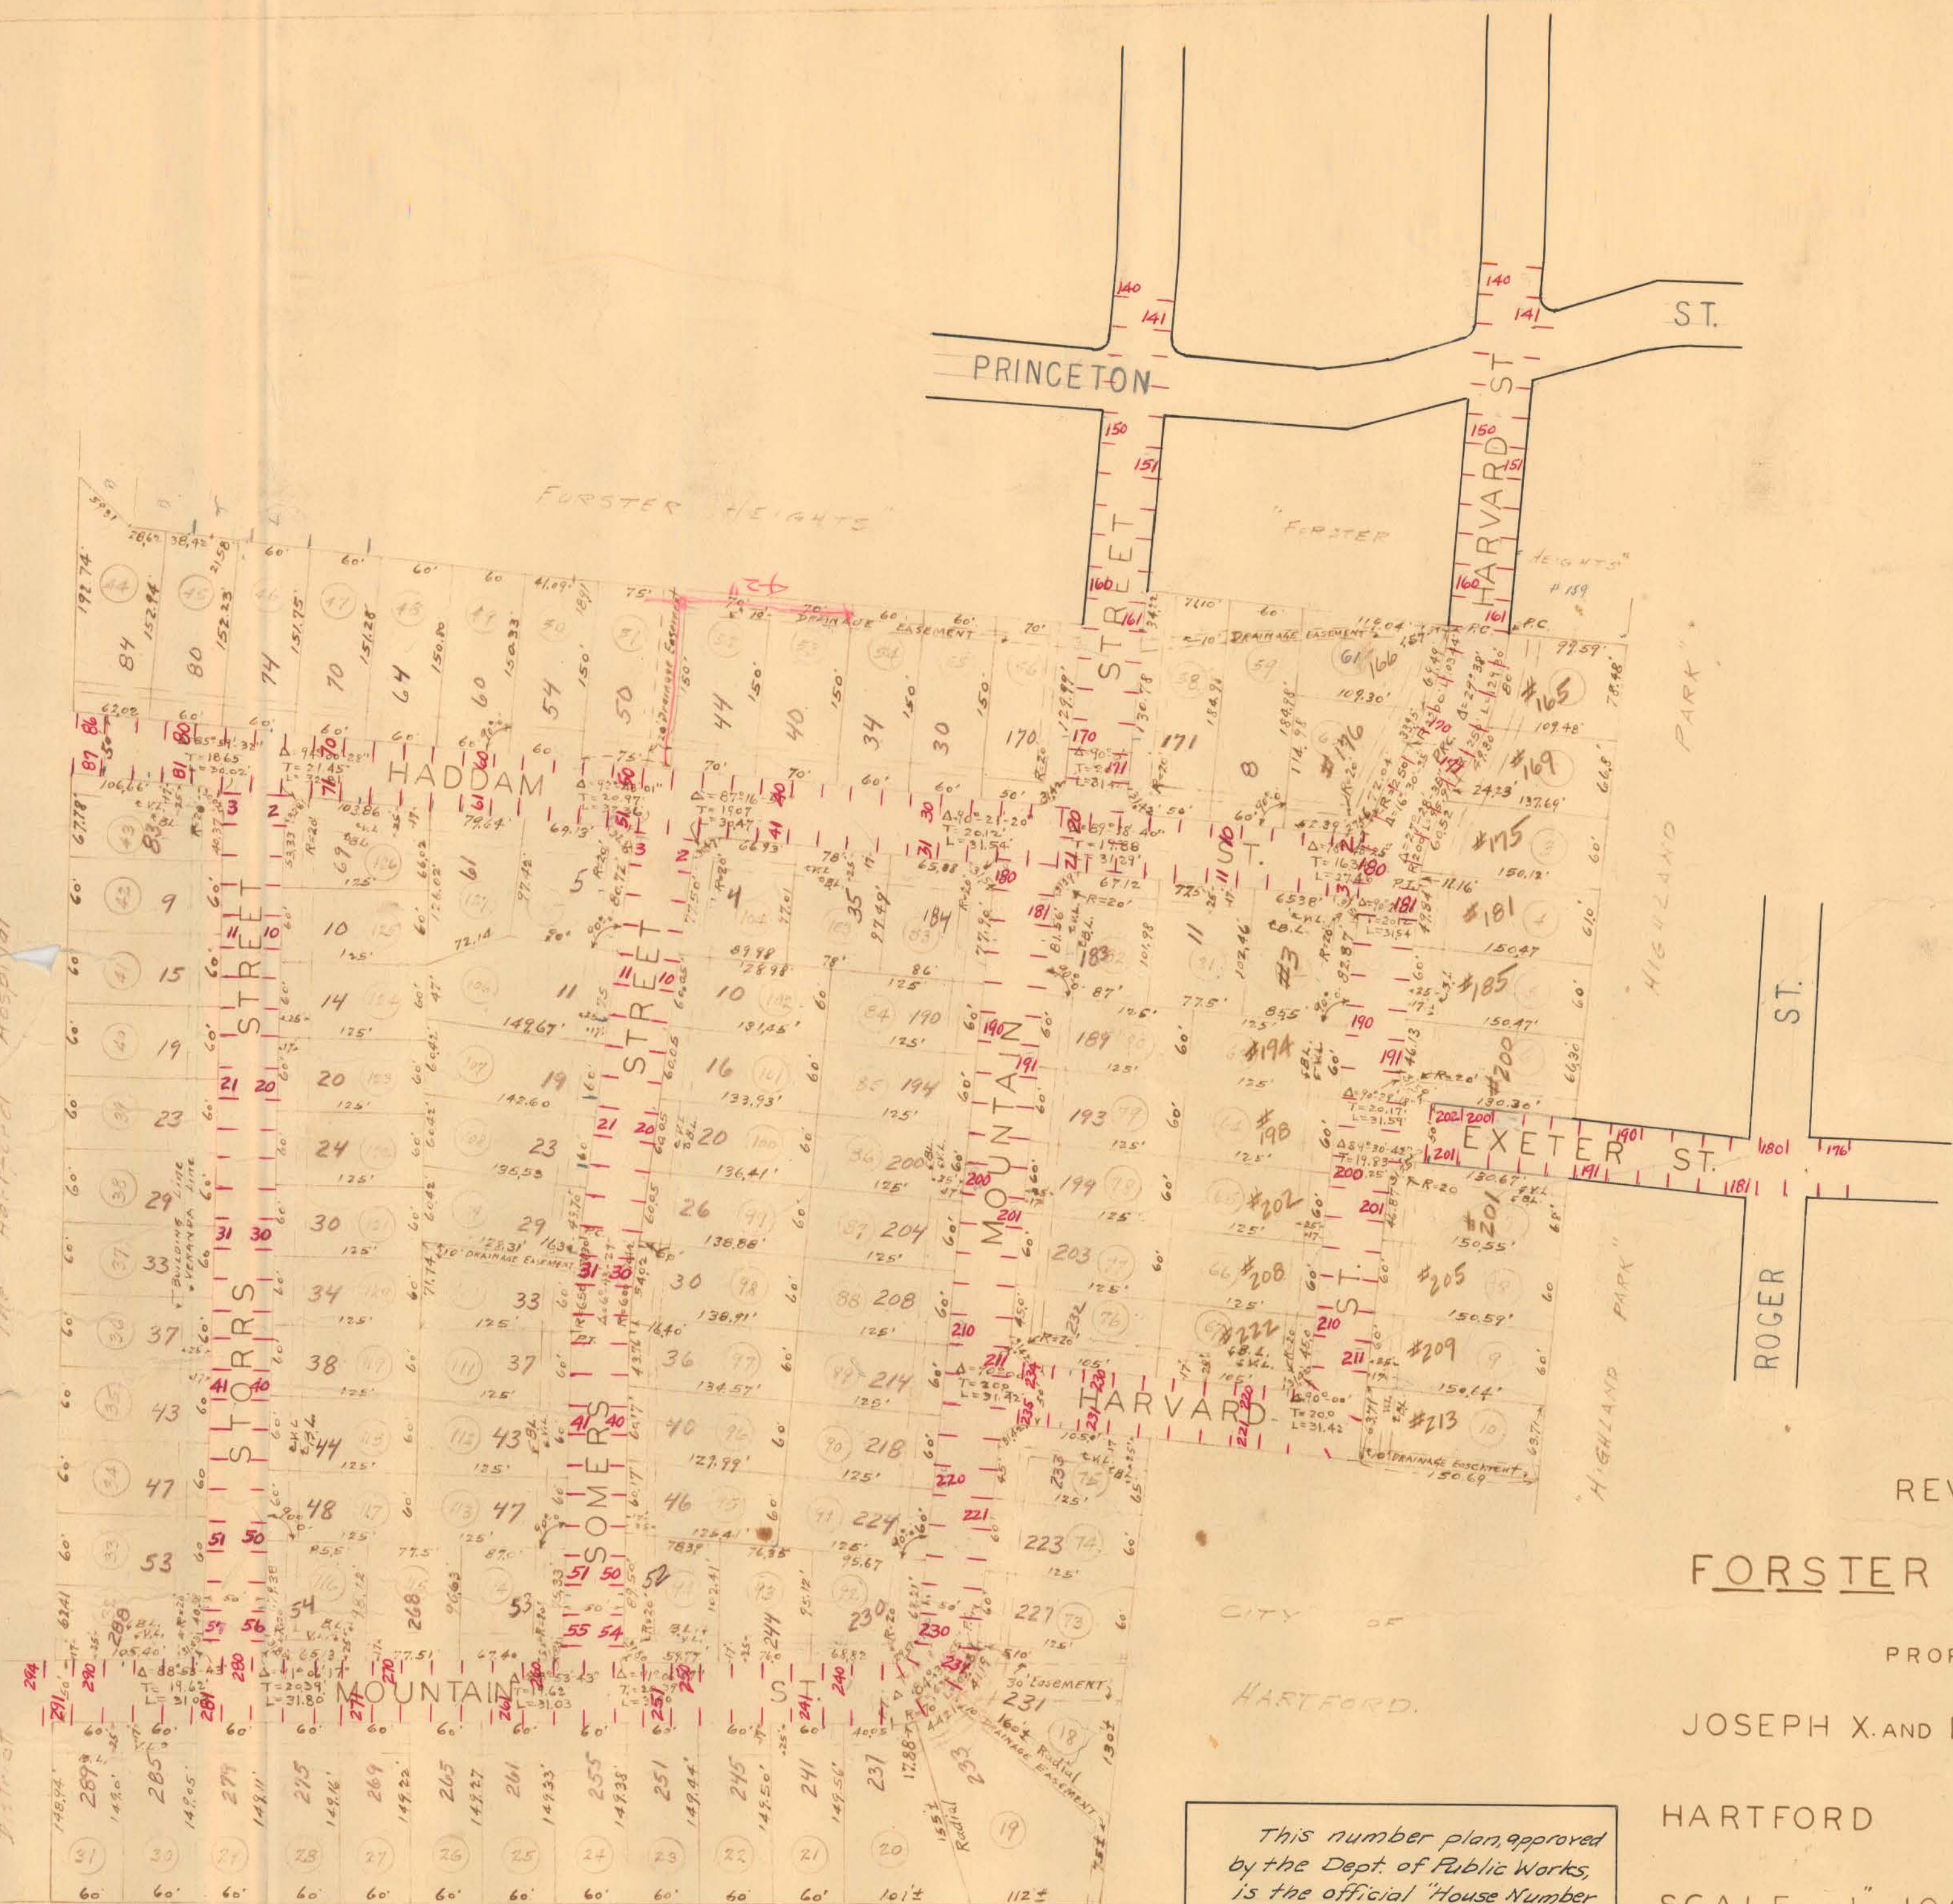

REVISED MAP

FORSTER HEIGHTS MANOR

PROPERTY OF

JOSEPH X. AND BERNARD I. FRIEDMAN

HARTFORD

CONNECTICUT

SCALE 1"=100'

JULY 29, 1954

STREET LINES APPROVED BY CITY JULY 26, 1954

NUMBER PLAN

HADDAM, SOMERS & STORRS STS.
ext. of, EXETER, HARVARD & MOUNTAIN STS.

Interval 25 feet

Note:- House numbers issued shown in brown.

This number plan, approved by the Dept. of Public Works, is the official "House Number Plan" for Haddam, Somers & Storrs Sts. Also for Exeter, Harvard, & Mountain Sts. (extended).
Chas. V. Moore
Director of Public Works

I hereby certify that this map is substantially correct.

F. Perry Close Civil Engineer

F. PERRY CLOSE
CIVIL AND CONSULTING ENGINEER
HARTFORD, CONN.