


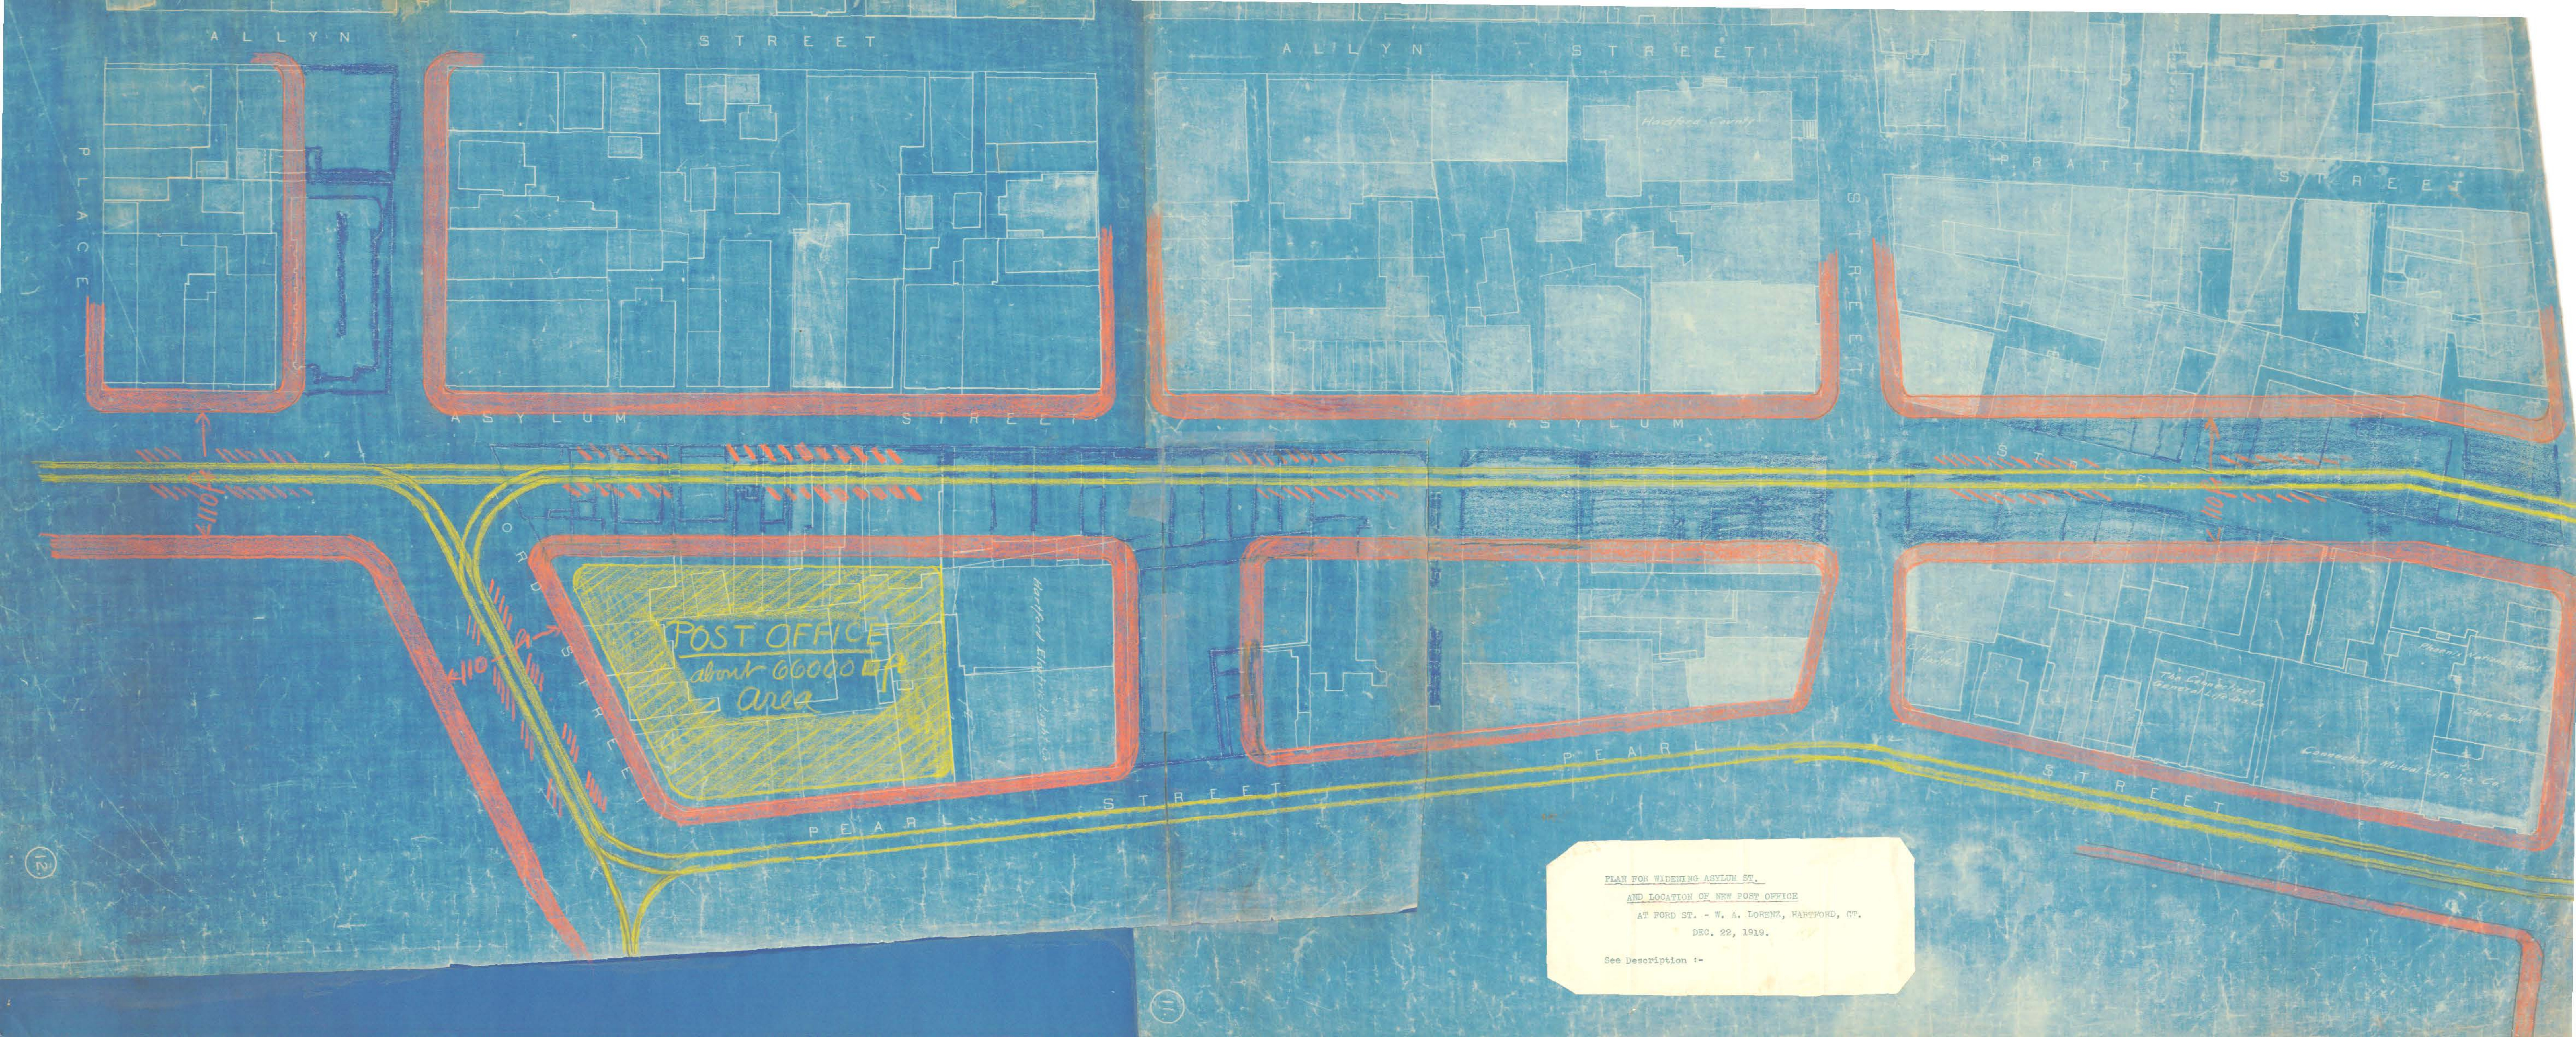

PLAN FOR WIDENING ASYLUM ST.

AND LOCATION OF NEW POST OFFICE

AT FORD ST. - W. A. LORENZ, HARTFORD, CT.

DEC. 22, 1919.

See Description :-