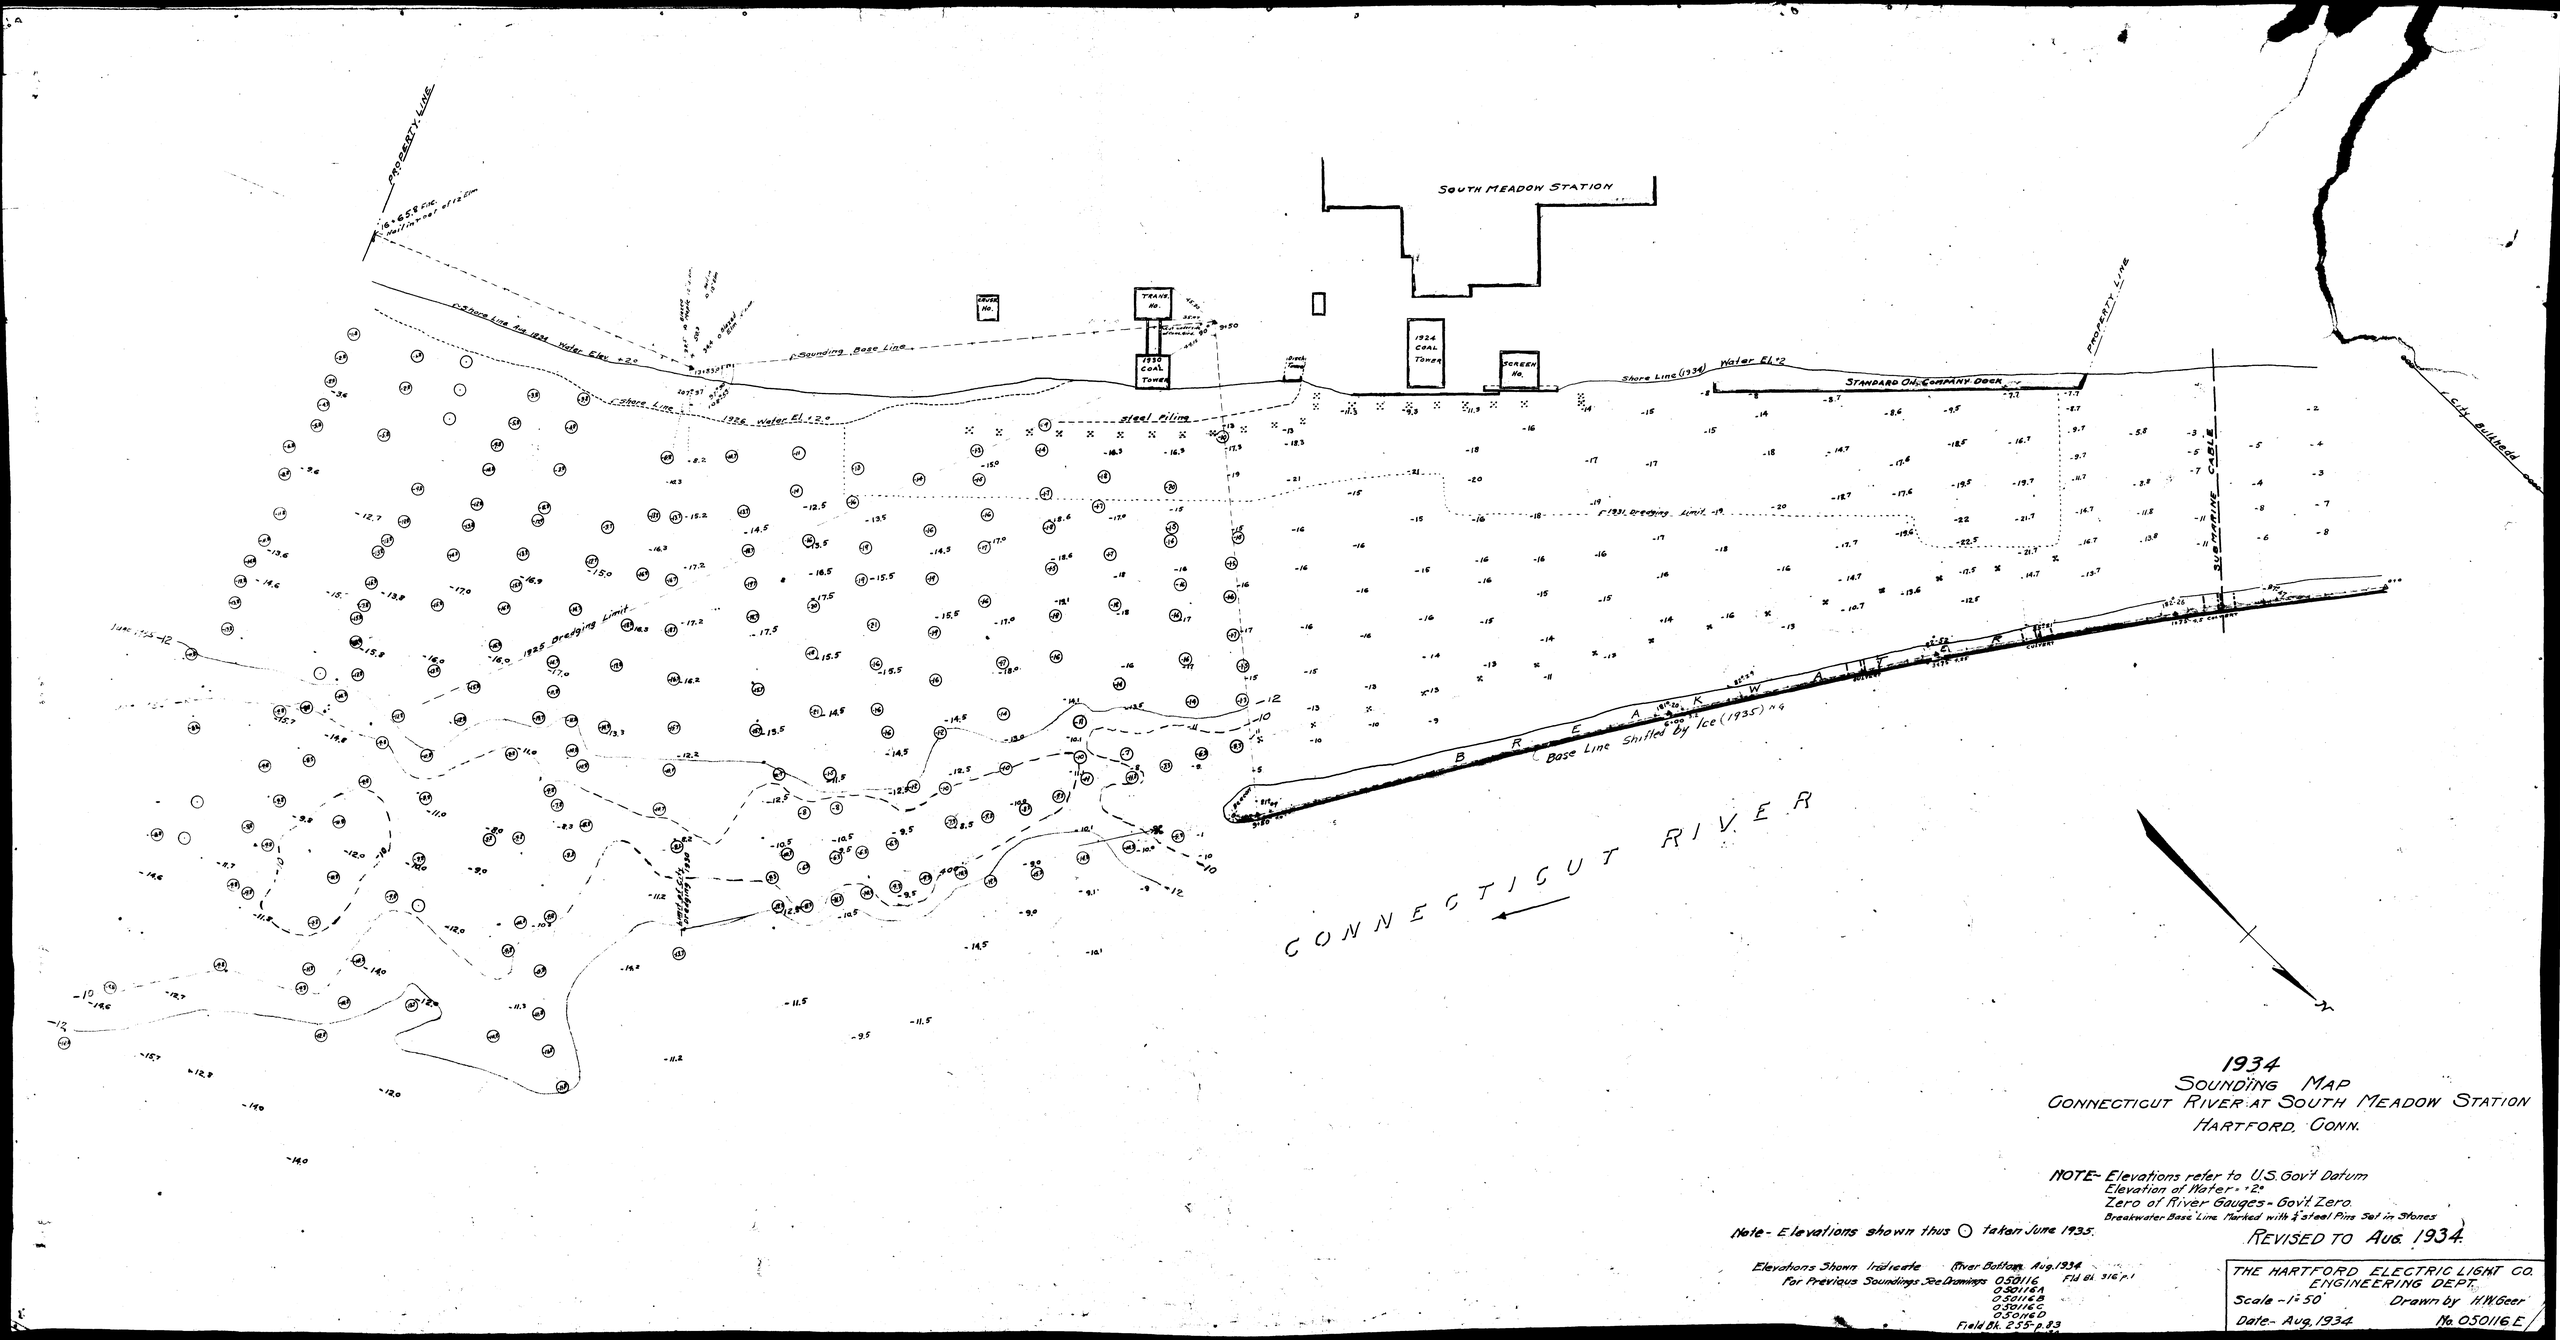

1934
SOUNDING MAP
CONNECTICUT RIVER AT SOUTH MEADOW STATION
HARTFORD, CONN.

NOTE- Elevations refer to U.S. Gov't Datum
Elevation of Water = +2'
Zero of River Gauges - Gov't Zero.
Breakwater Base Line Marked with ¾" steel Pins Set in Stones

Note - Elevations shown thus ○ taken June 1935.

REVISED TO Aug. 1934.

Elevations Shown Indicate River Bottom Aug. 1934
For Previous Soundings See Drawings 050116 Fld Bk. 316 p. 1
050116A
050116B
050116C
050116D
Field Bk. 235-p. 83

THE HARTFORD ELECTRIC LIGHT CO. ENGINEERING DEPT.	
Scale - 1" = 50'	Drawn by H.W. Geer
Date - Aug. 1934	No. 050116 E