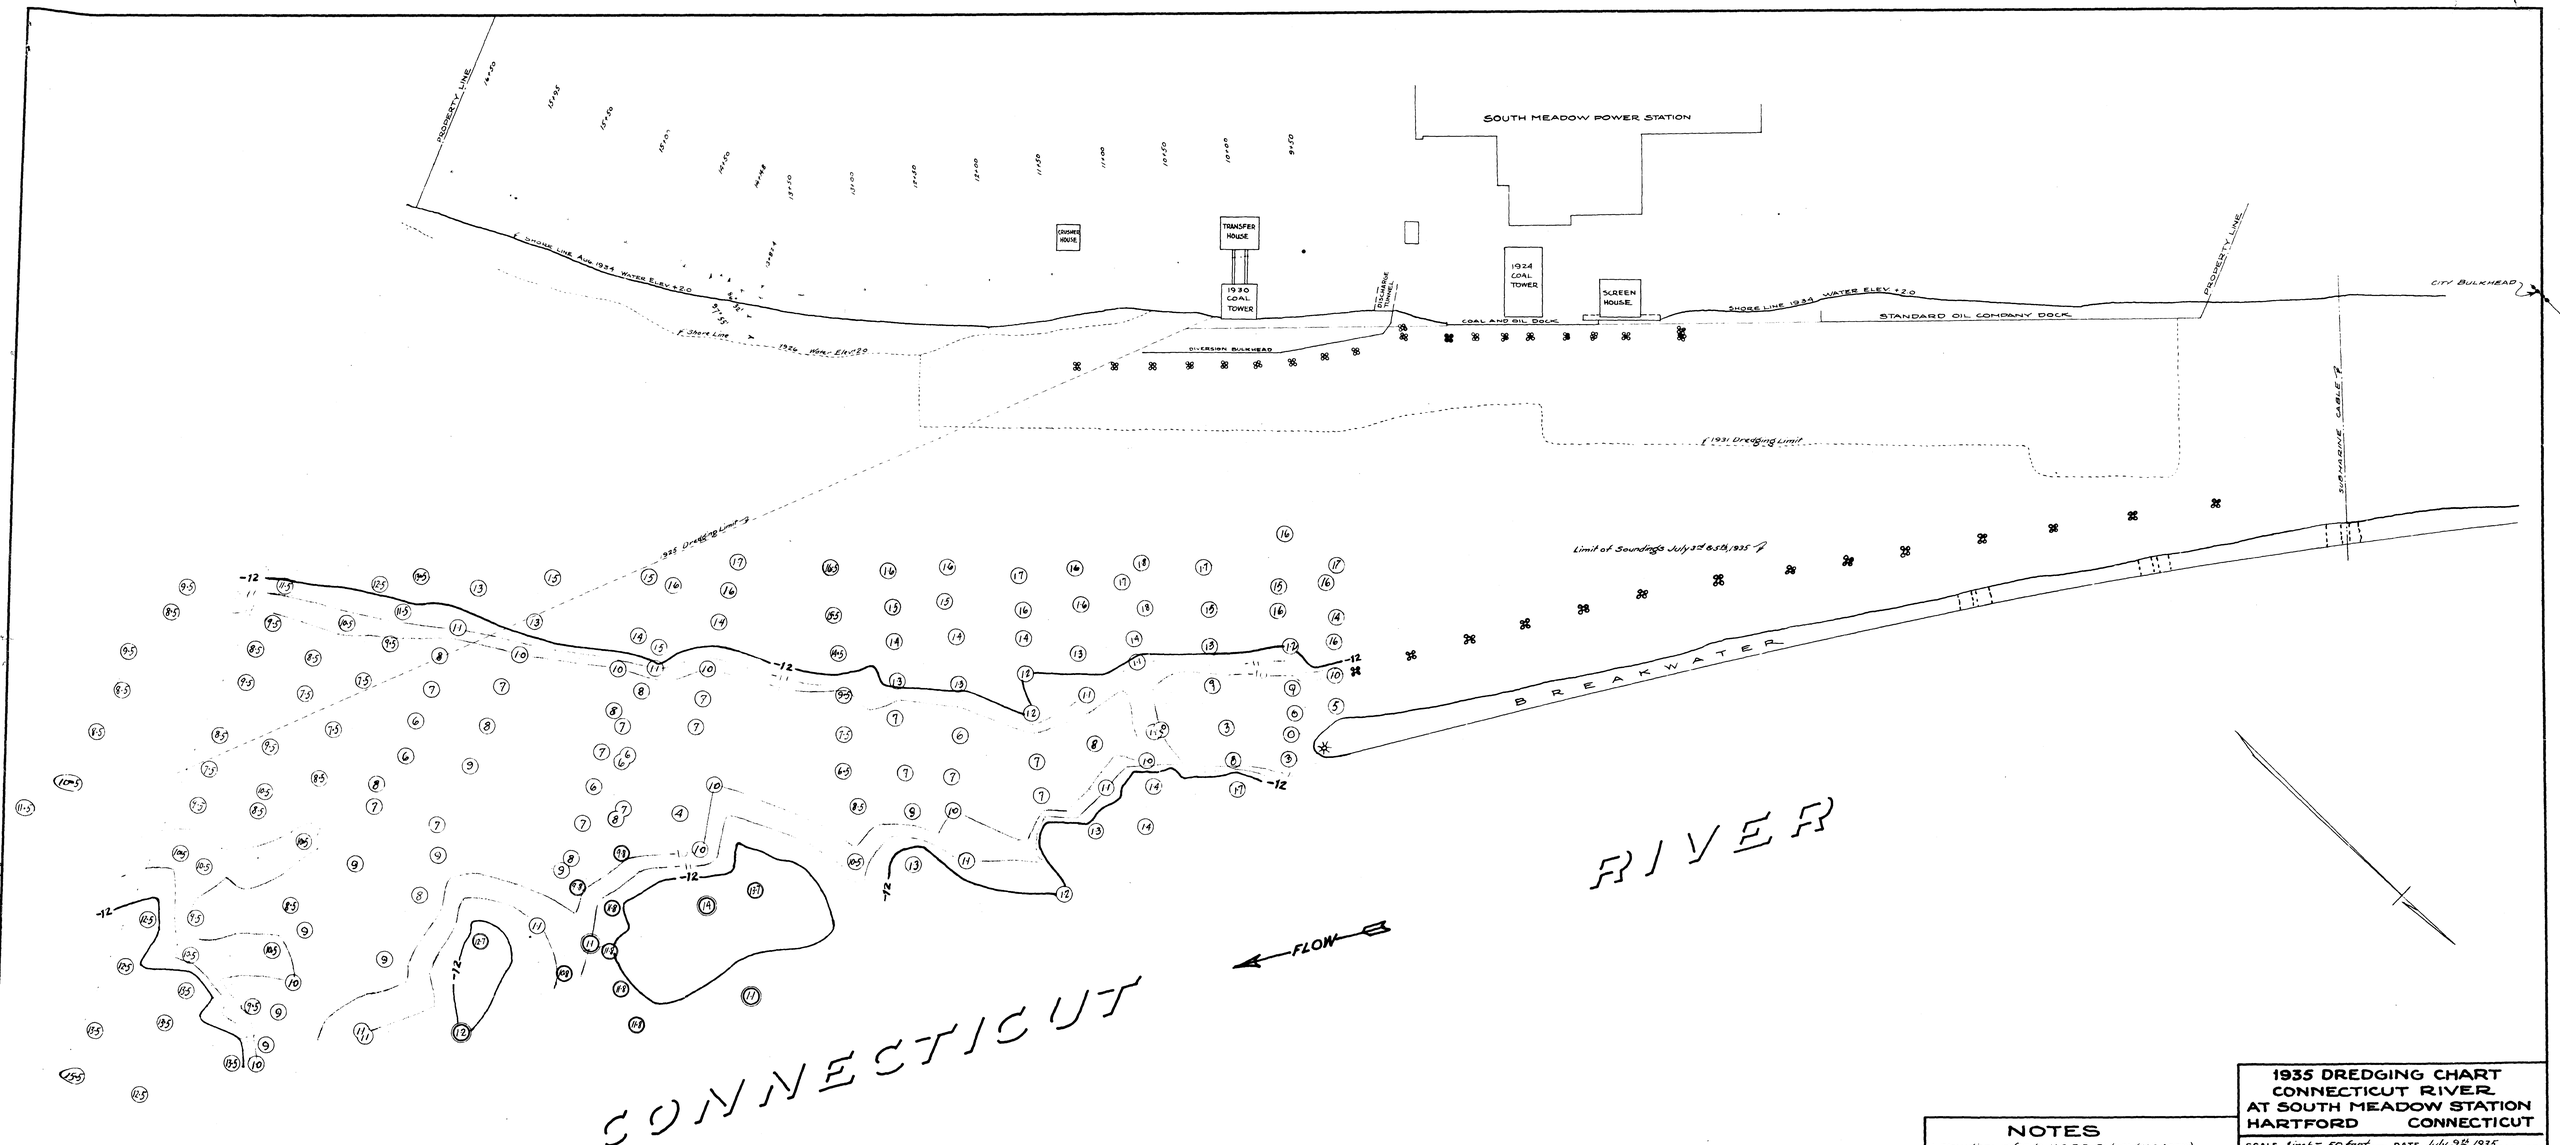

NOTES

1. Elevations refer to U.S.E.D. Datum (U.S. Army)
2. Mean Low Water equals +2.0
3. All elevations are NEGATIVE i.e. 12 = -12
4. Center of circle equals point of sounding
5. Elevations of August 1934 shown
6. Elevations of June 5, 1935 shown
7. Elevations of July 3&5, 1935 shown

1935 DREDGING CHART CONNECTICUT RIVER AT SOUTH MEADOW STATION HARTFORD CONNECTICUT

SCALE 1 inch = 50 feet	DATE July 9th 1935
DRAWN BY E. P. Lewis Jr.	TRACED FM. Field Notes - Books
TRACED BY E. P. L. Jr.	NUMBER #255, 316 & 317
CHECKED BY	
APPROVED BY	ORDER NO.

THE HARTFORD ELECTRIC LIGHT CO.
ENGINEERING DEPT. FILE NO. 050116-F

FILE No. 050116-F