


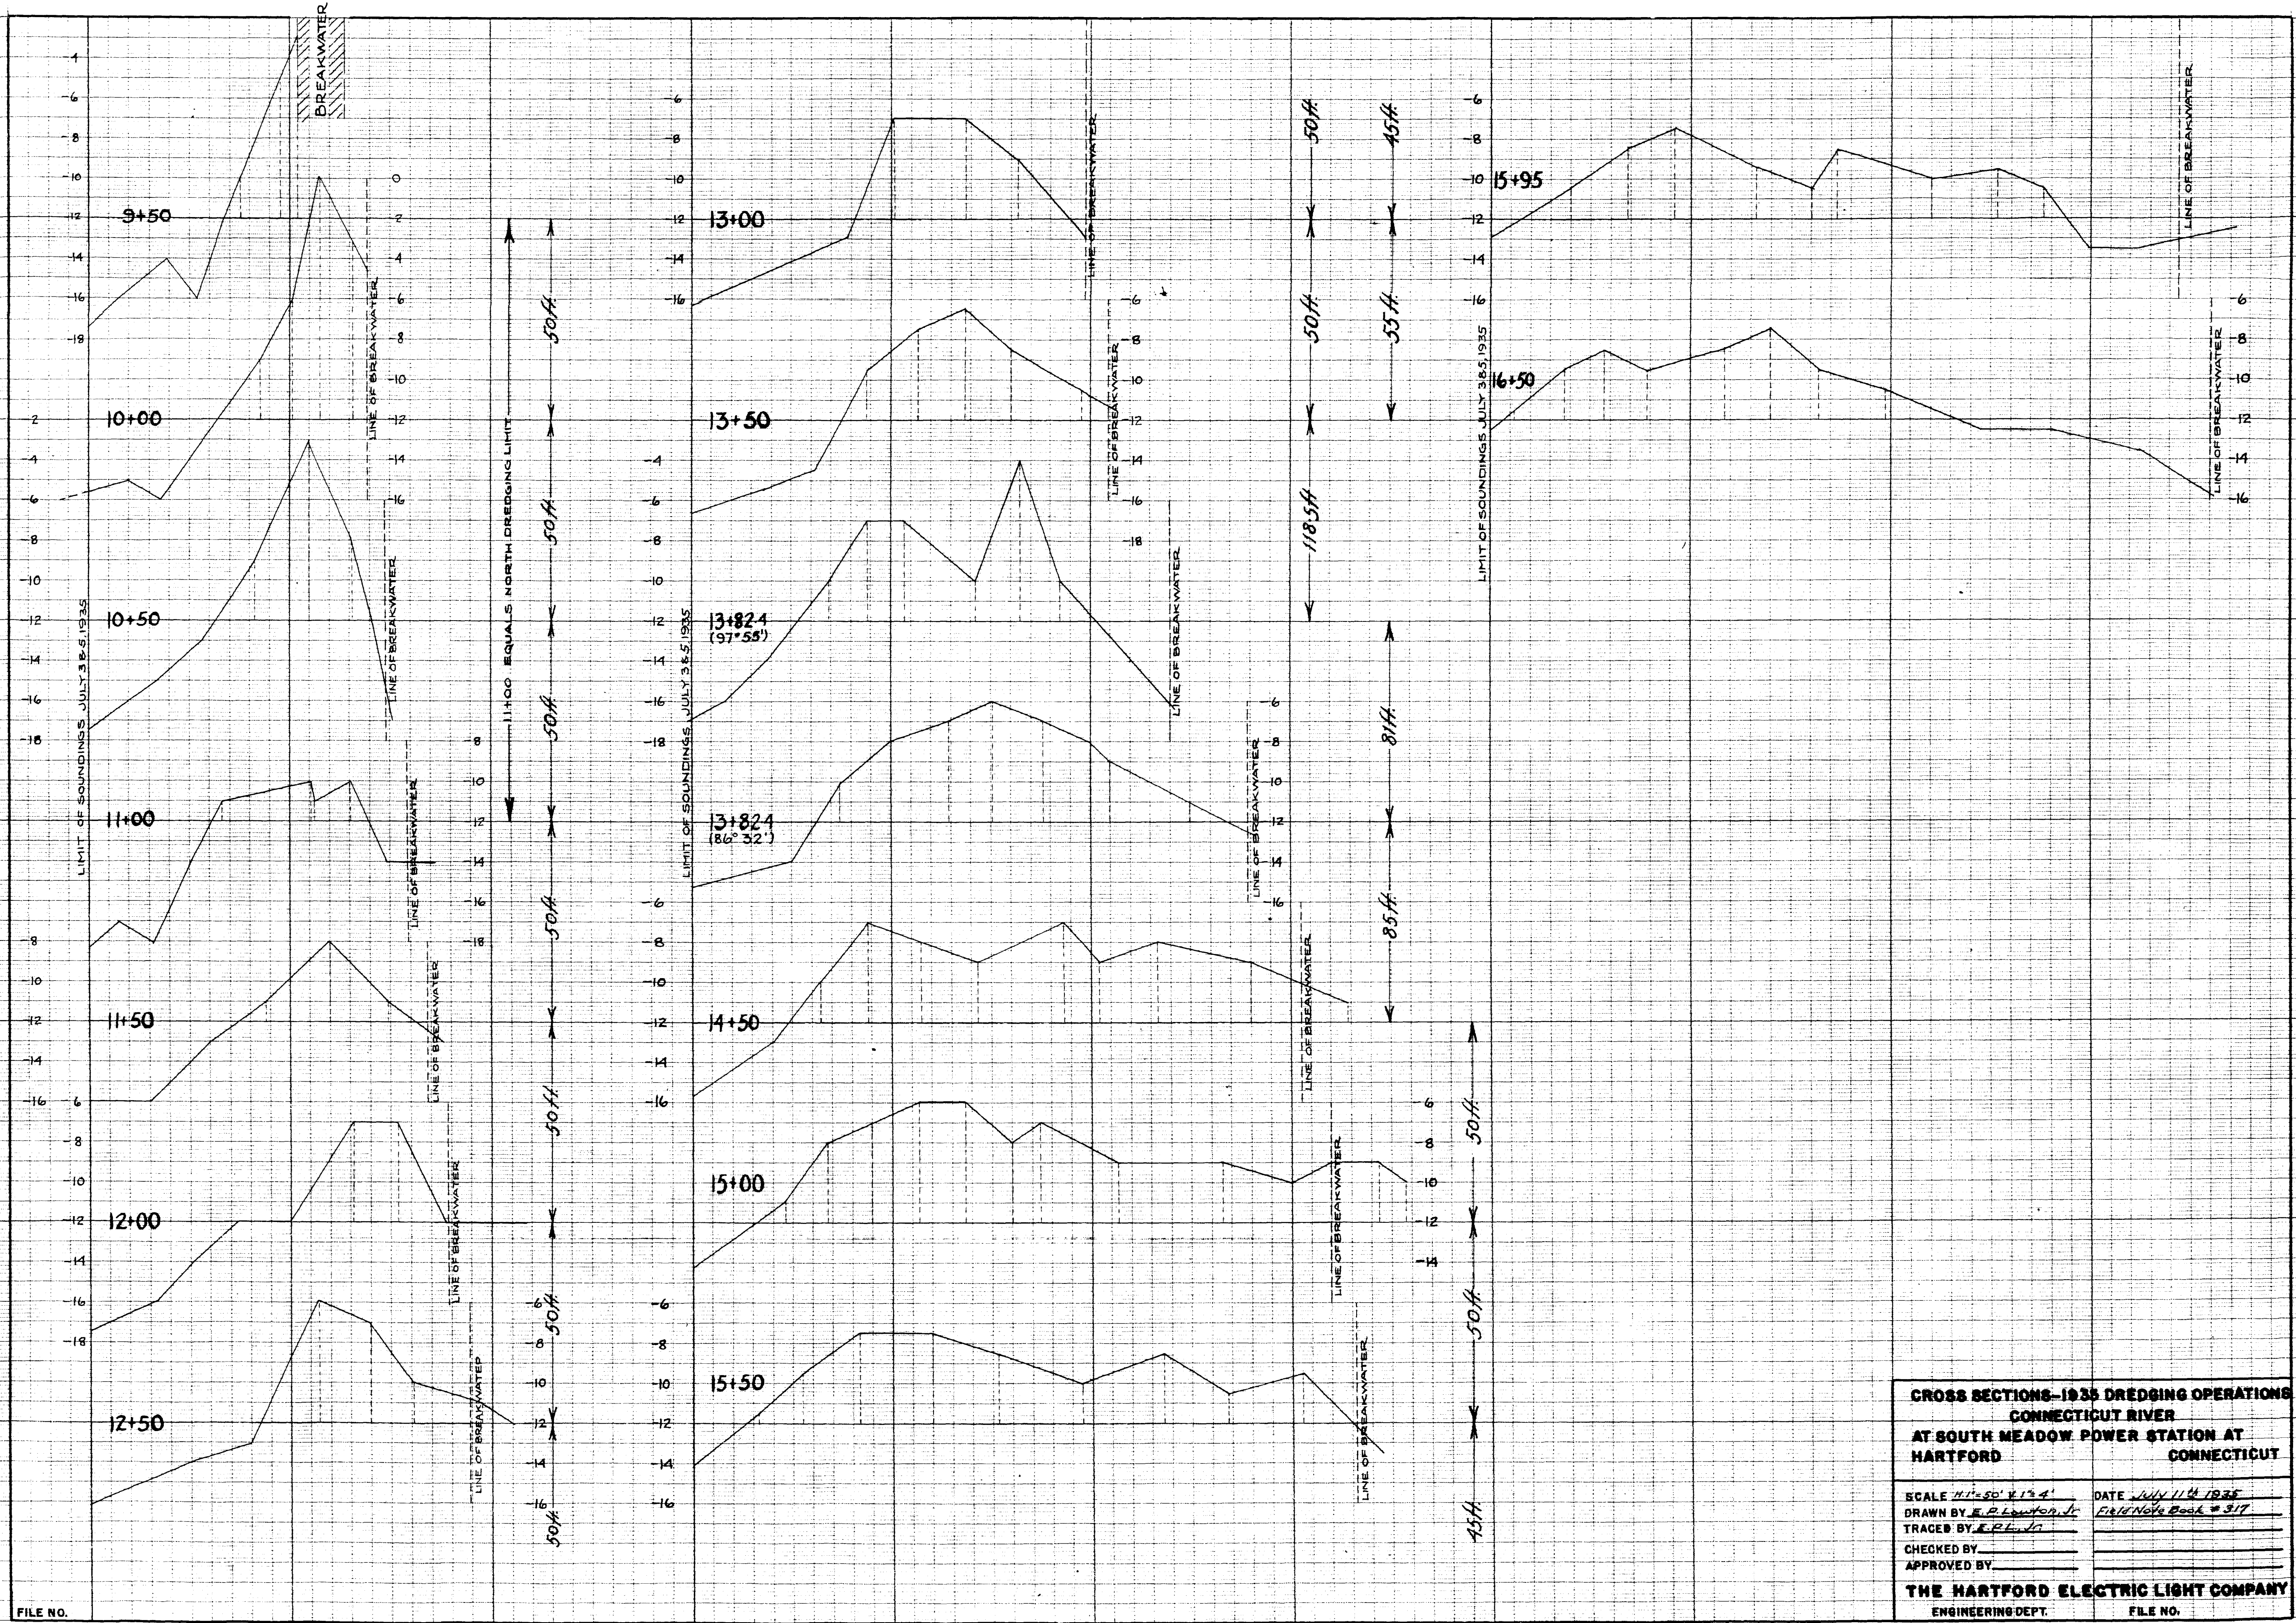

FILE NO.

CROSS SECTIONS-1935 DREDGING OPERATIONS CONNECTICUT RIVER AT SOUTH MEADOW POWER STATION AT HARTFORD CONNECTICUT	
SCALE 1"=50' V 1"=4' DRAWN BY E. P. Linton, Jr. TRACED BY E. P. Linton, Jr. CHECKED BY _____ APPROVED BY _____	DATE JULY 11 th 1935 FIELD NOTE BOOK # 317 _____ _____
THE HARTFORD ELECTRIC LIGHT COMPANY ENGINEERING DEPT. FILE NO.	

PLATE A
 36696 PROFILE CROWN
 3117408 963990P

PLATE A
 36696 PROFILE CROWN