

WARD PLACE


Scales { Hor. 1" = 40'
Vert. 1" = 4'

Sept. 1927

Elevations on new curb as set

Hillside Ave
CMS S.E. cor Ward Place

Hillside Avenue

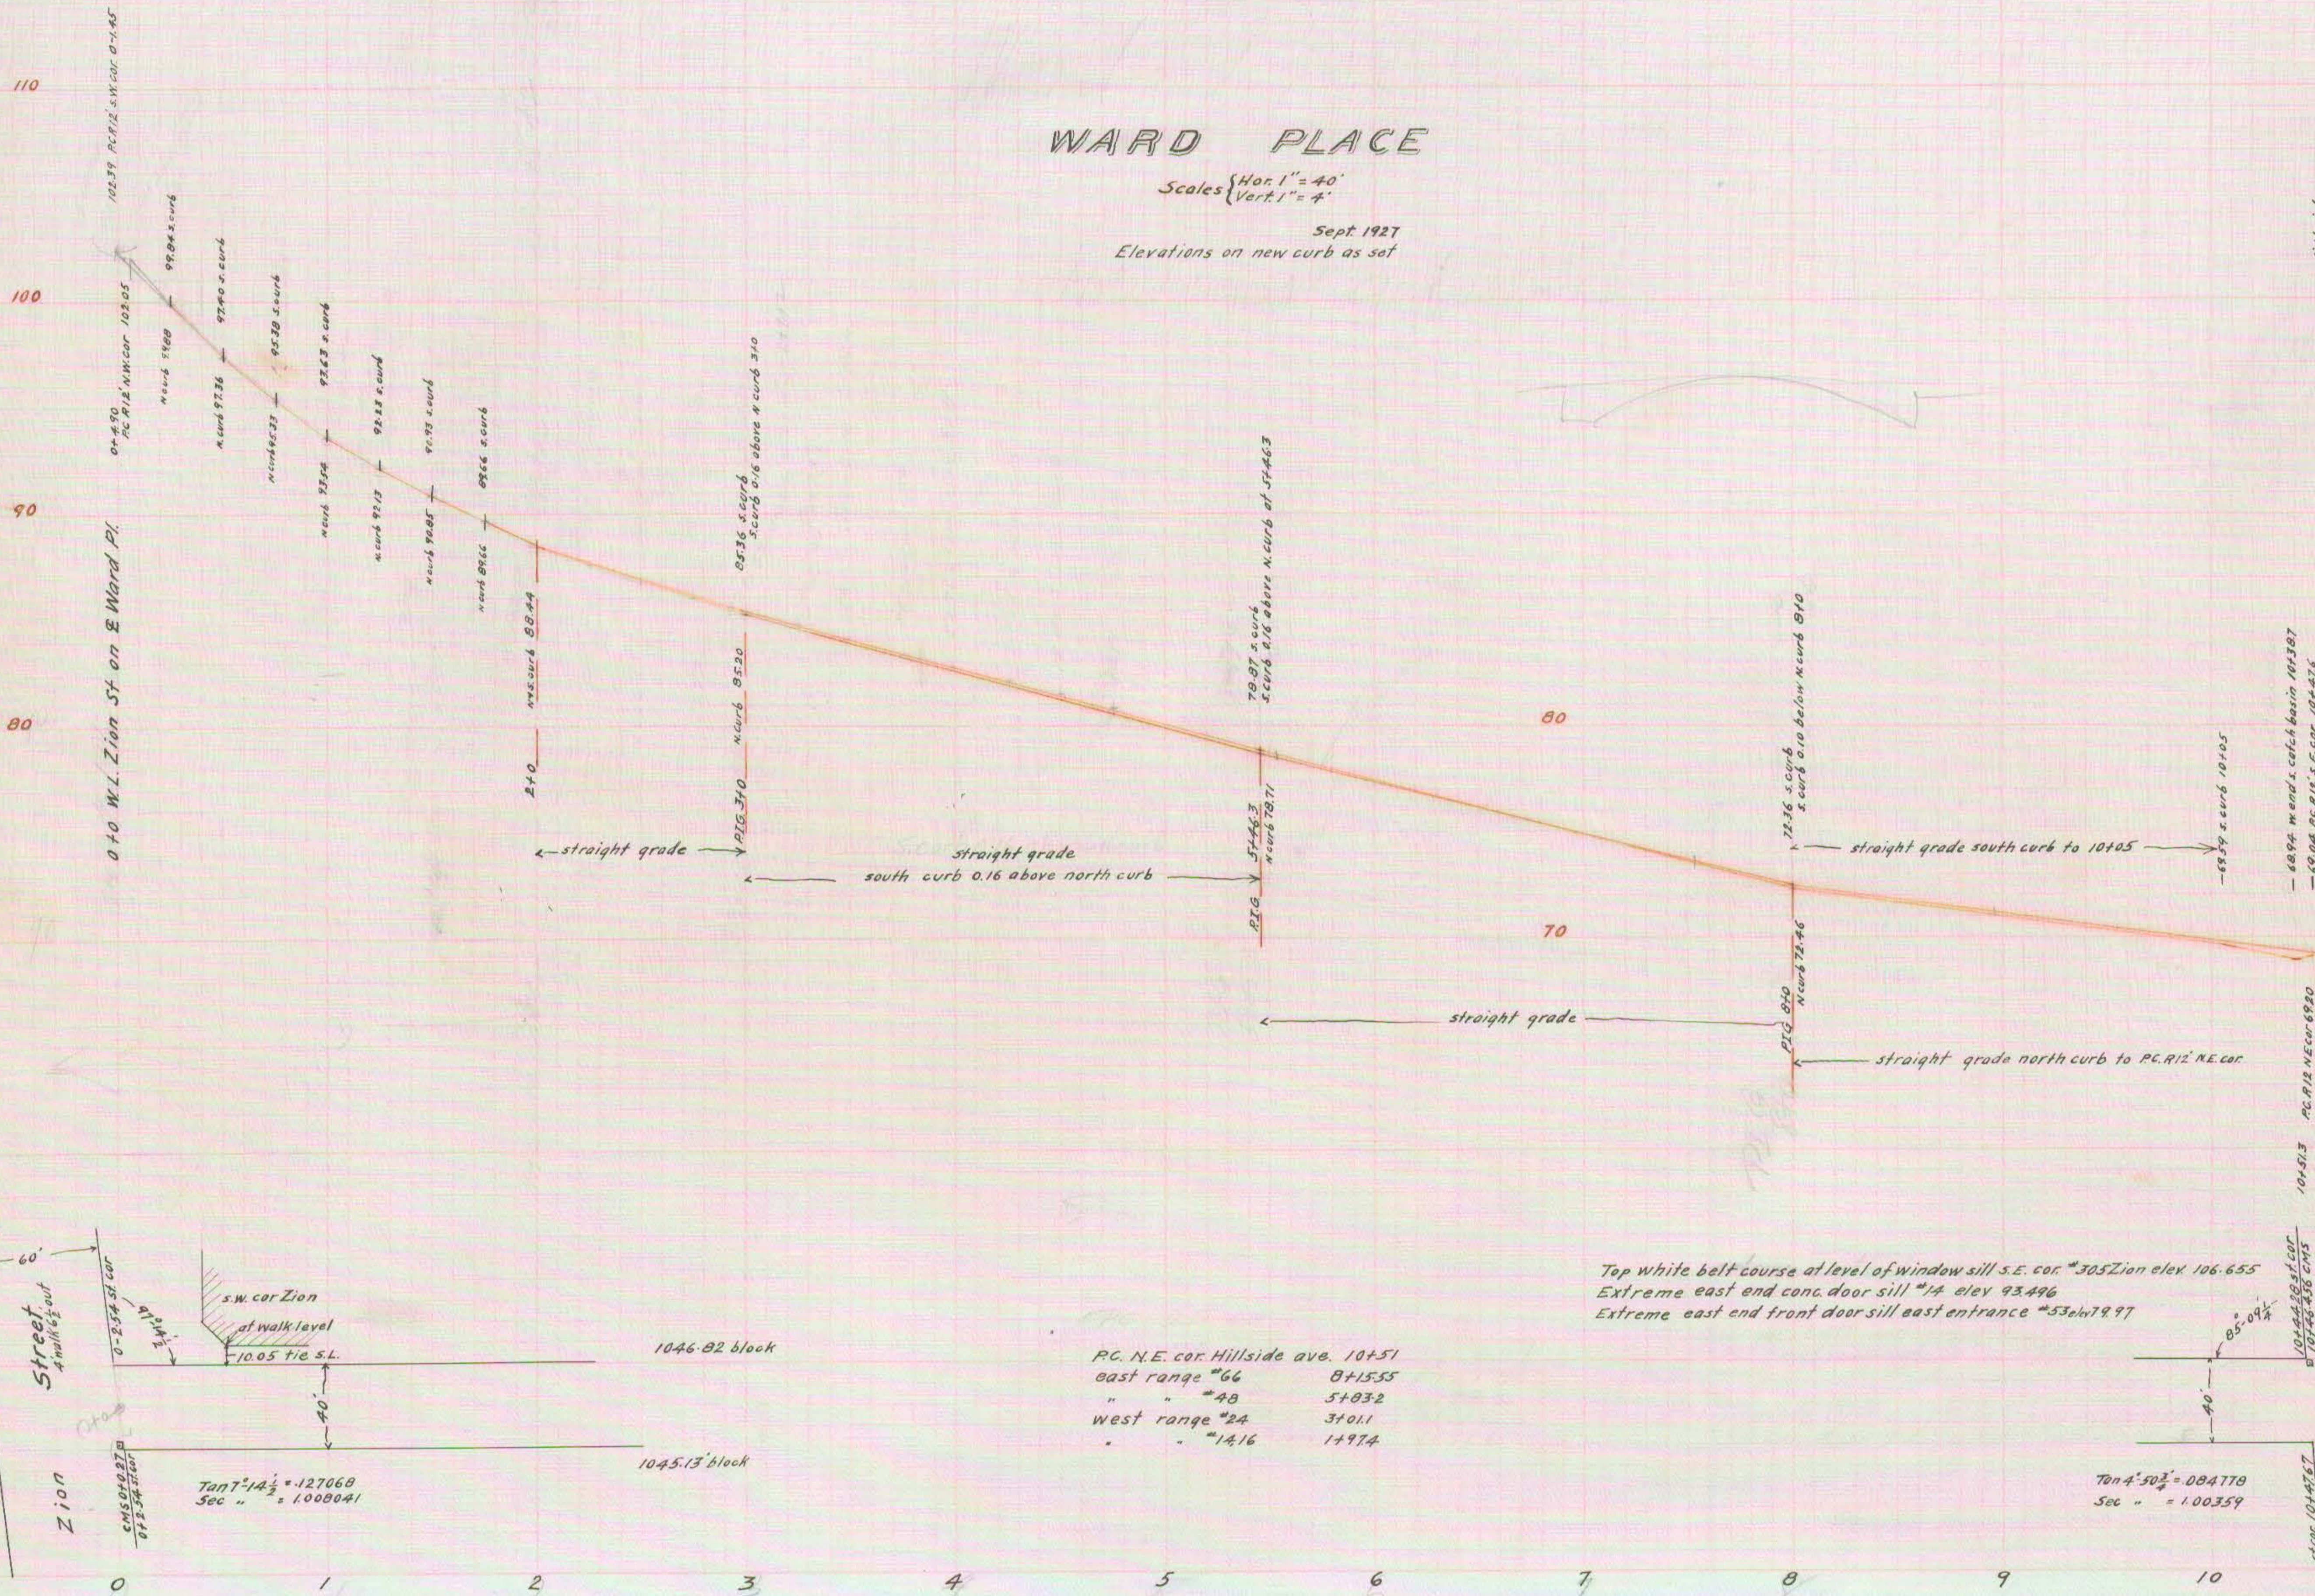

Top white belt course at level of window sill S.E. cor. #305 Zion elev 106.655
Extreme east end conc. door sill #14 elev 93.496
Extreme east end front door sill east entrance #53 elev 79.97

P.C. N.E. cor Hillside ave. 10+51
east range #66 8+15.55
" " #48 5+03.2
west range #24 3+01.1
" " #14.16 1+97.4

Tan 4° 50' = 0.084778
Sec " = 1.00359

15' curb
4' walk 3' back of curb

