


Scale Hor. 1" = 20'
Ver. 1" = 2'


See Note 53 p141
Note Grade published is for proposed widening of Walnut St. 17213

Note Grade published is for proposed widening of Walnut St. 1210

Daybook No. 06357. P134

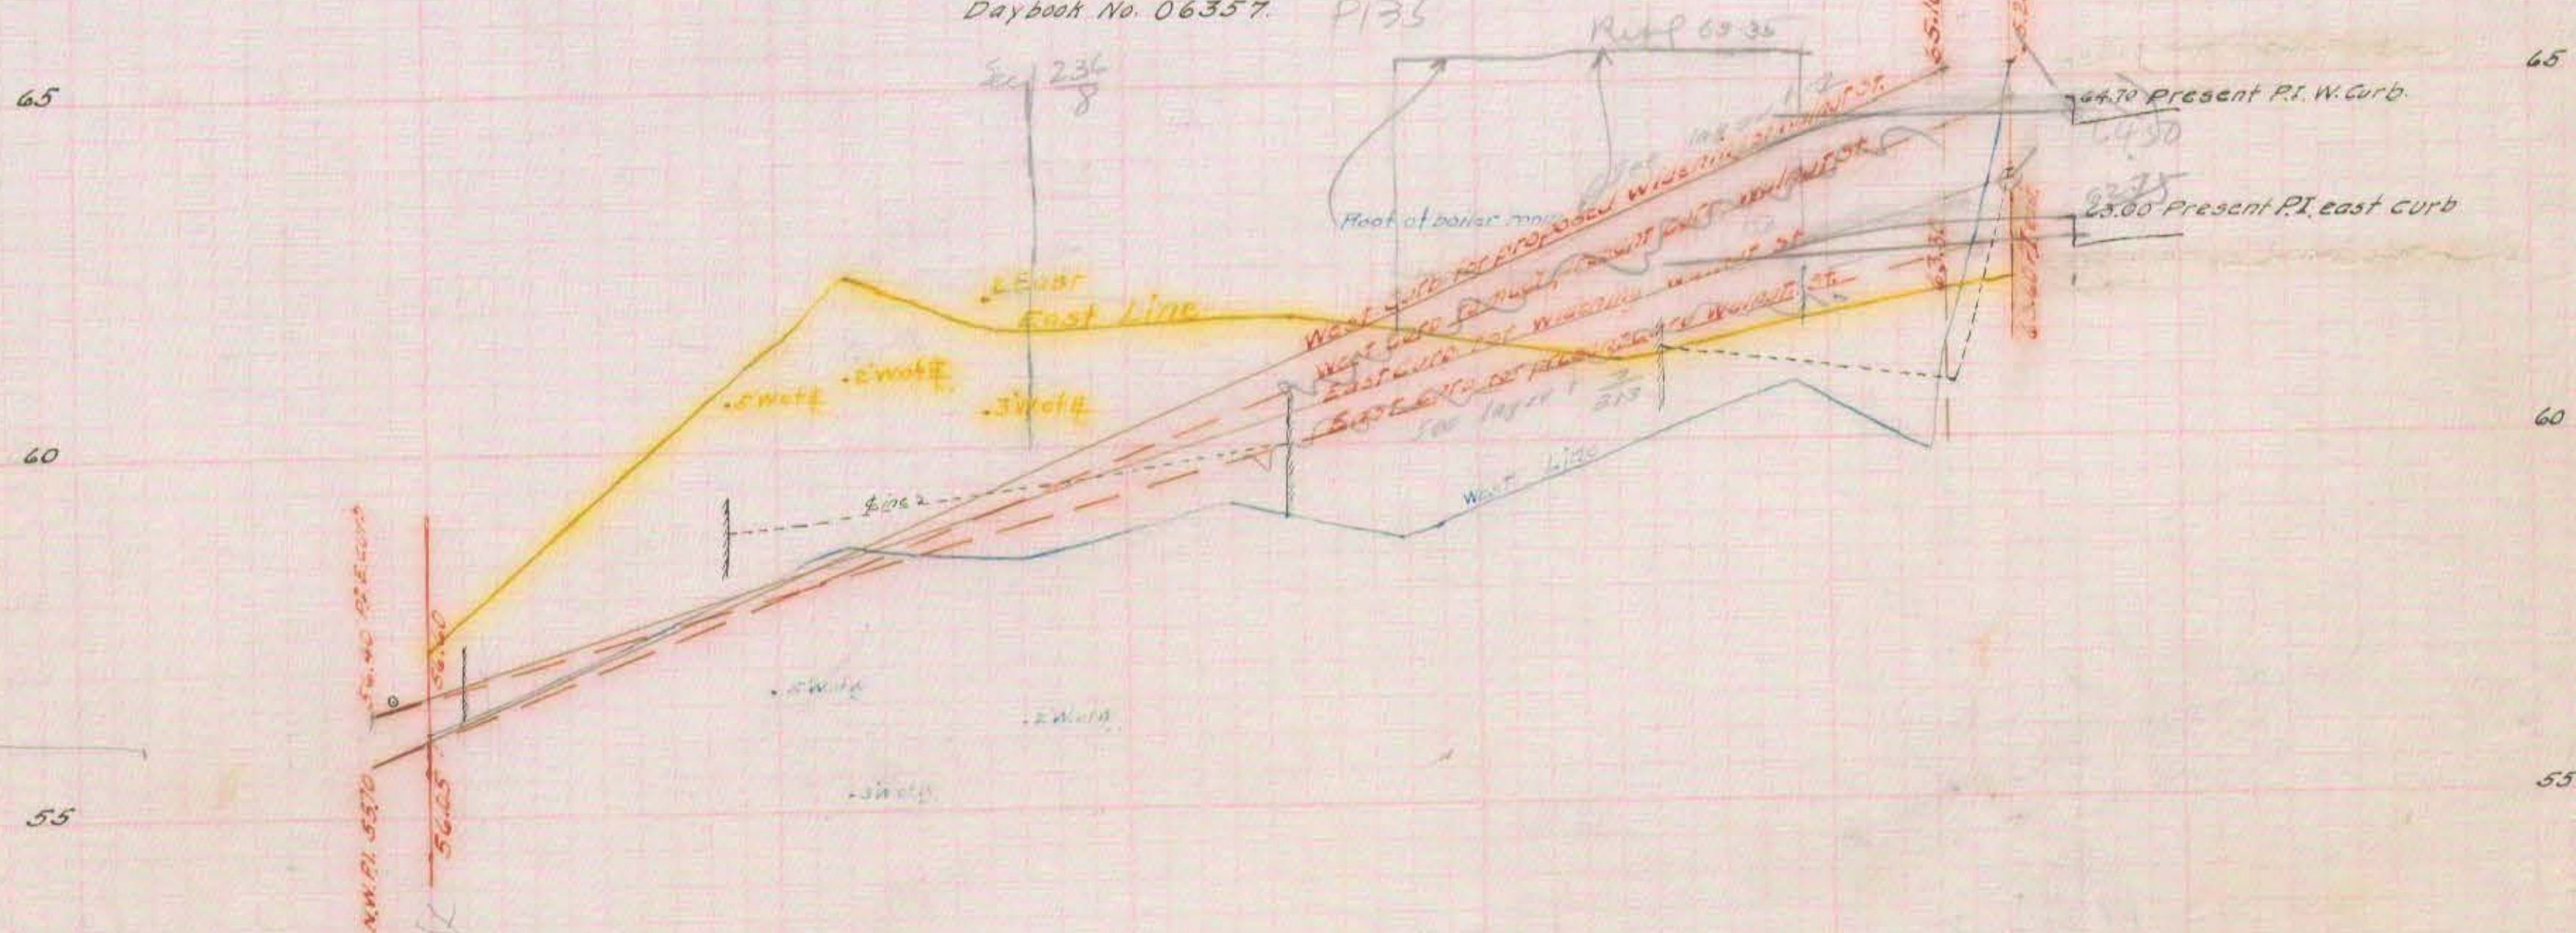

Conn Beef Co
214 and Small Door
57.49

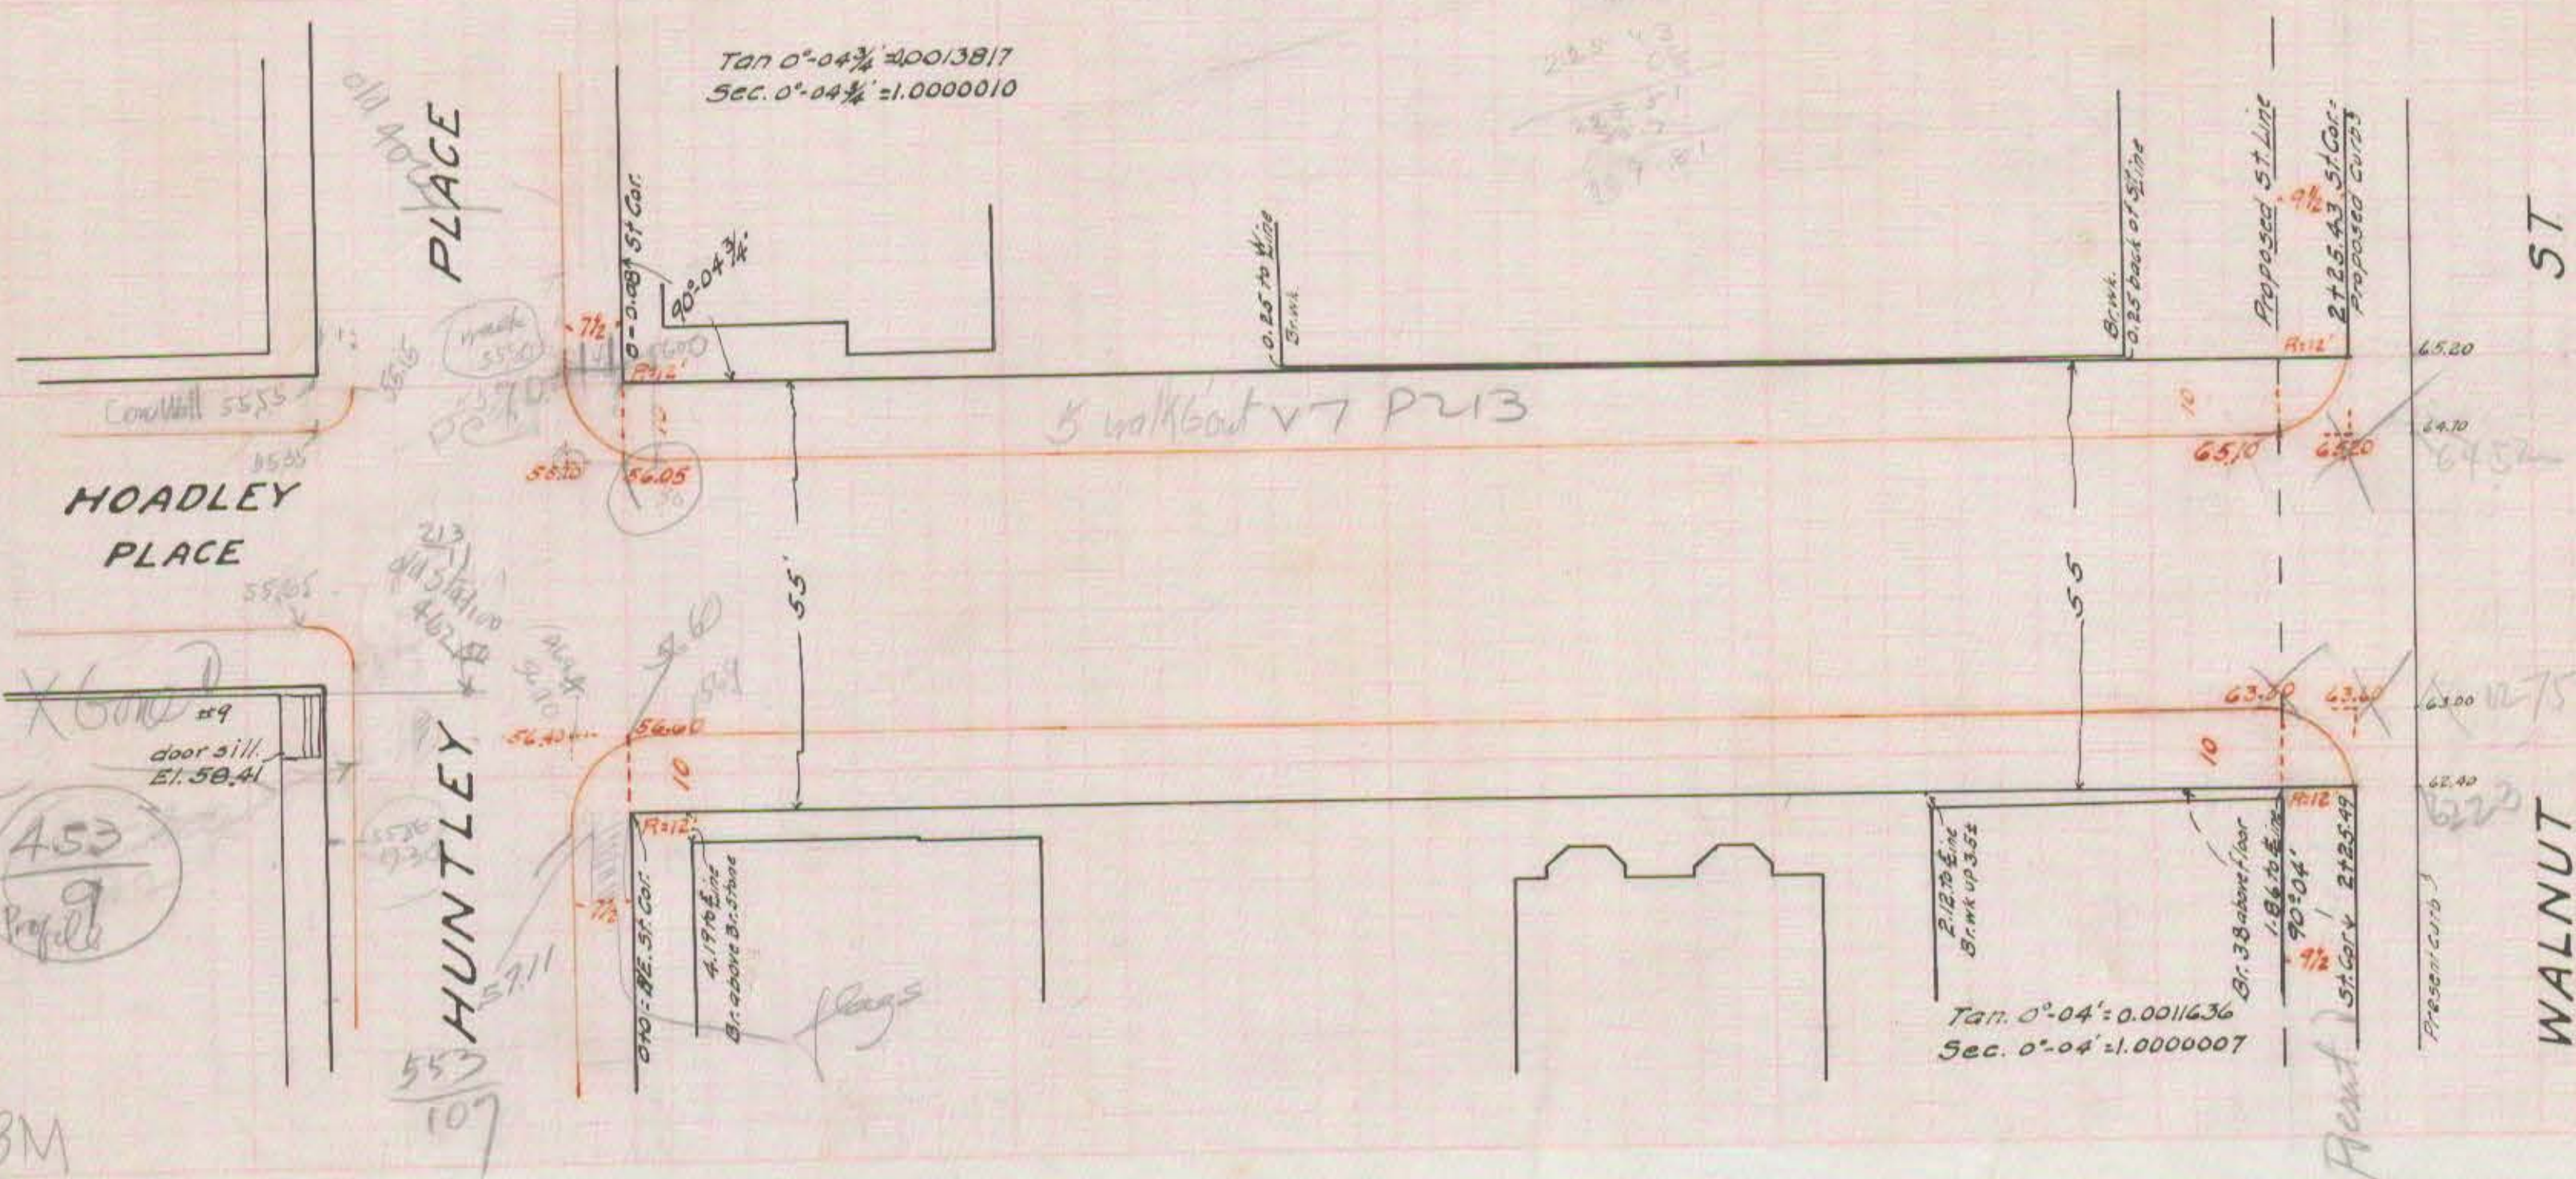

Note 553
P108-P141 BM