


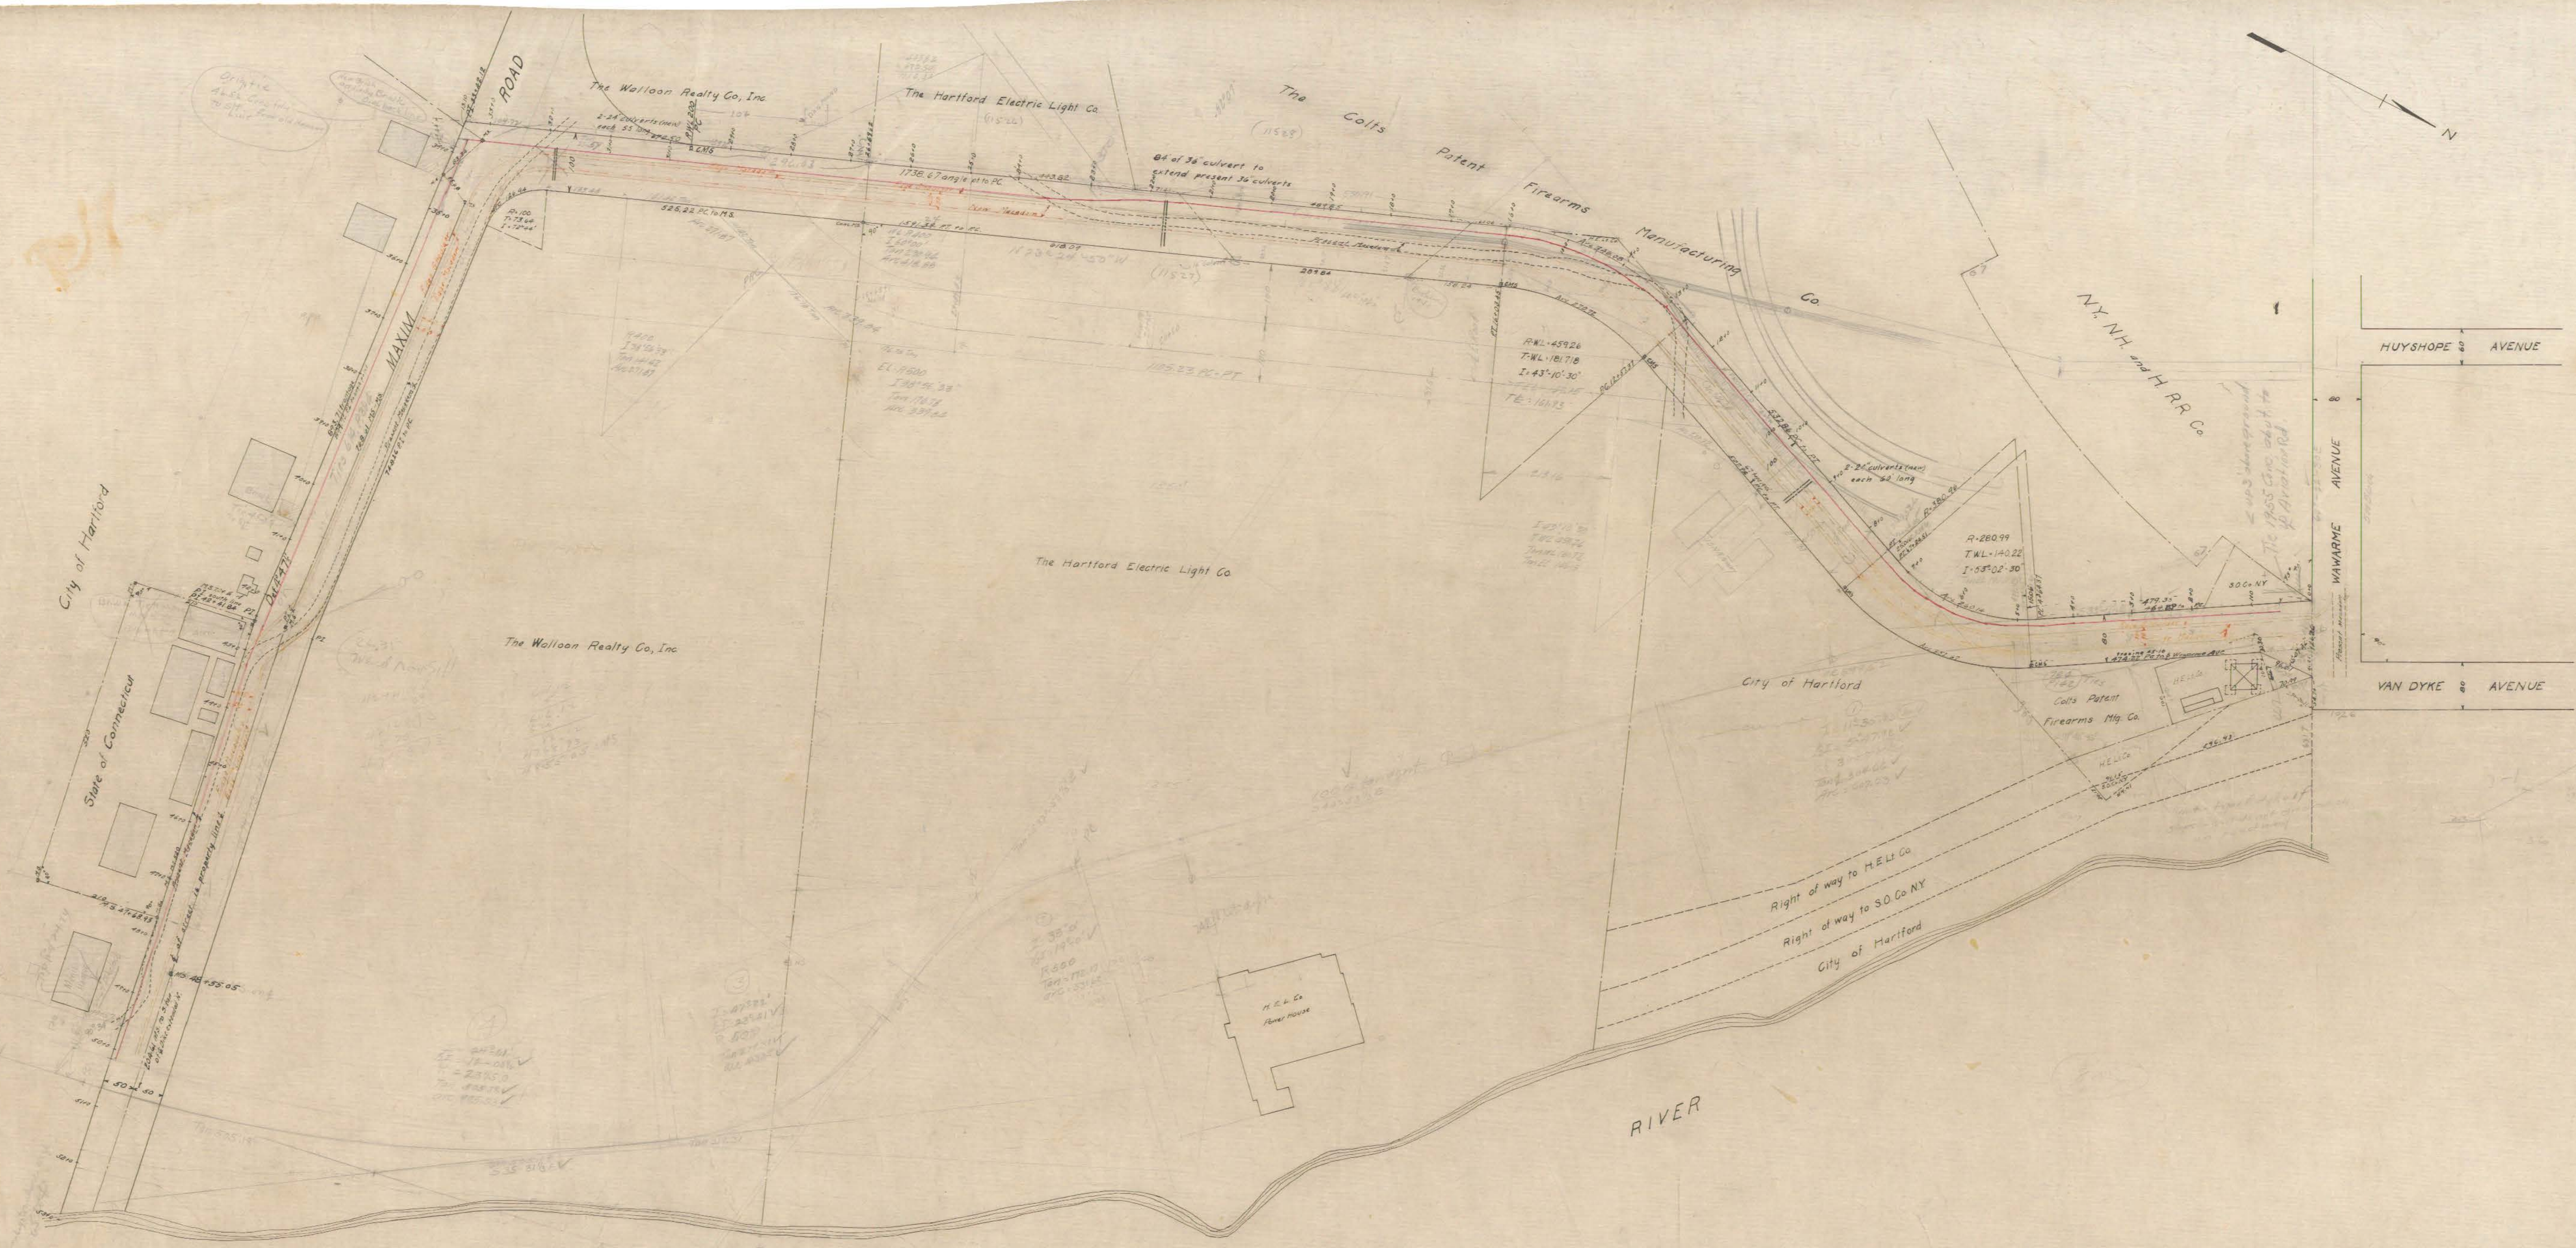

Water main.
See N.B. 353 p. 17 & 304 p. 112.
AVIATION ROAD
DATE: June 1922
NO. 306, P. 69
R.N. Clark
Scale: 1" = 100'