


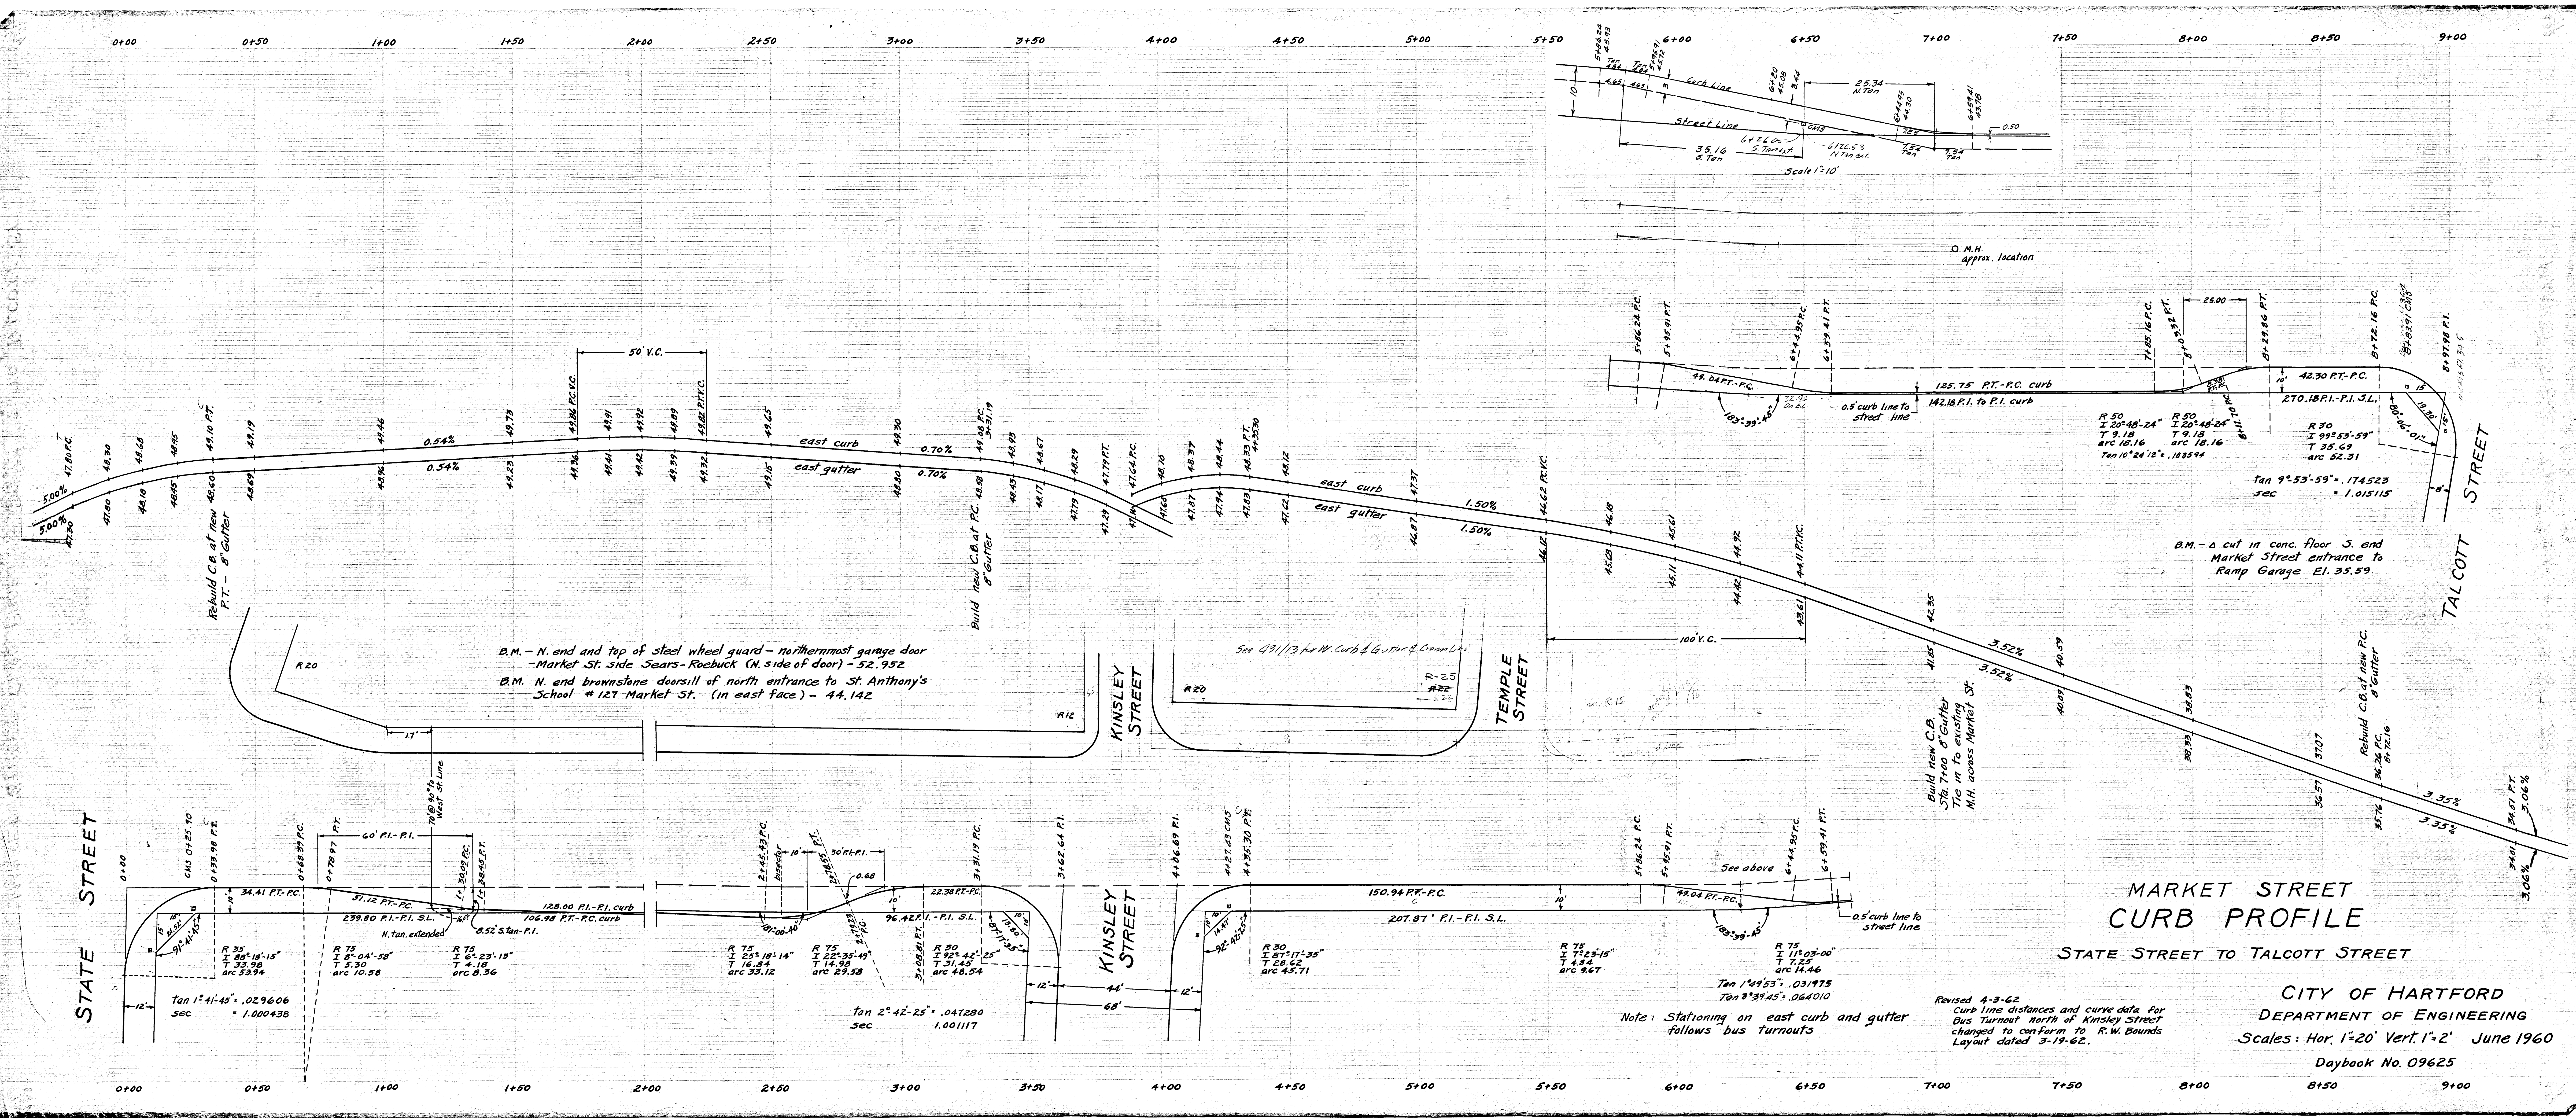

MARKET STREET
CURB PROFILE

STATE STREET TO TALCOTT STREET

CITY OF HARTFORD
DEPARTMENT OF ENGINEERING
Scales: Hor. 1"=20' Vert. 1"=2' June 1960

Daybook No. 09625

Note: Stationing on east curb and gutter follows bus turnouts

Revised 4-3-62
Curb line distances and curve data for Bus Turnout north of Kinsley Street changed to conform to R.W. Bounds Layout dated 3-19-62.