

ENGINE MEASURED
MAY 1
1936

ENGINE MEASURED
MAY 1
1936


RIB-Arc 2932
I 93-143
Front of walk - up 0.06

N.W. Cor. Foster & Linnmoore
April 1936
Scale 1"=10'
25

E. Cor. Foster
11-27/0

NE

N. Cor. Linn

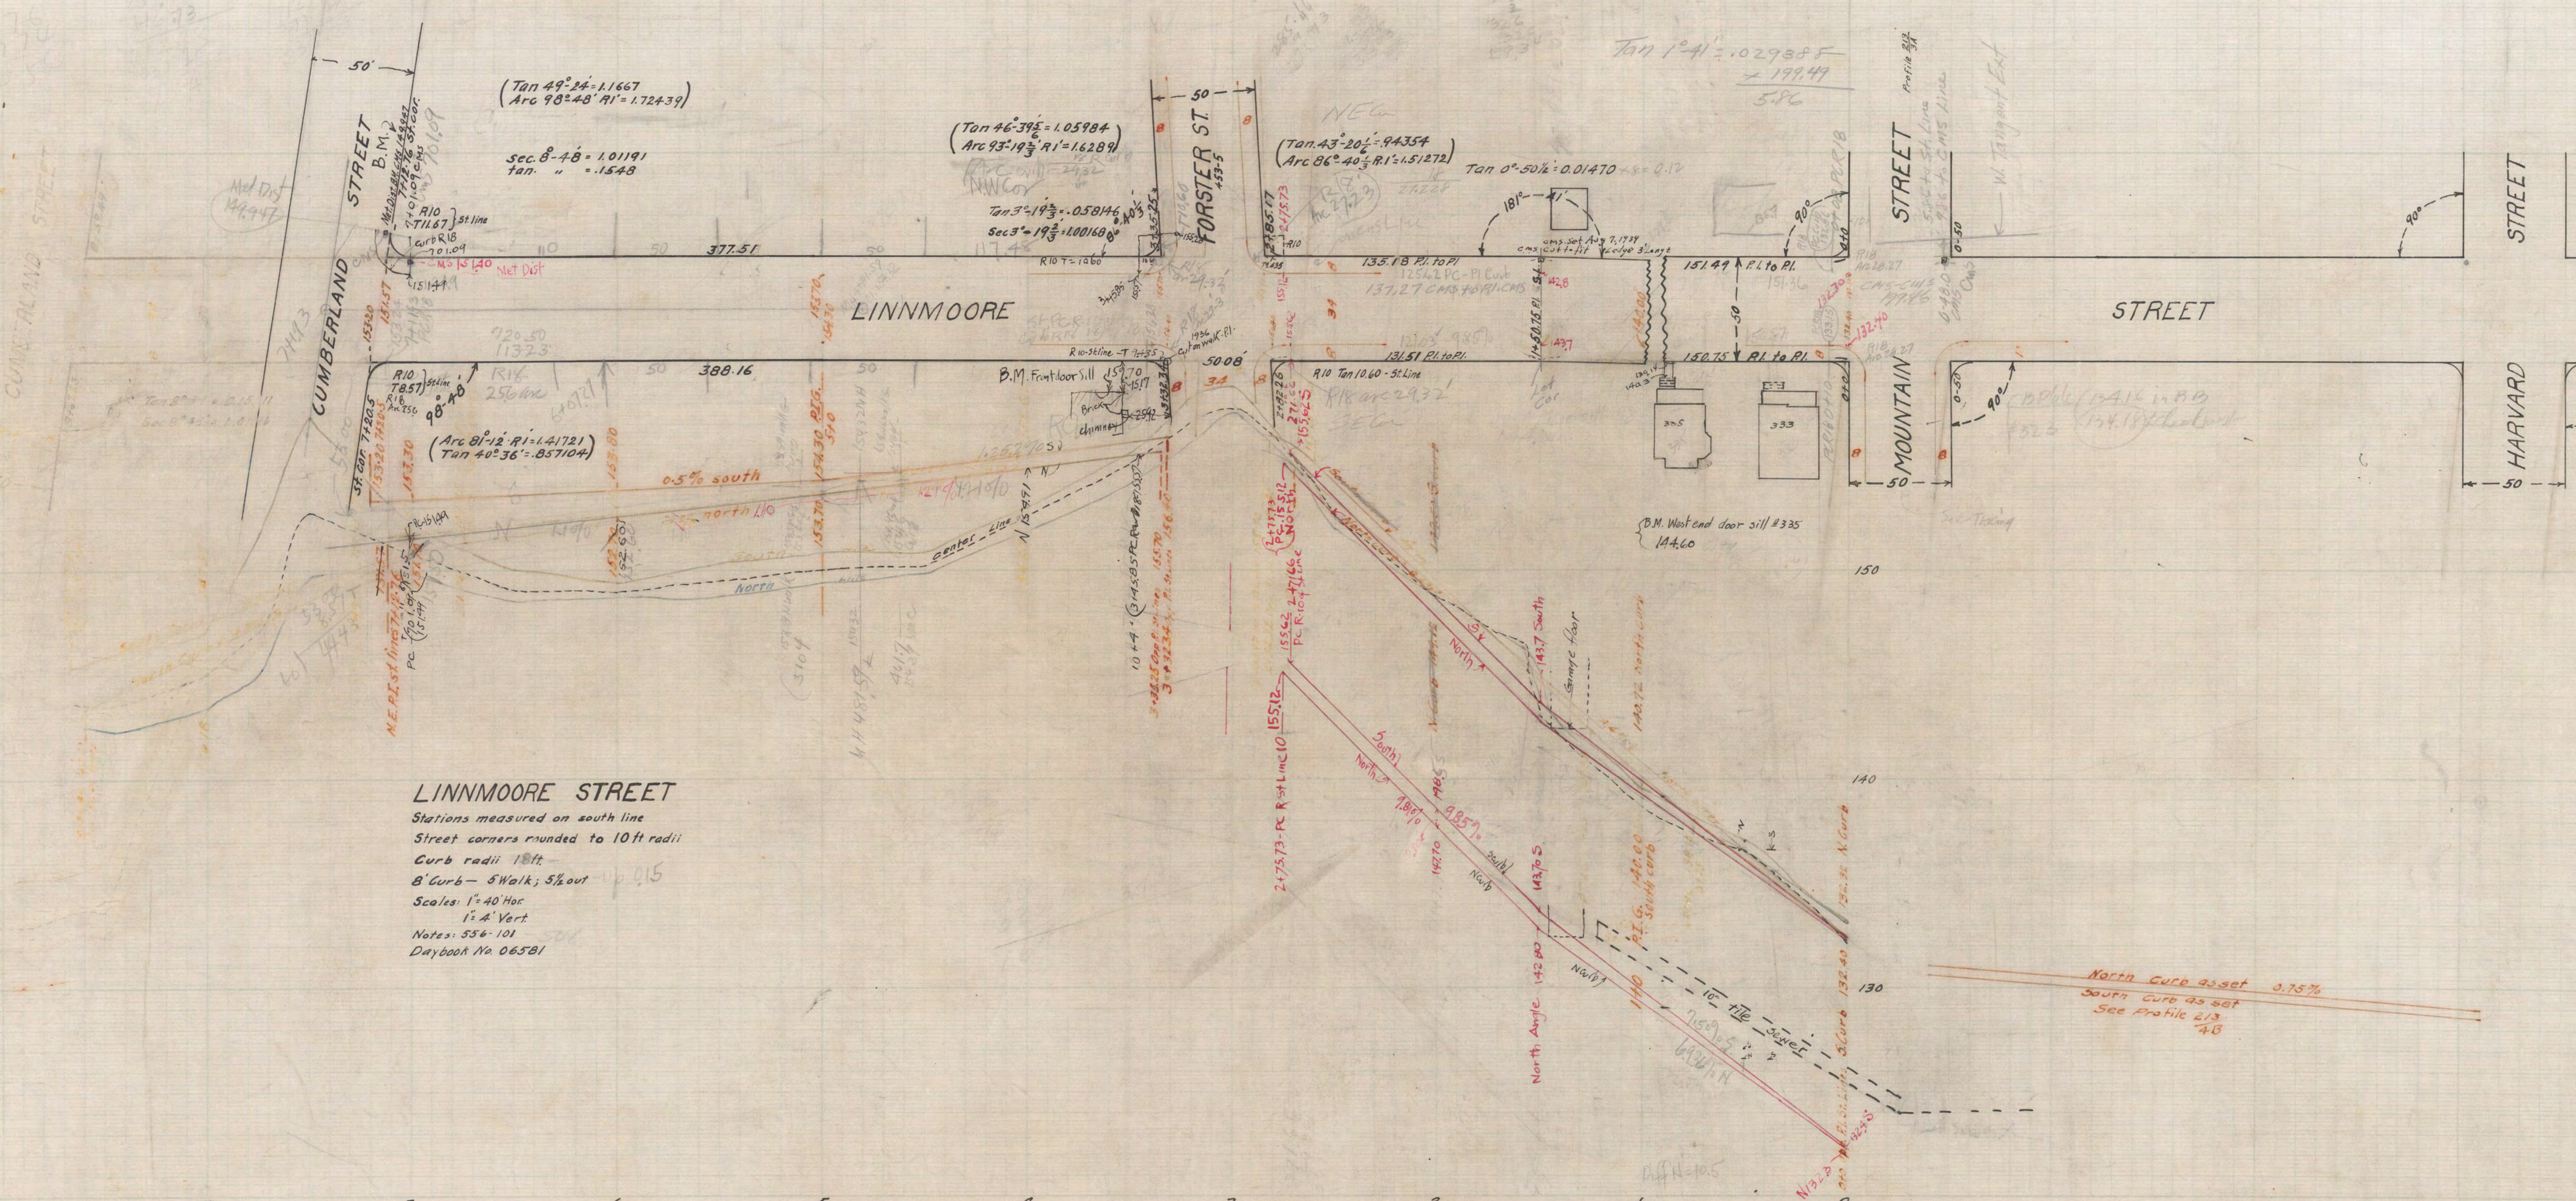

LINNMOORE STREET
Stations measured on south line
Street corners rounded to 10 ft radii
Curb radii 18 ft
8' Curb - 5' Walk; 5' out
Scales: 1"=40' Hor
1"=4' Vert
Notes: 556-101
Daybook No. 06581

Met. Dist. B.M. - N. end top G.I. drain pipe
N. face #90-92 Roger St
E.I. 125.493

Profile 124-10

See Profile 213
4.8

144.50
144.50
144.50