
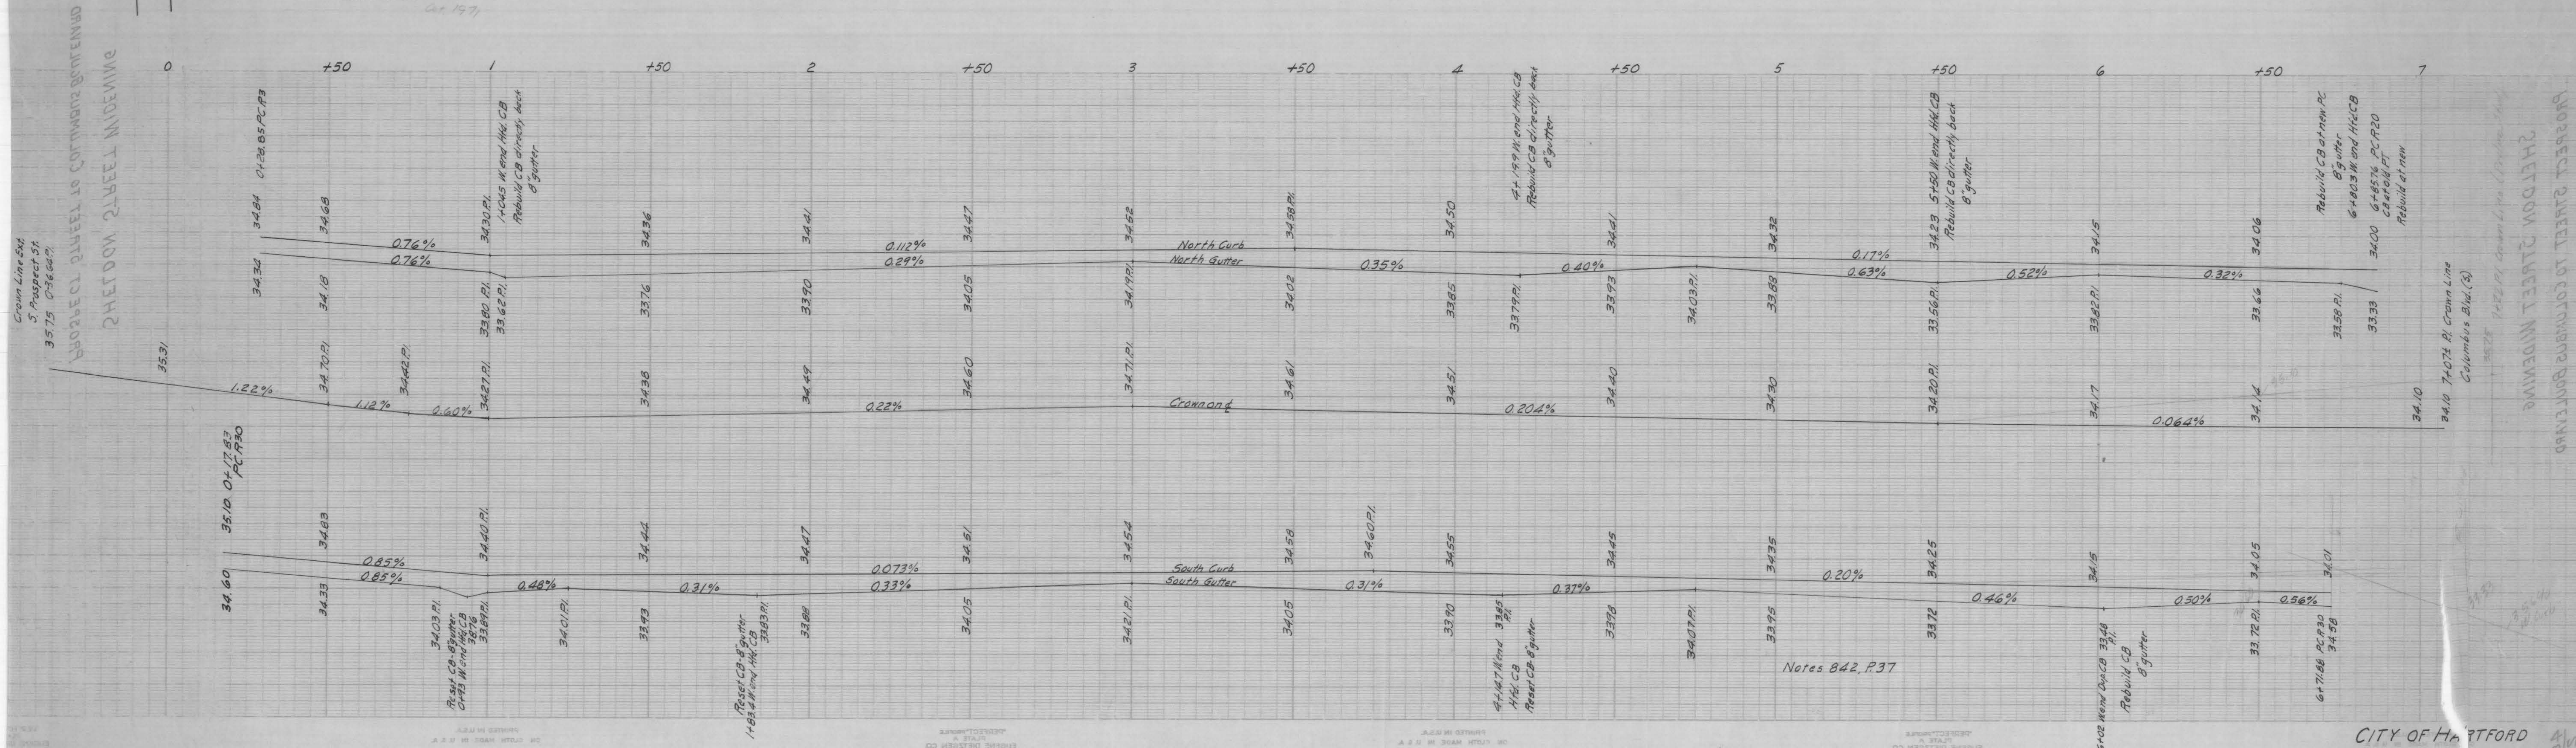
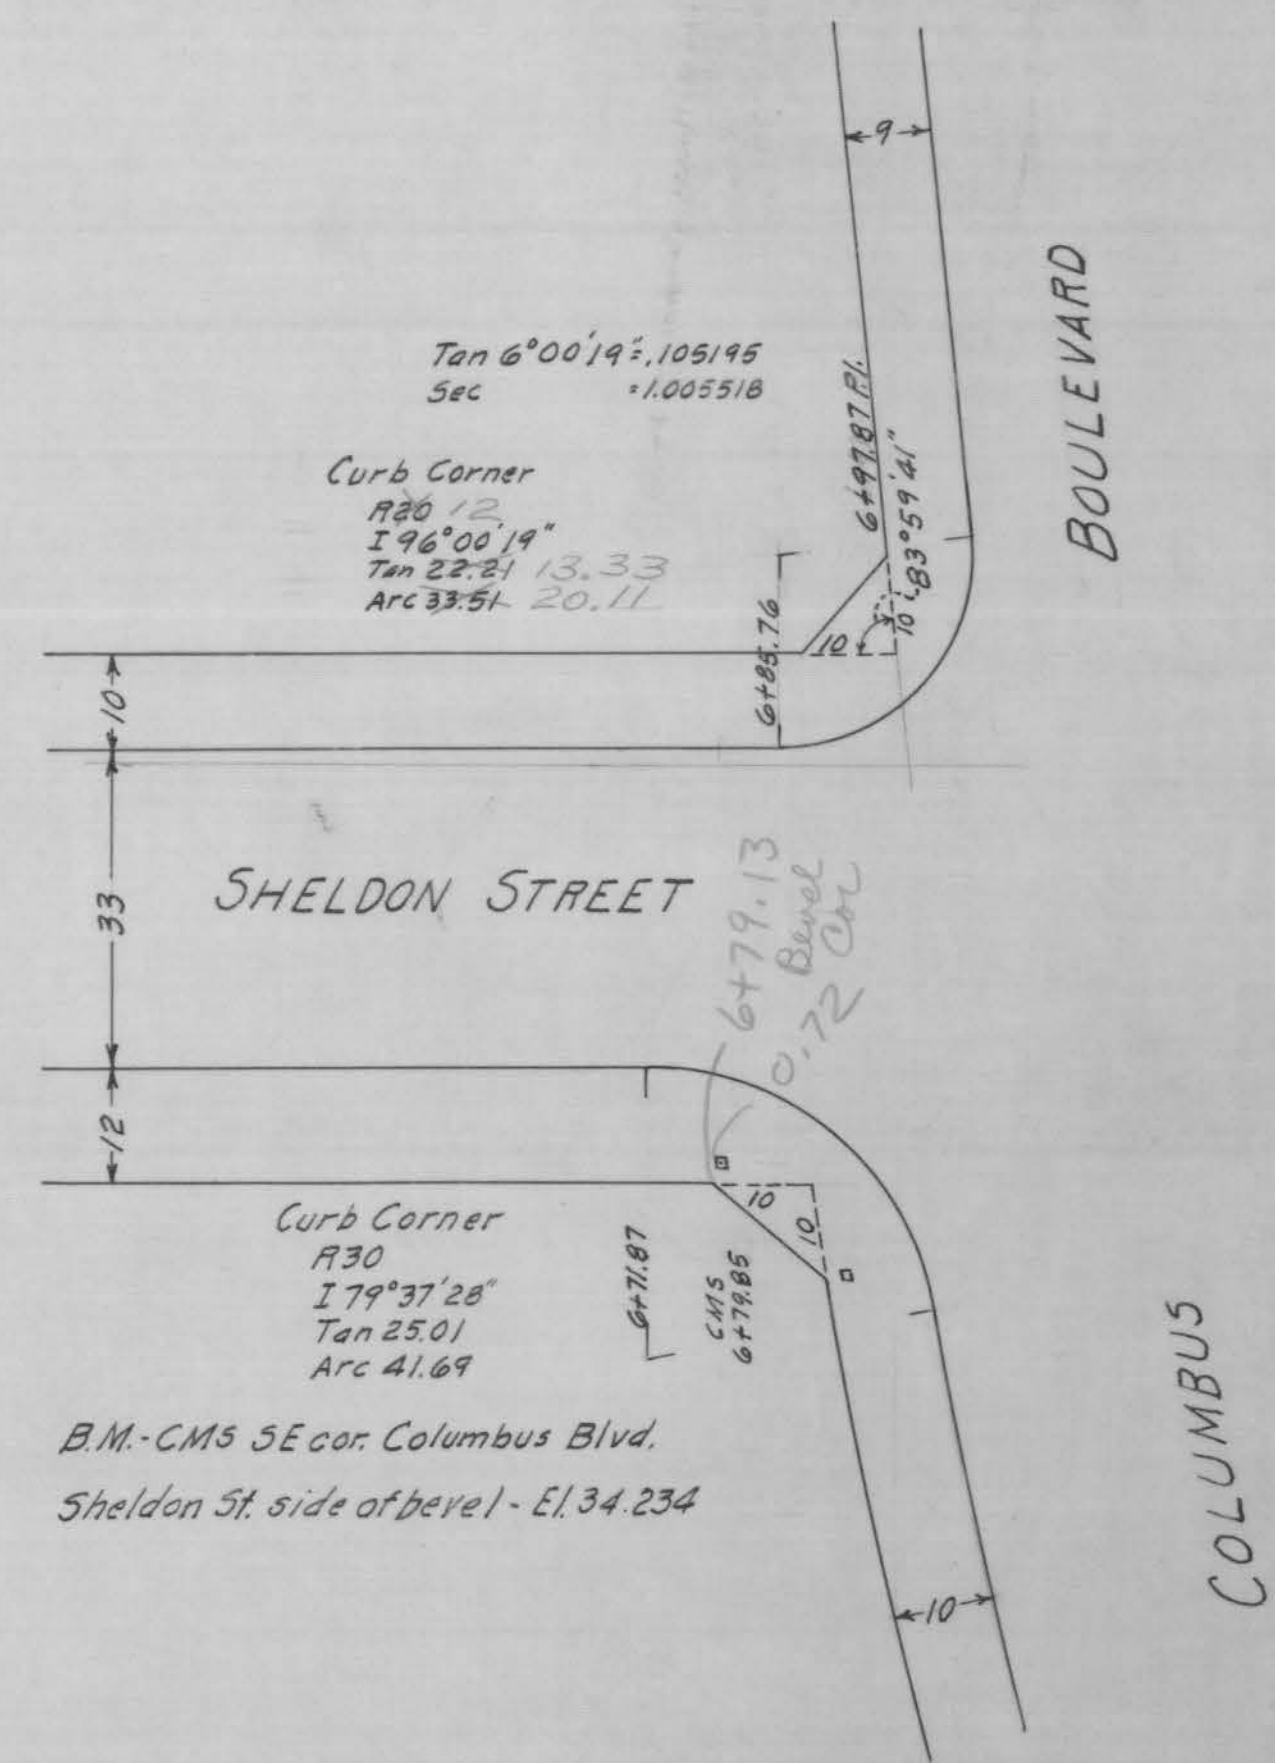


10/10/4

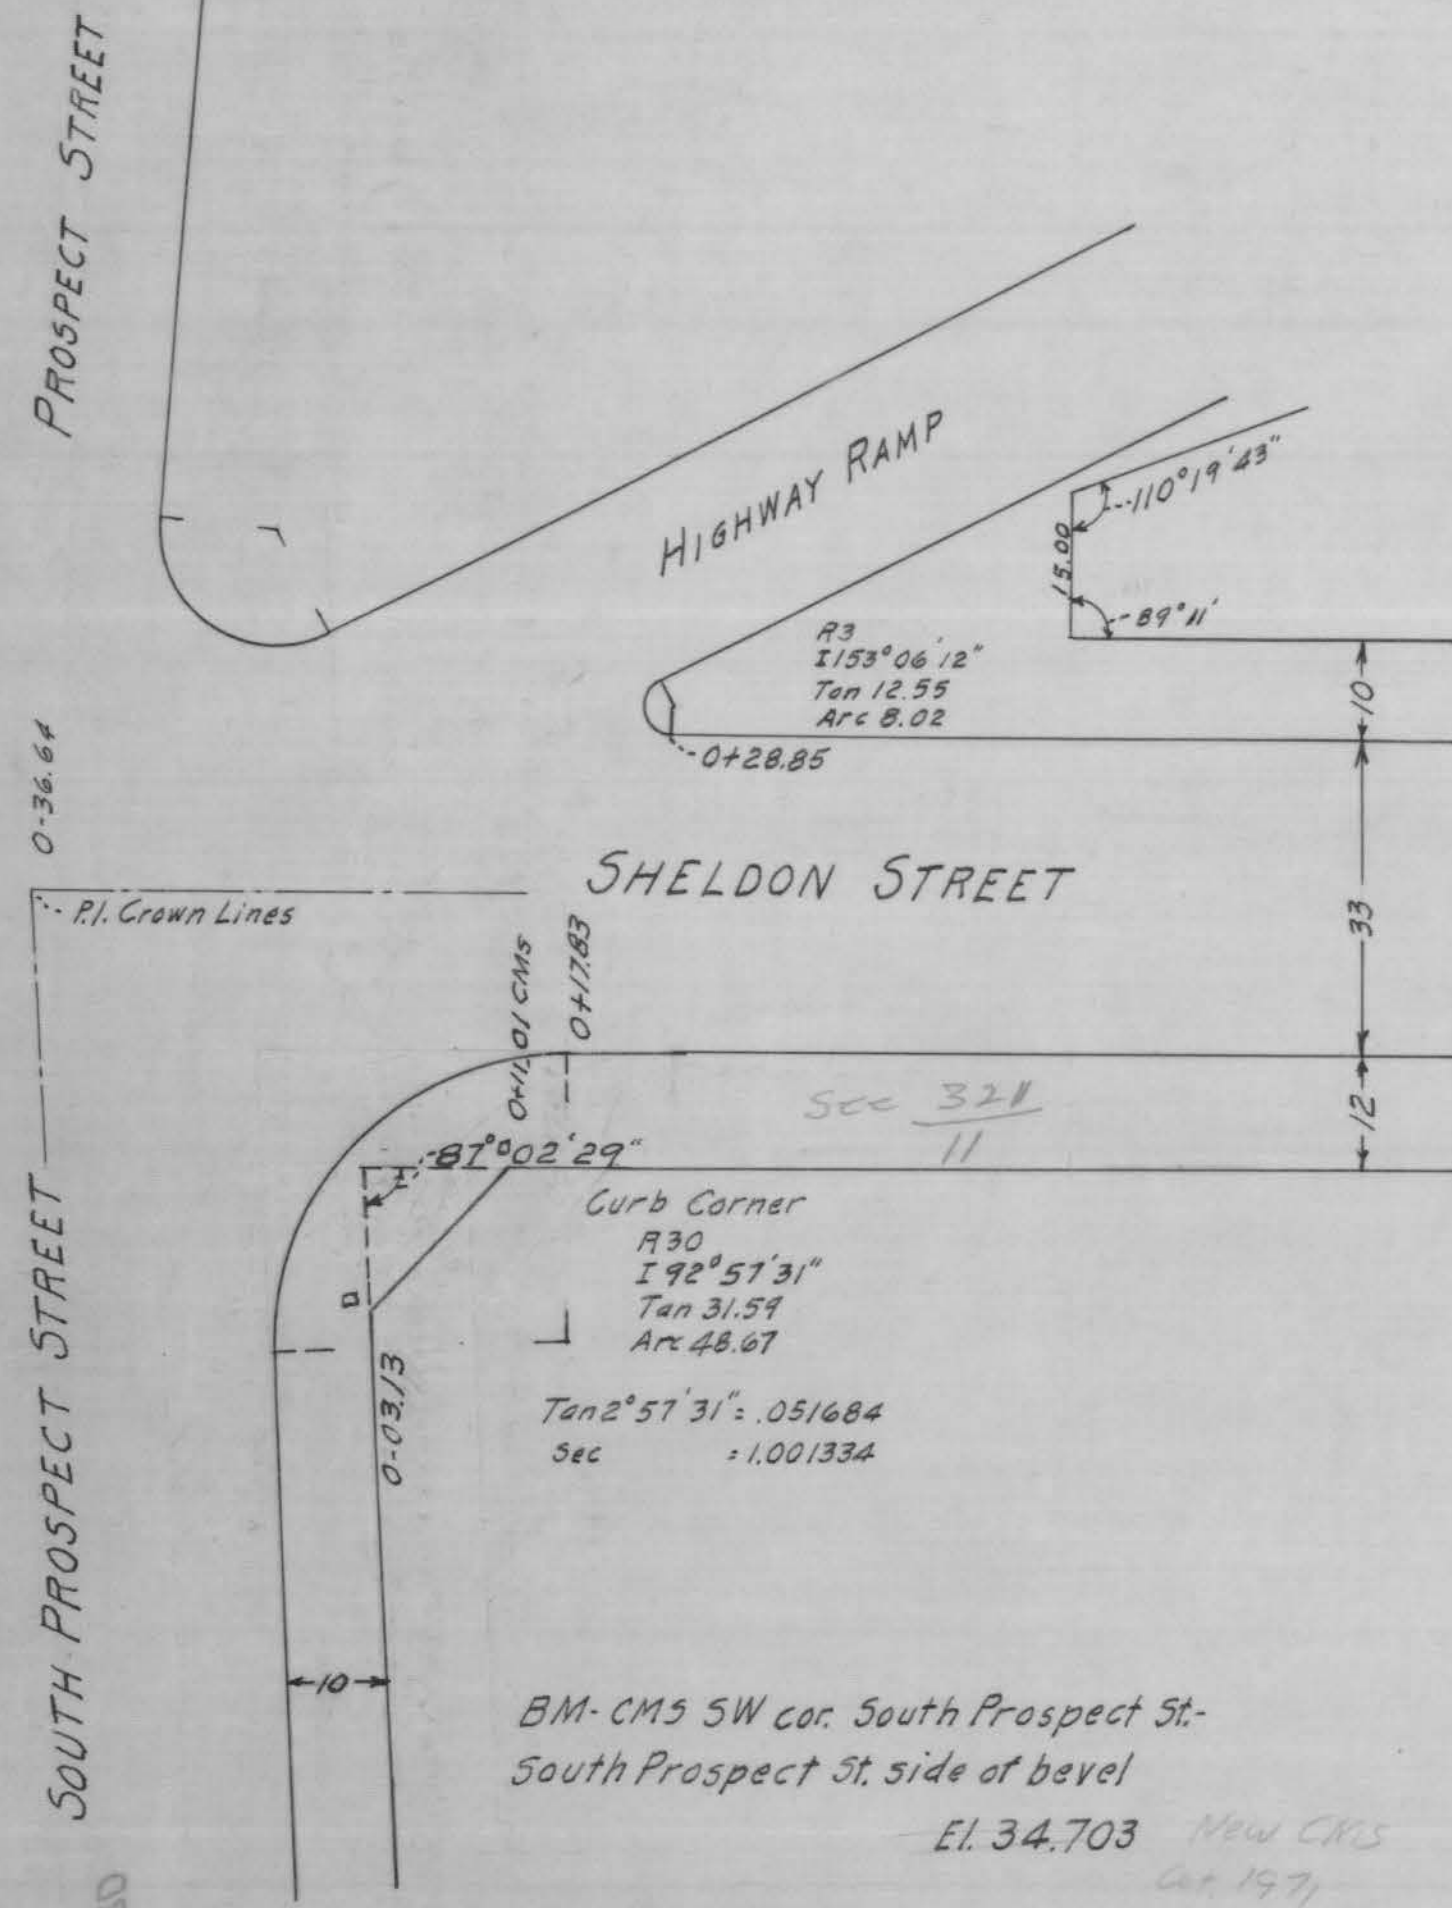

10/10/4

10/10/4