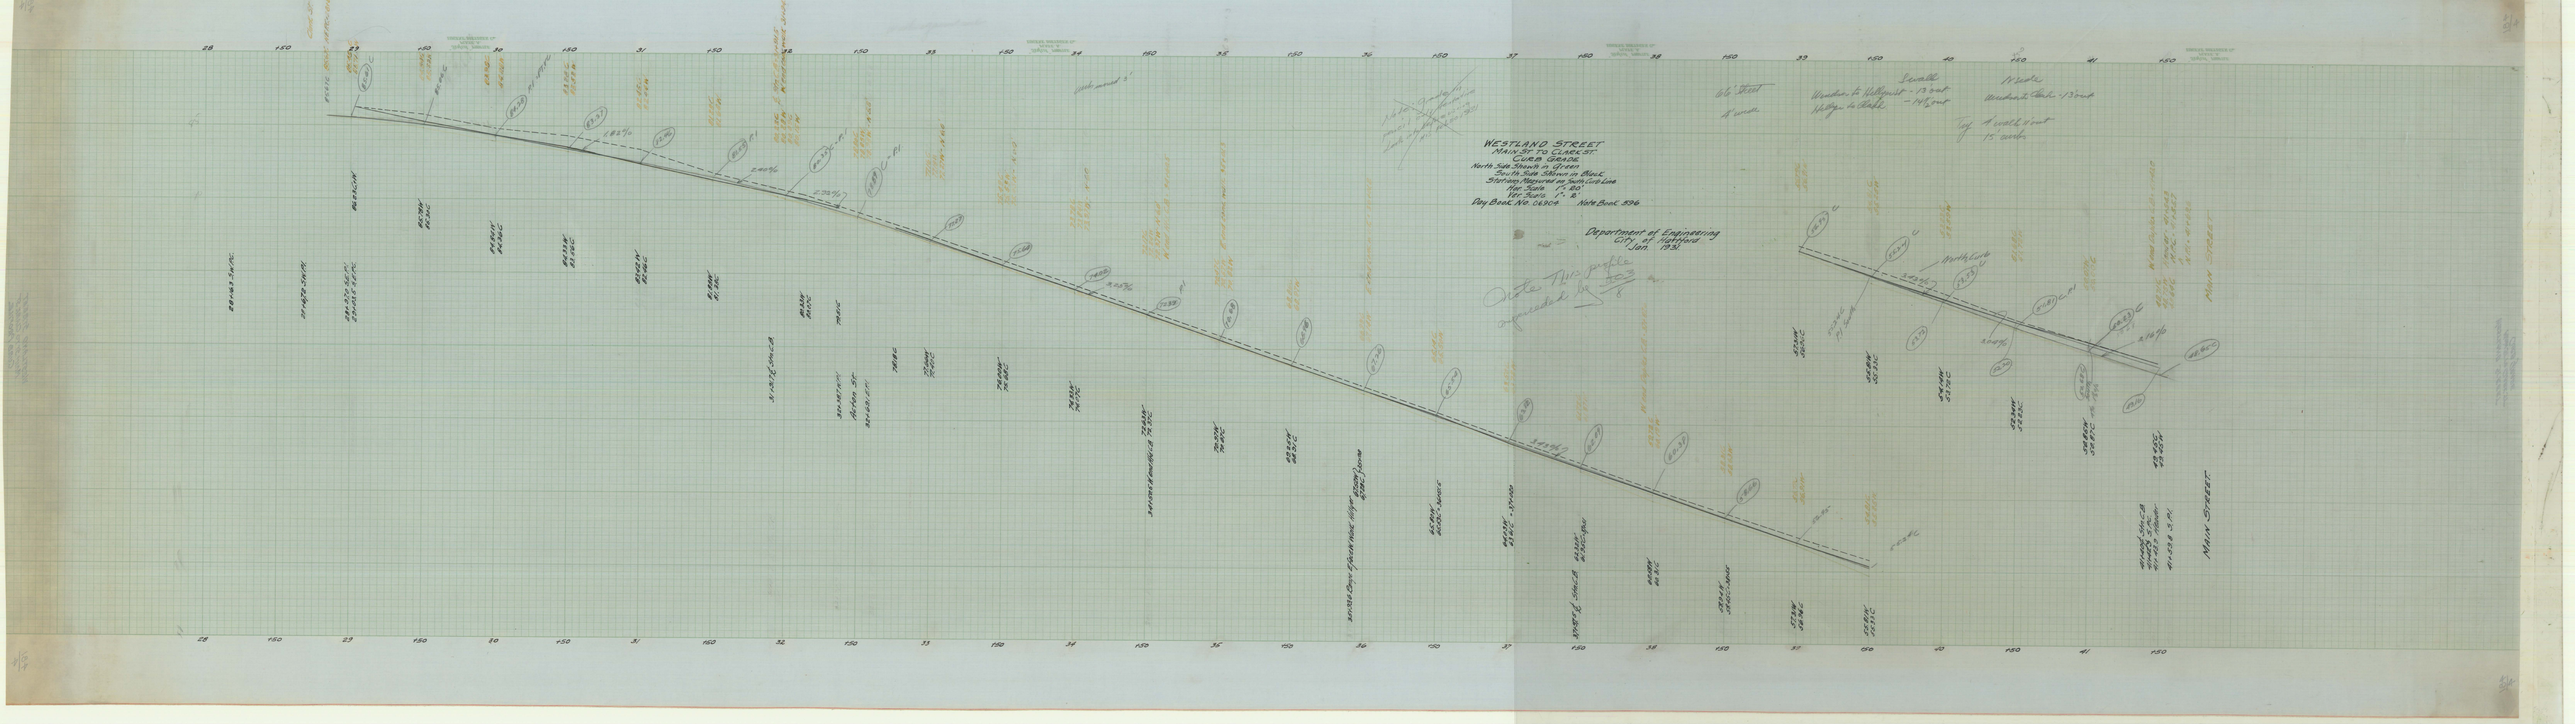
WESTLAND STREET
MAIN ST. TO CLARK ST.
CURB GRADE
North Side Shown in Green
South Side Shown in Black
Stations Reported on South Curb Line
Hor. Scale 1" = 80'
Ver. Scale 1" = 8'
Day Book No. 06909
Note Book 396
Department of Engineering
City of Hartford
Jan. 1931
Note This profile
superseded by
MAIN STREET