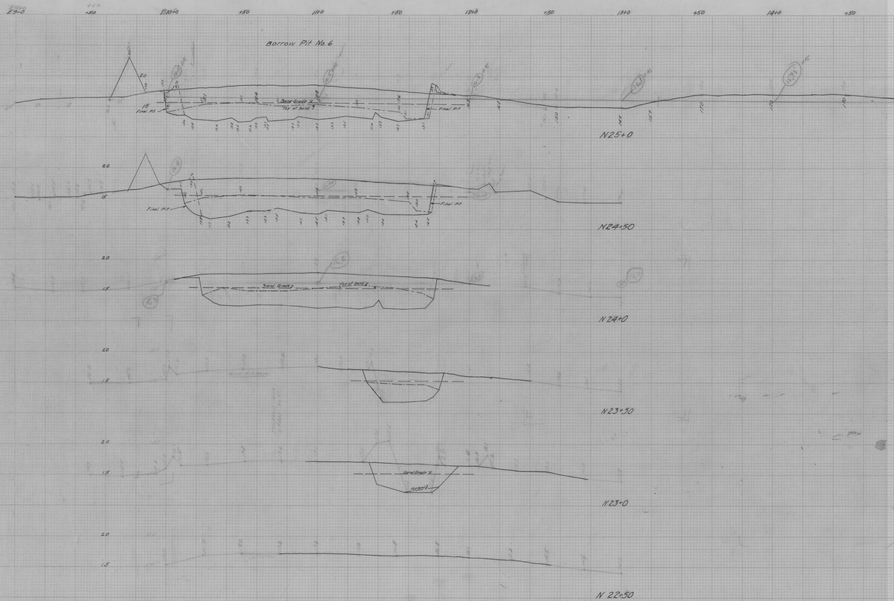


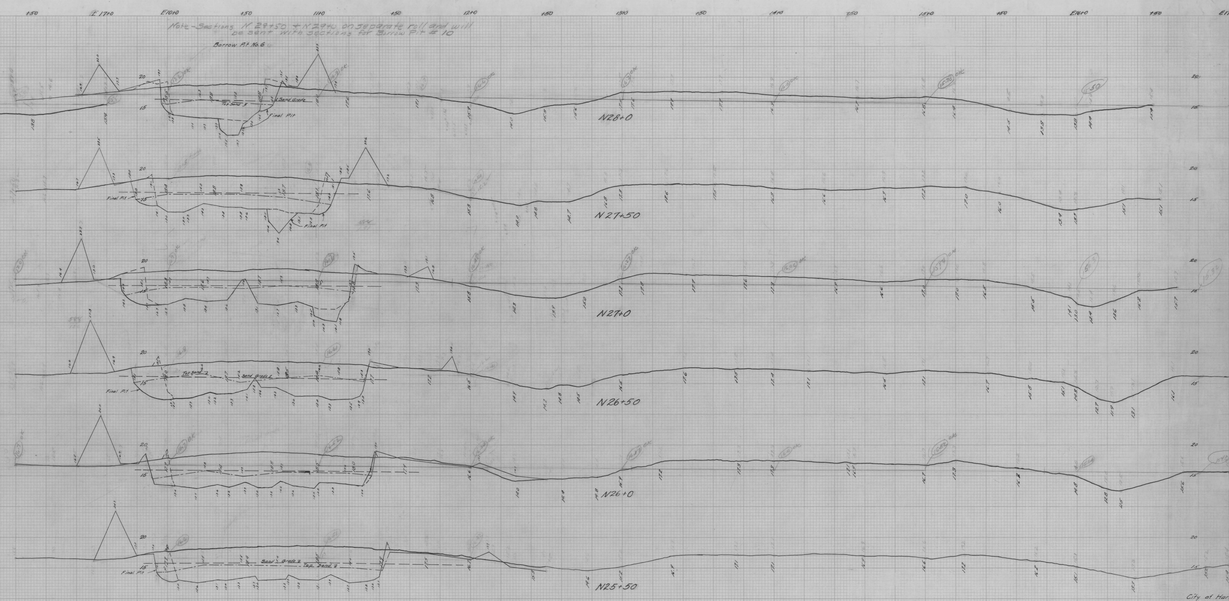

City of Hartford
Department of Engineering