
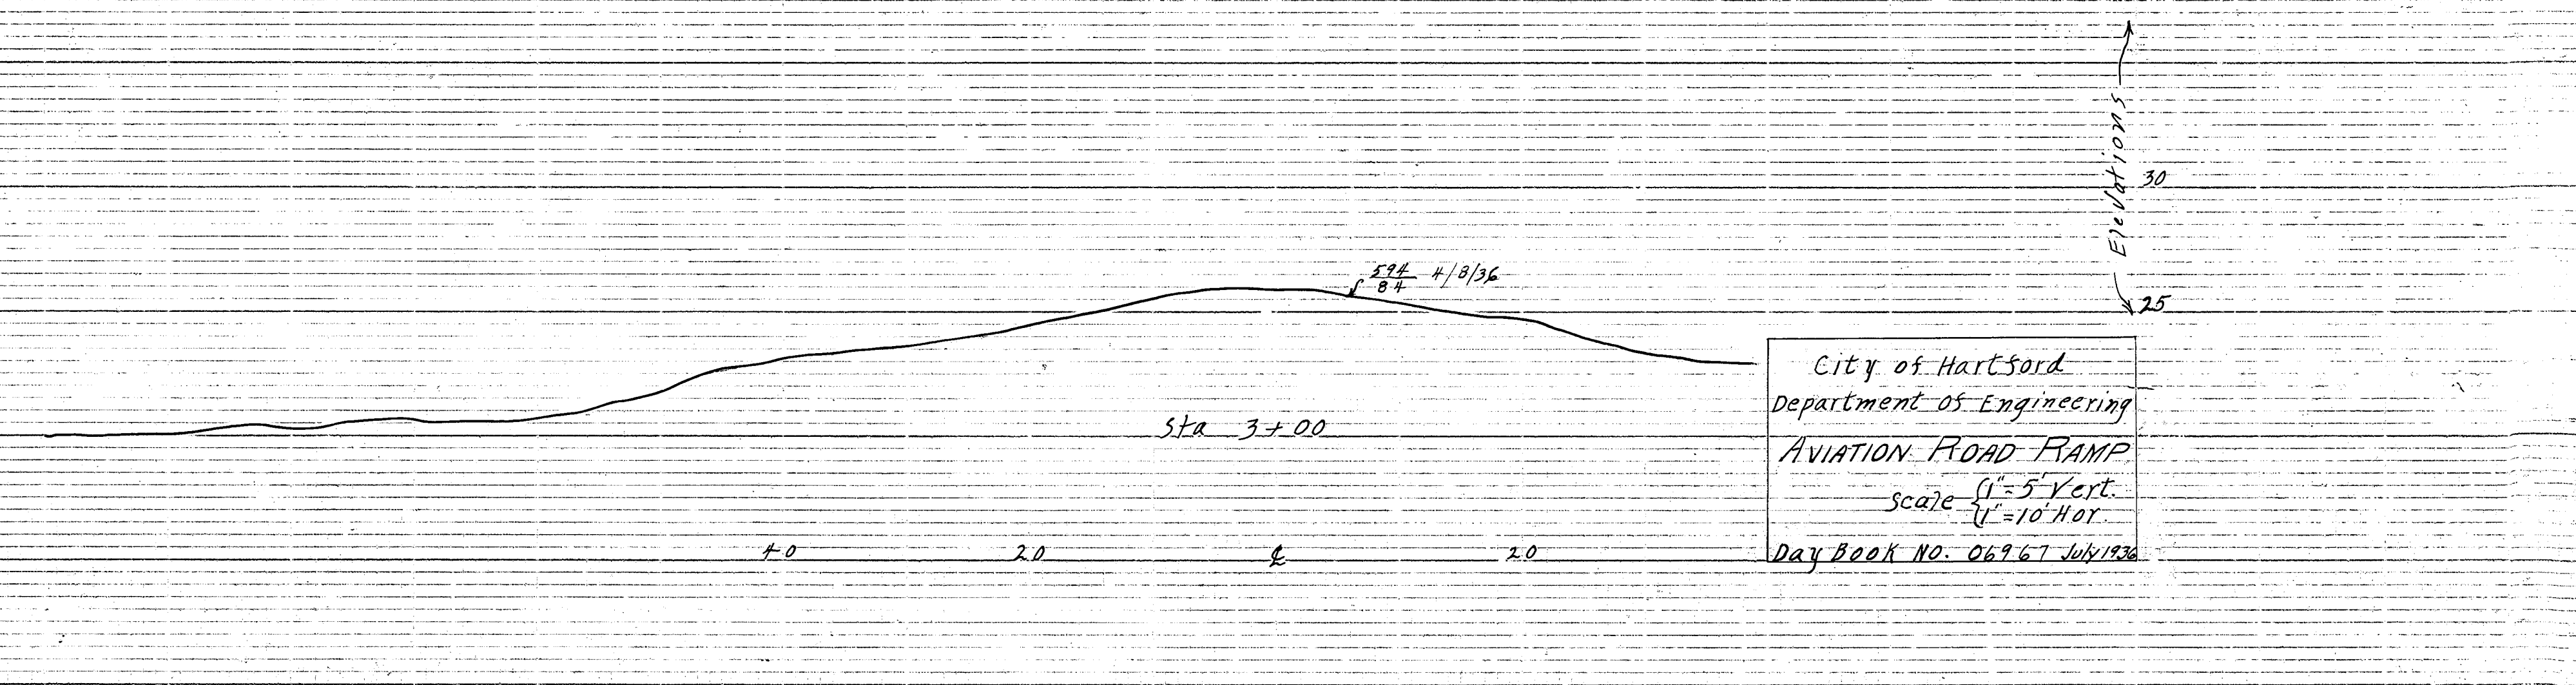
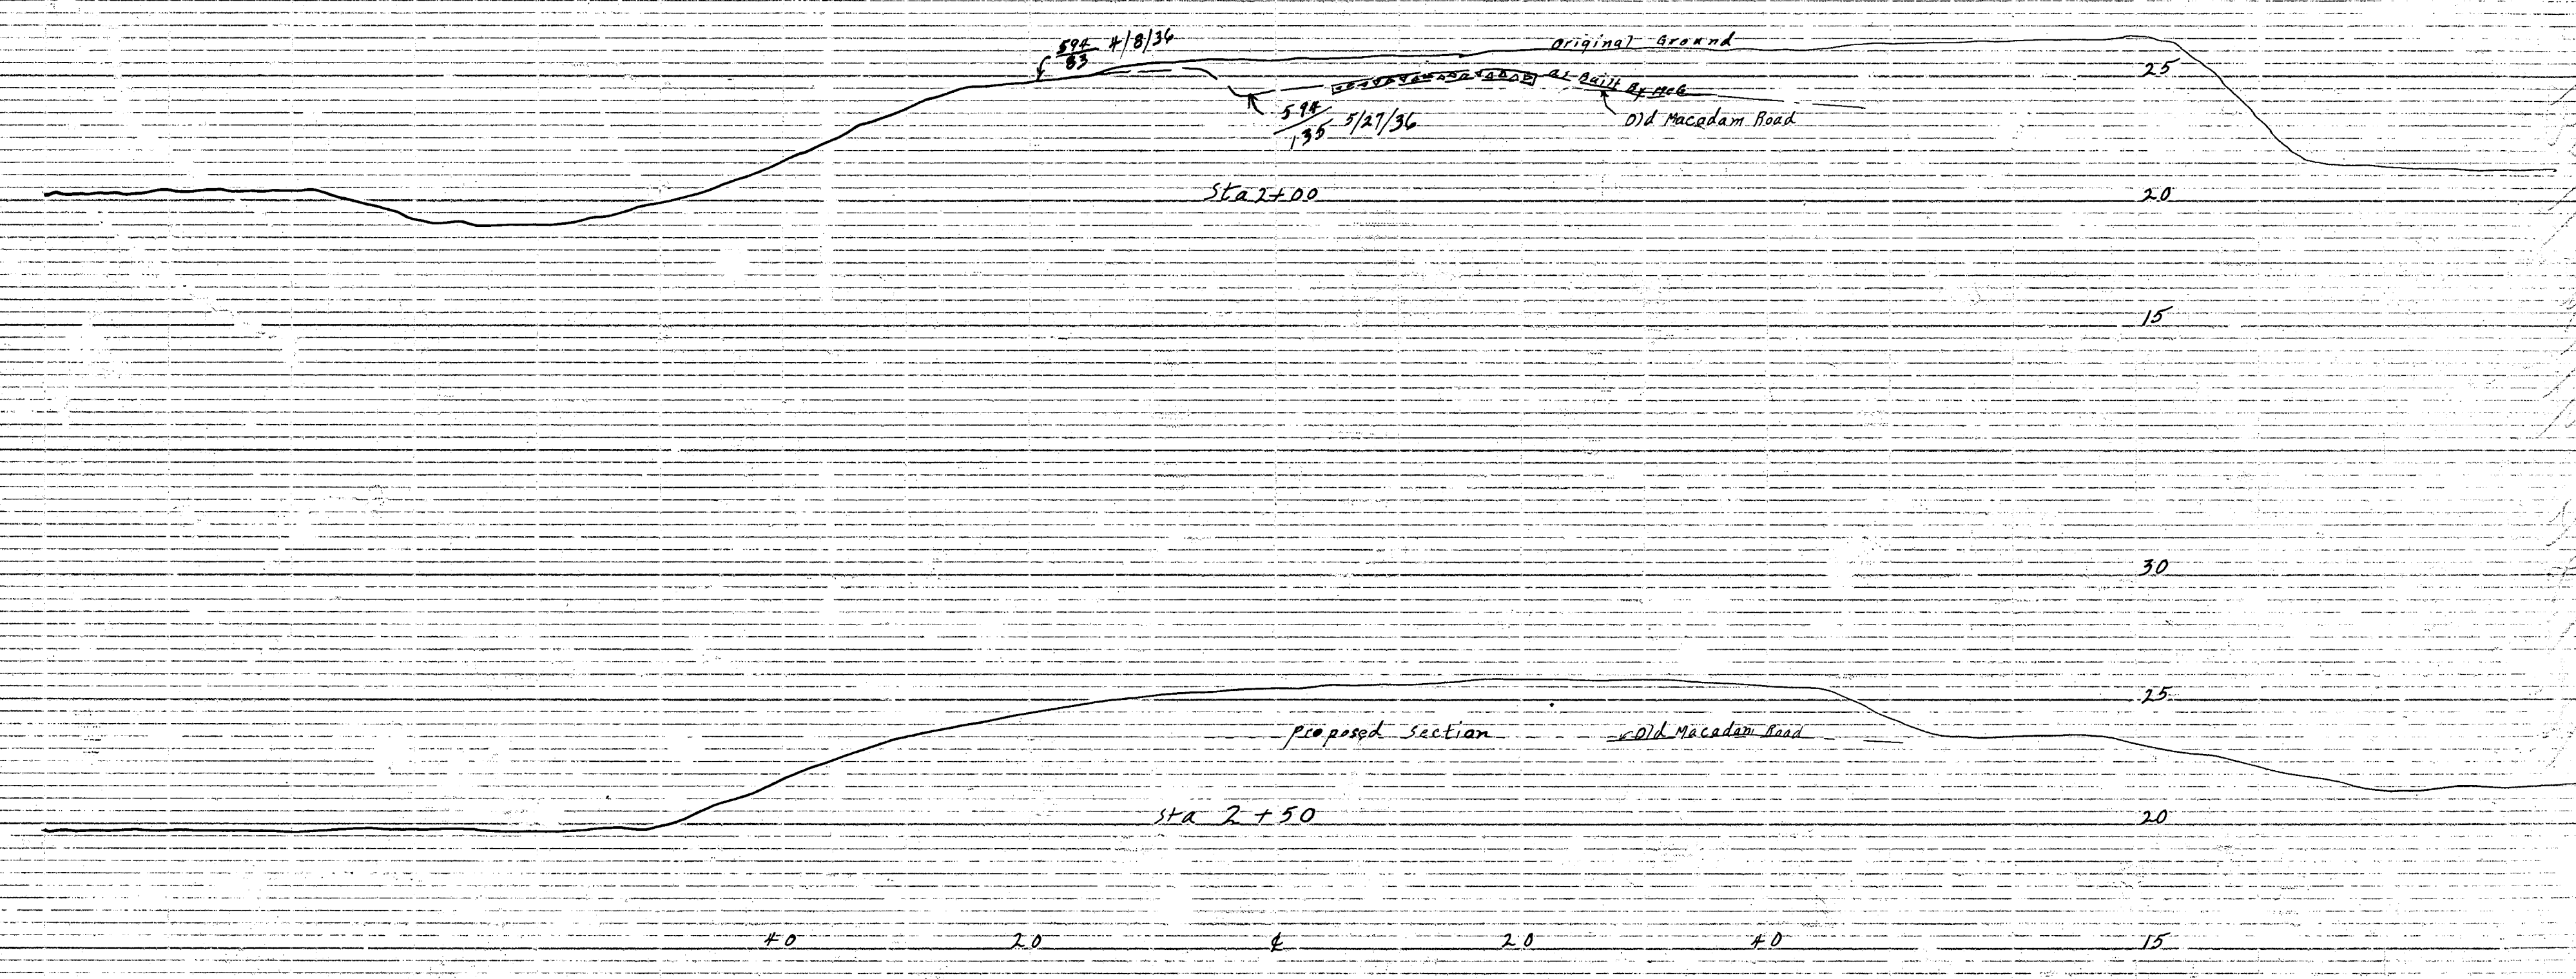
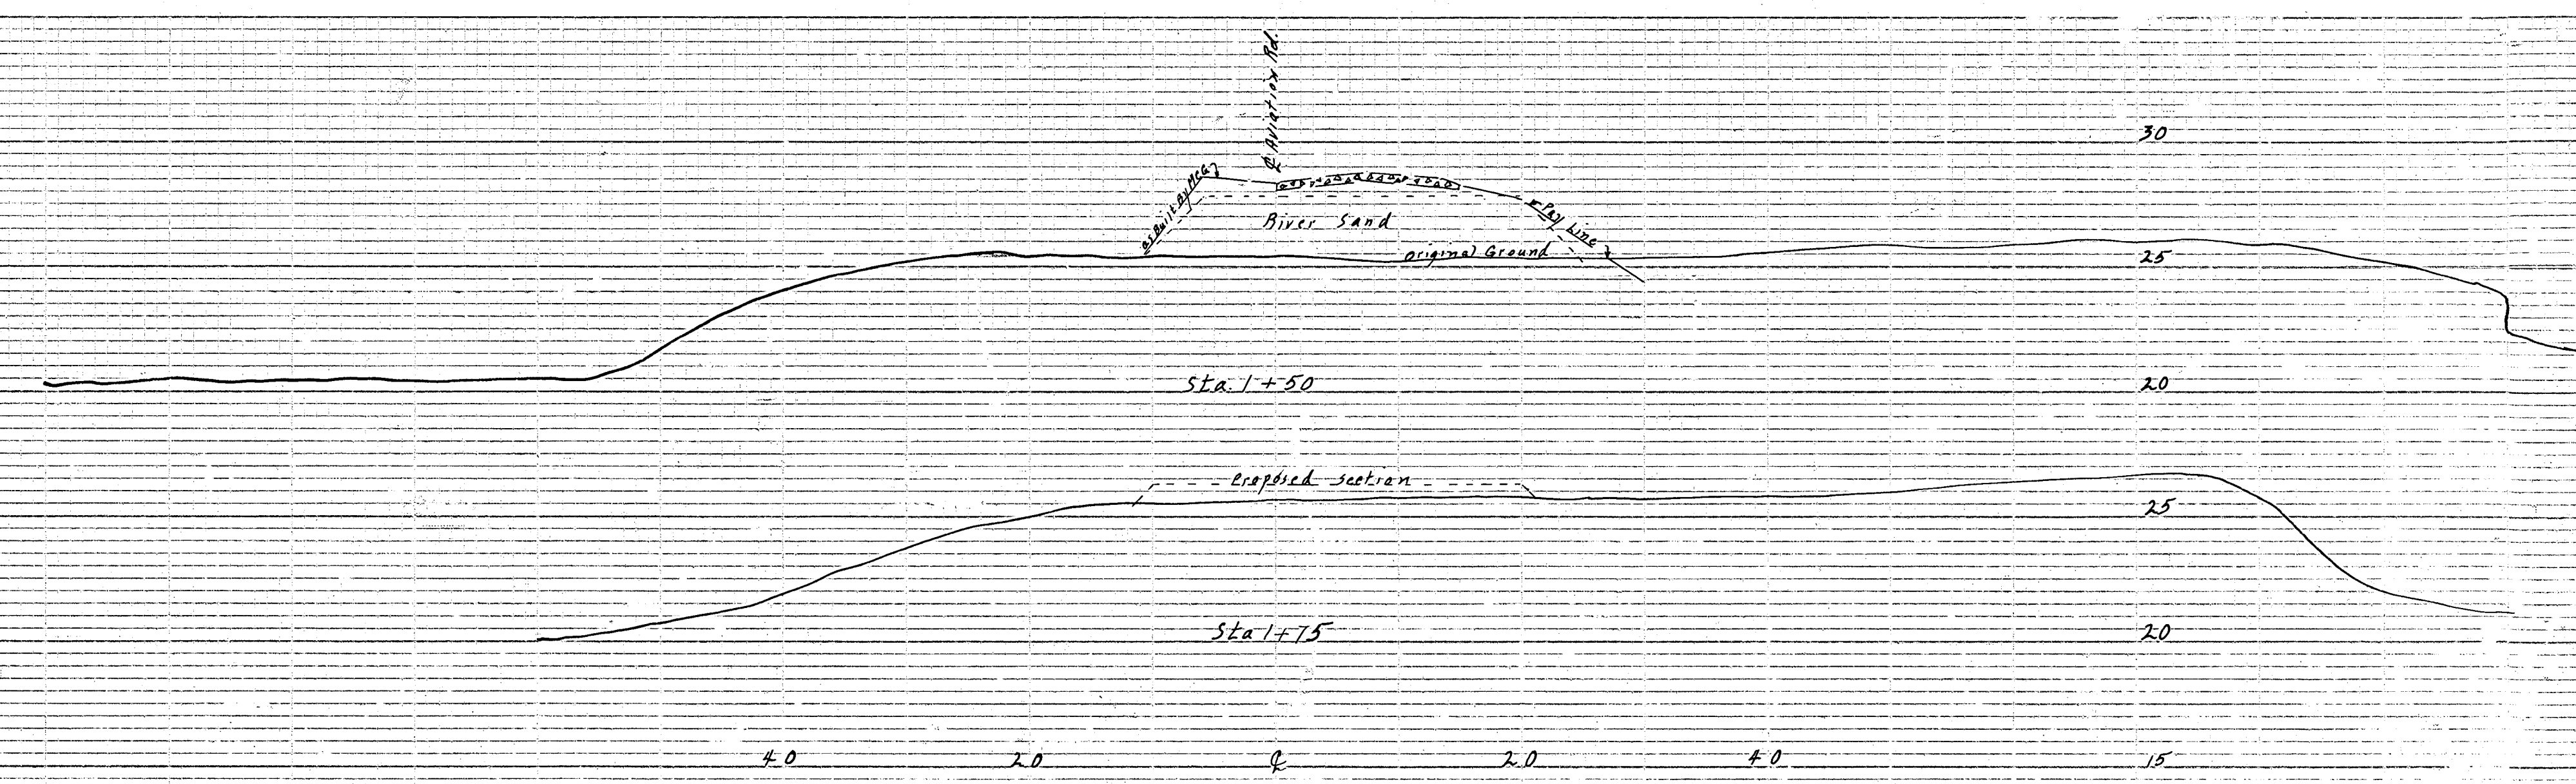
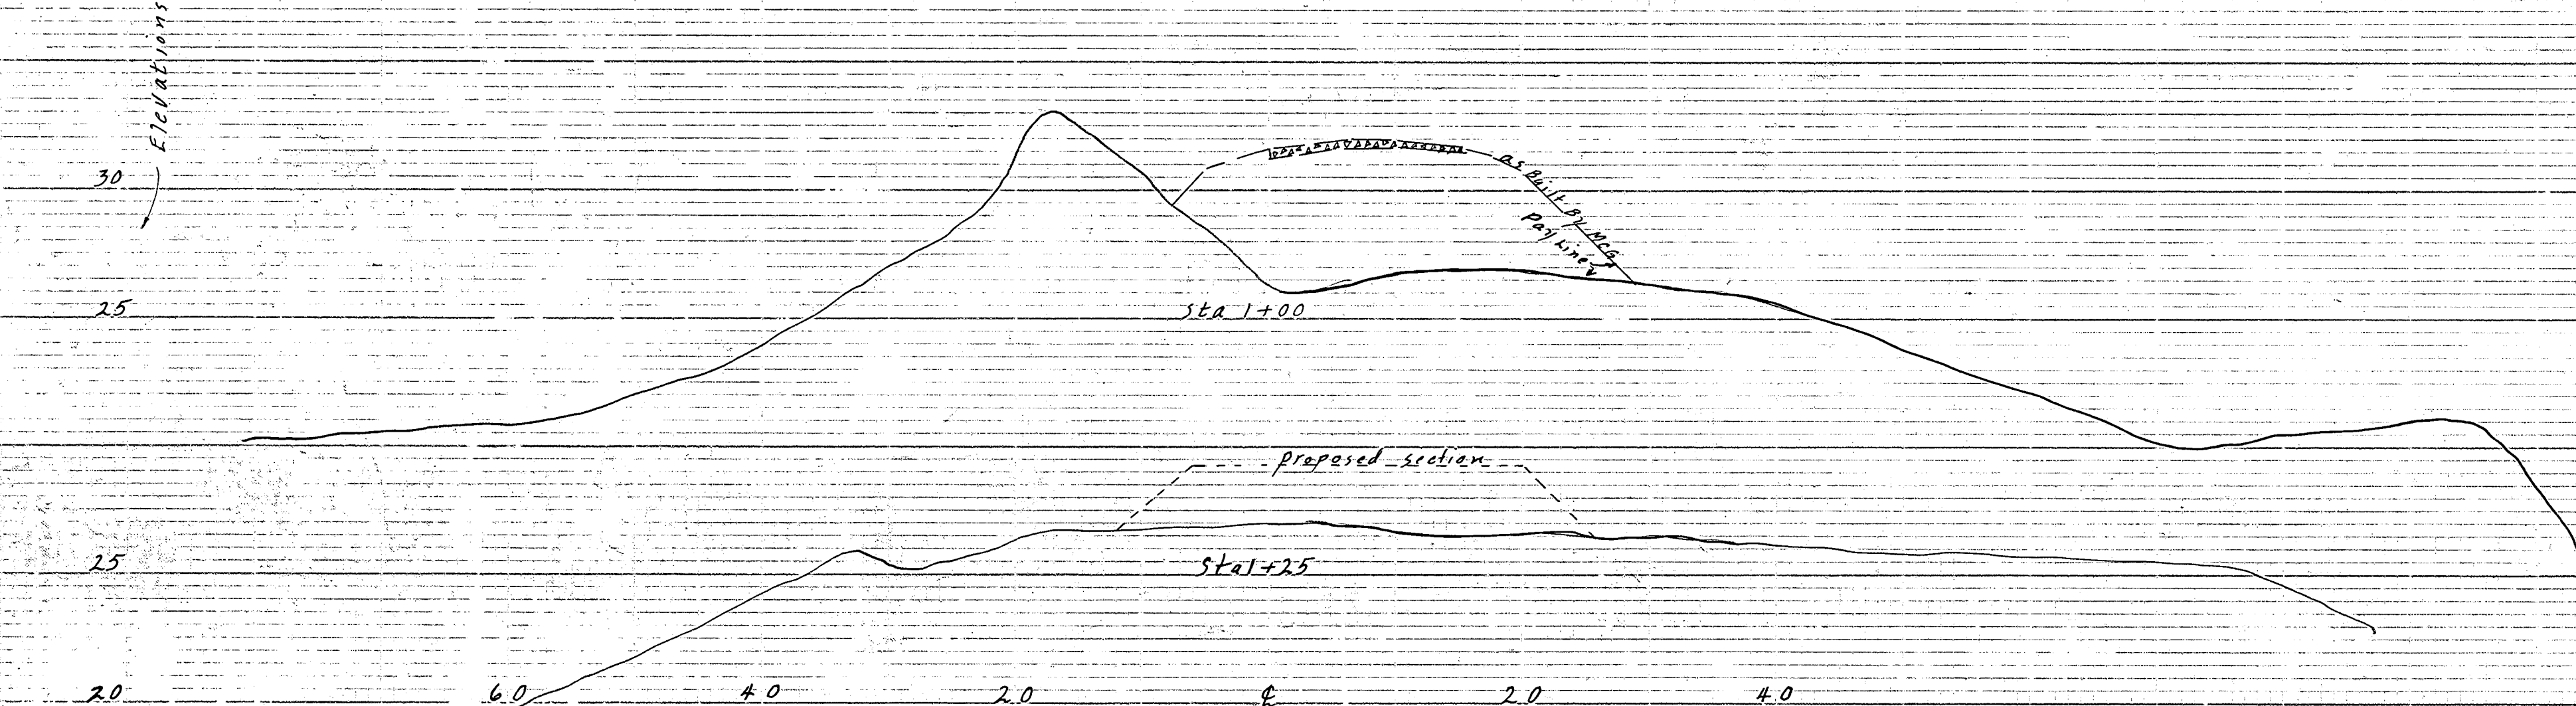
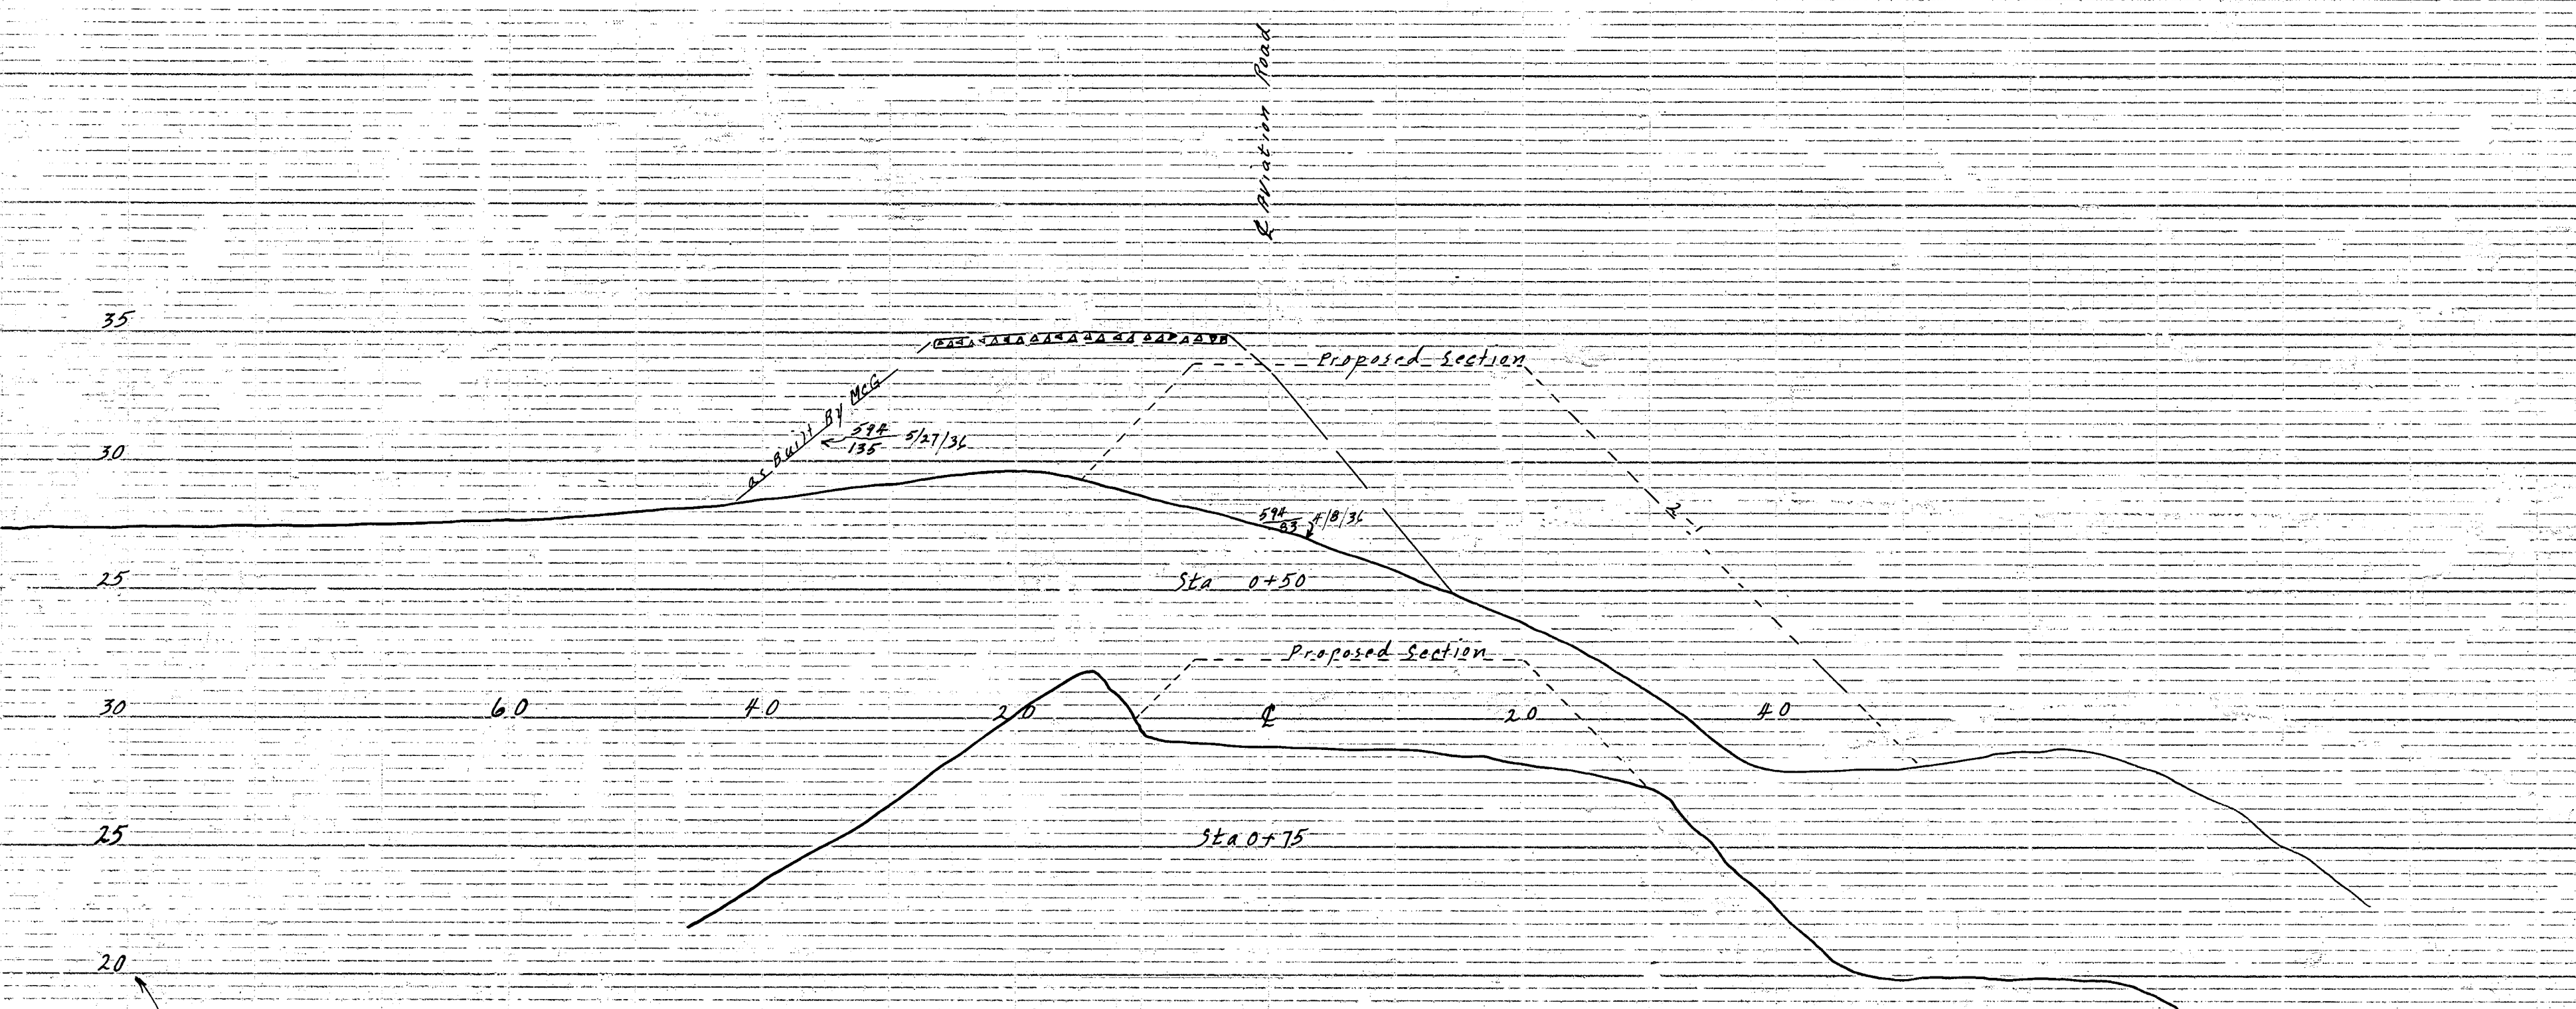


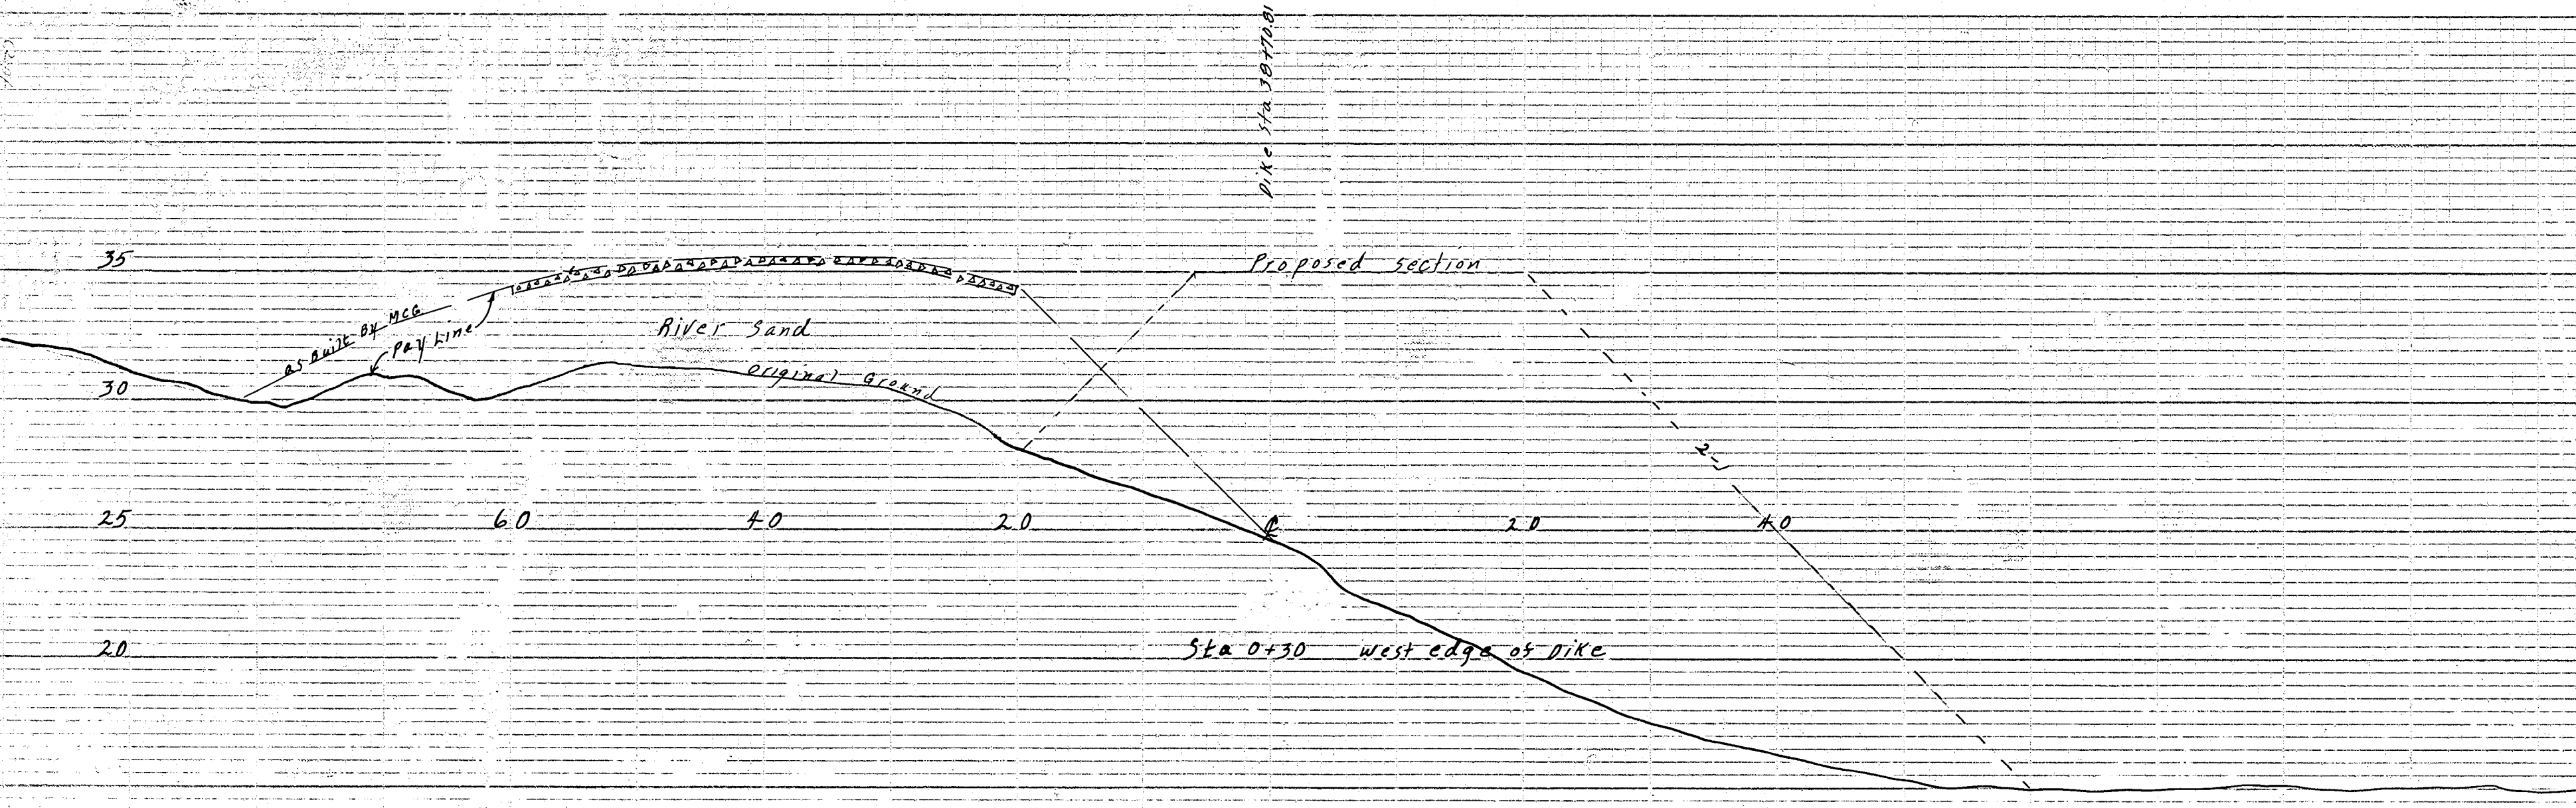

City of Hartford
Department of Engineering
AVIATION ROAD RAMP
Scale 1"=5' Vert.
1"=10' Hor.
Day Book No. 06967 July 1924