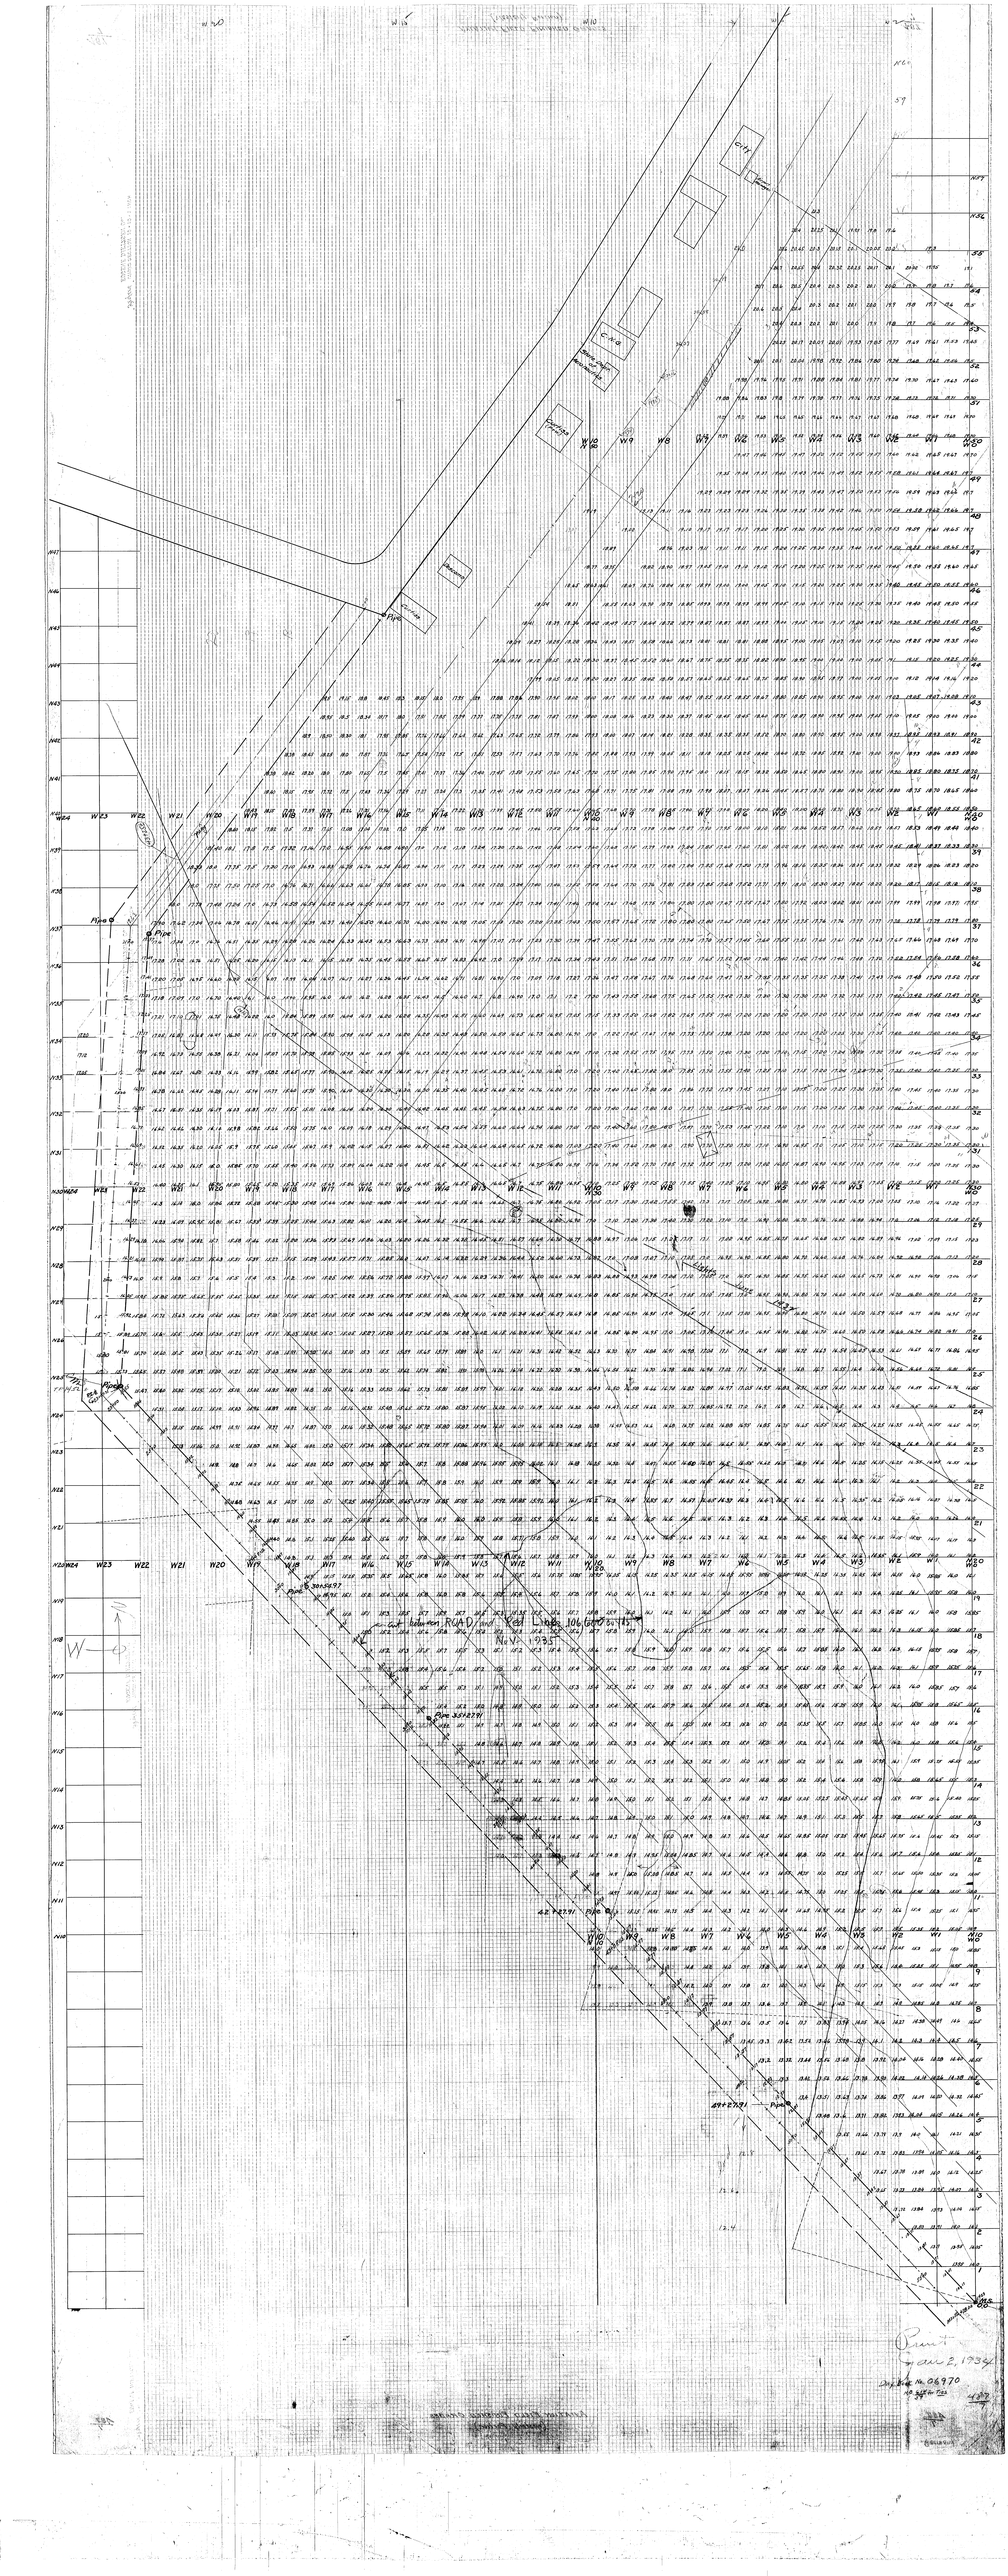
Pipe
Pipe
Pipe