


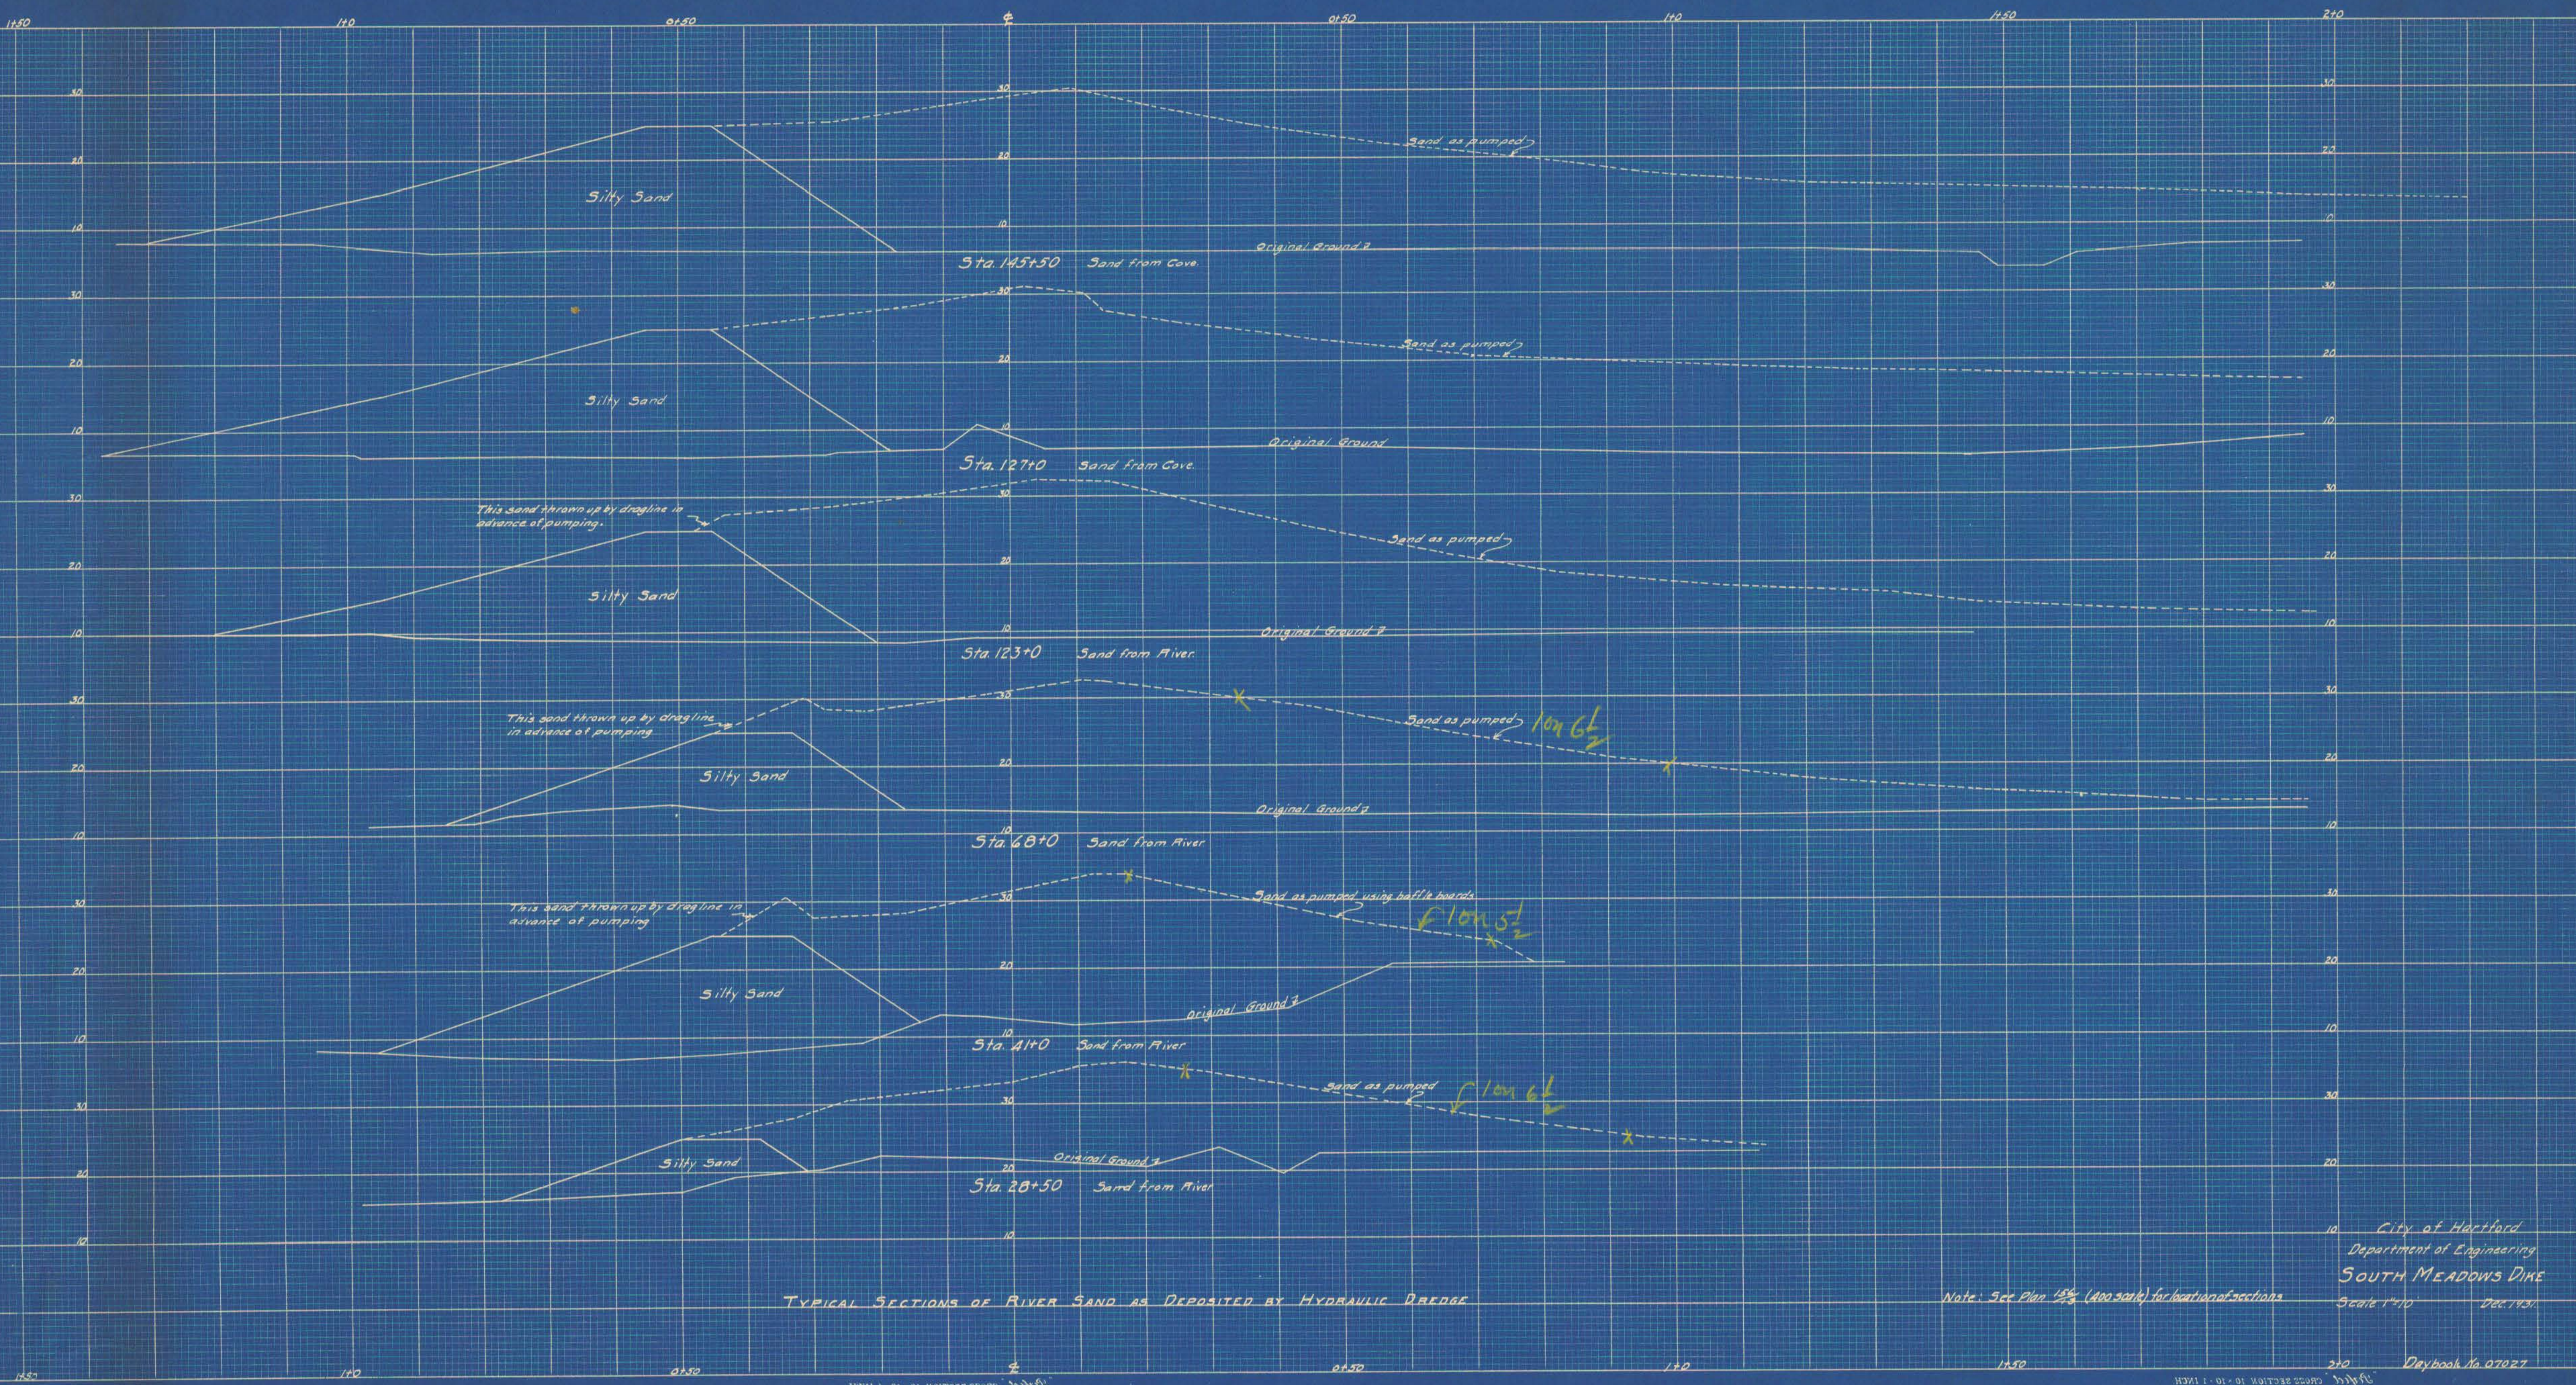

TYPICAL SECTIONS OF RIVER SAND AS DEPOSITED BY HYDRAULIC DREDGE

Note: See Plan 156 (App. 300 ft) for location of sections

City of Hartford
Department of Engineering
SOUTH MEADOWS DIKE
Scale 1"=10'
Dec. 1937

Daybook No. 07027

VERTICAL DISTANCE 10' = 1" INCH

VERTICAL DISTANCE 10' = 1" INCH