


11/2

11/2

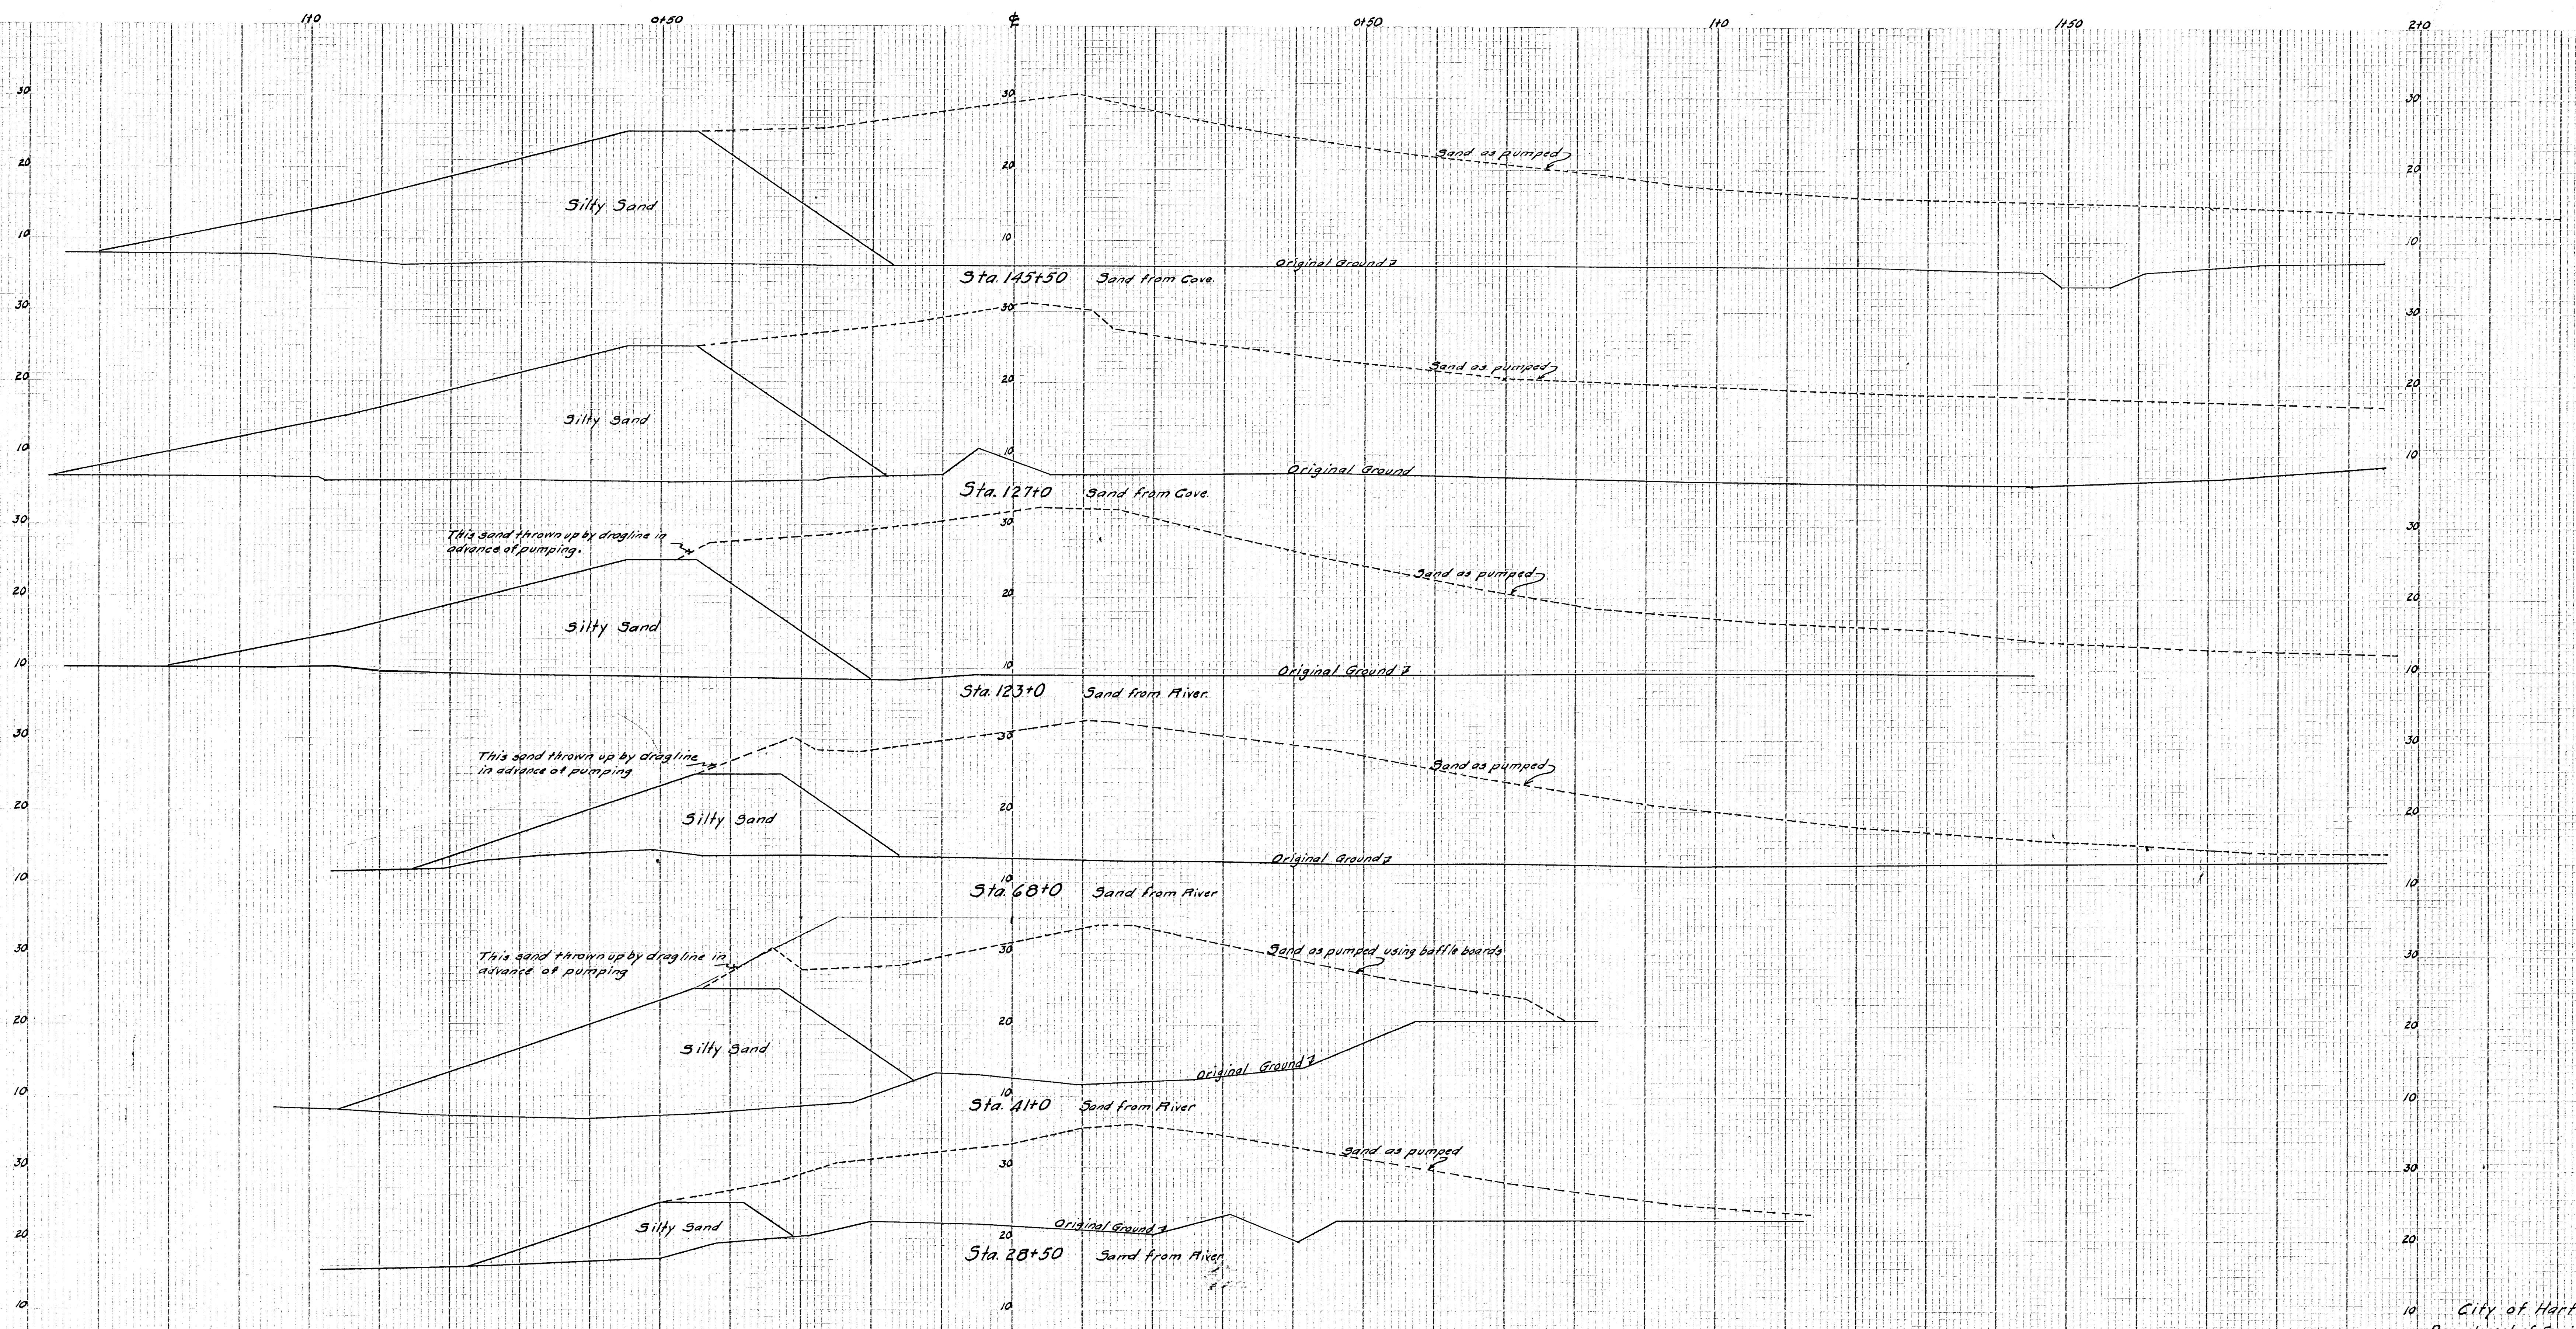

TYPICAL SECTIONS OF RIVER SAND AS DEPOSITED BY HYDRAULIC DREDGE

Note: See Plan 193 (400 scale) for location of sections.

City of Hartford
Department of Engineering
SOUTH MEADOWS DIKE
Scale 1"=10'
Dec. 1931

Daybook No. 07027

11/2

11/2