
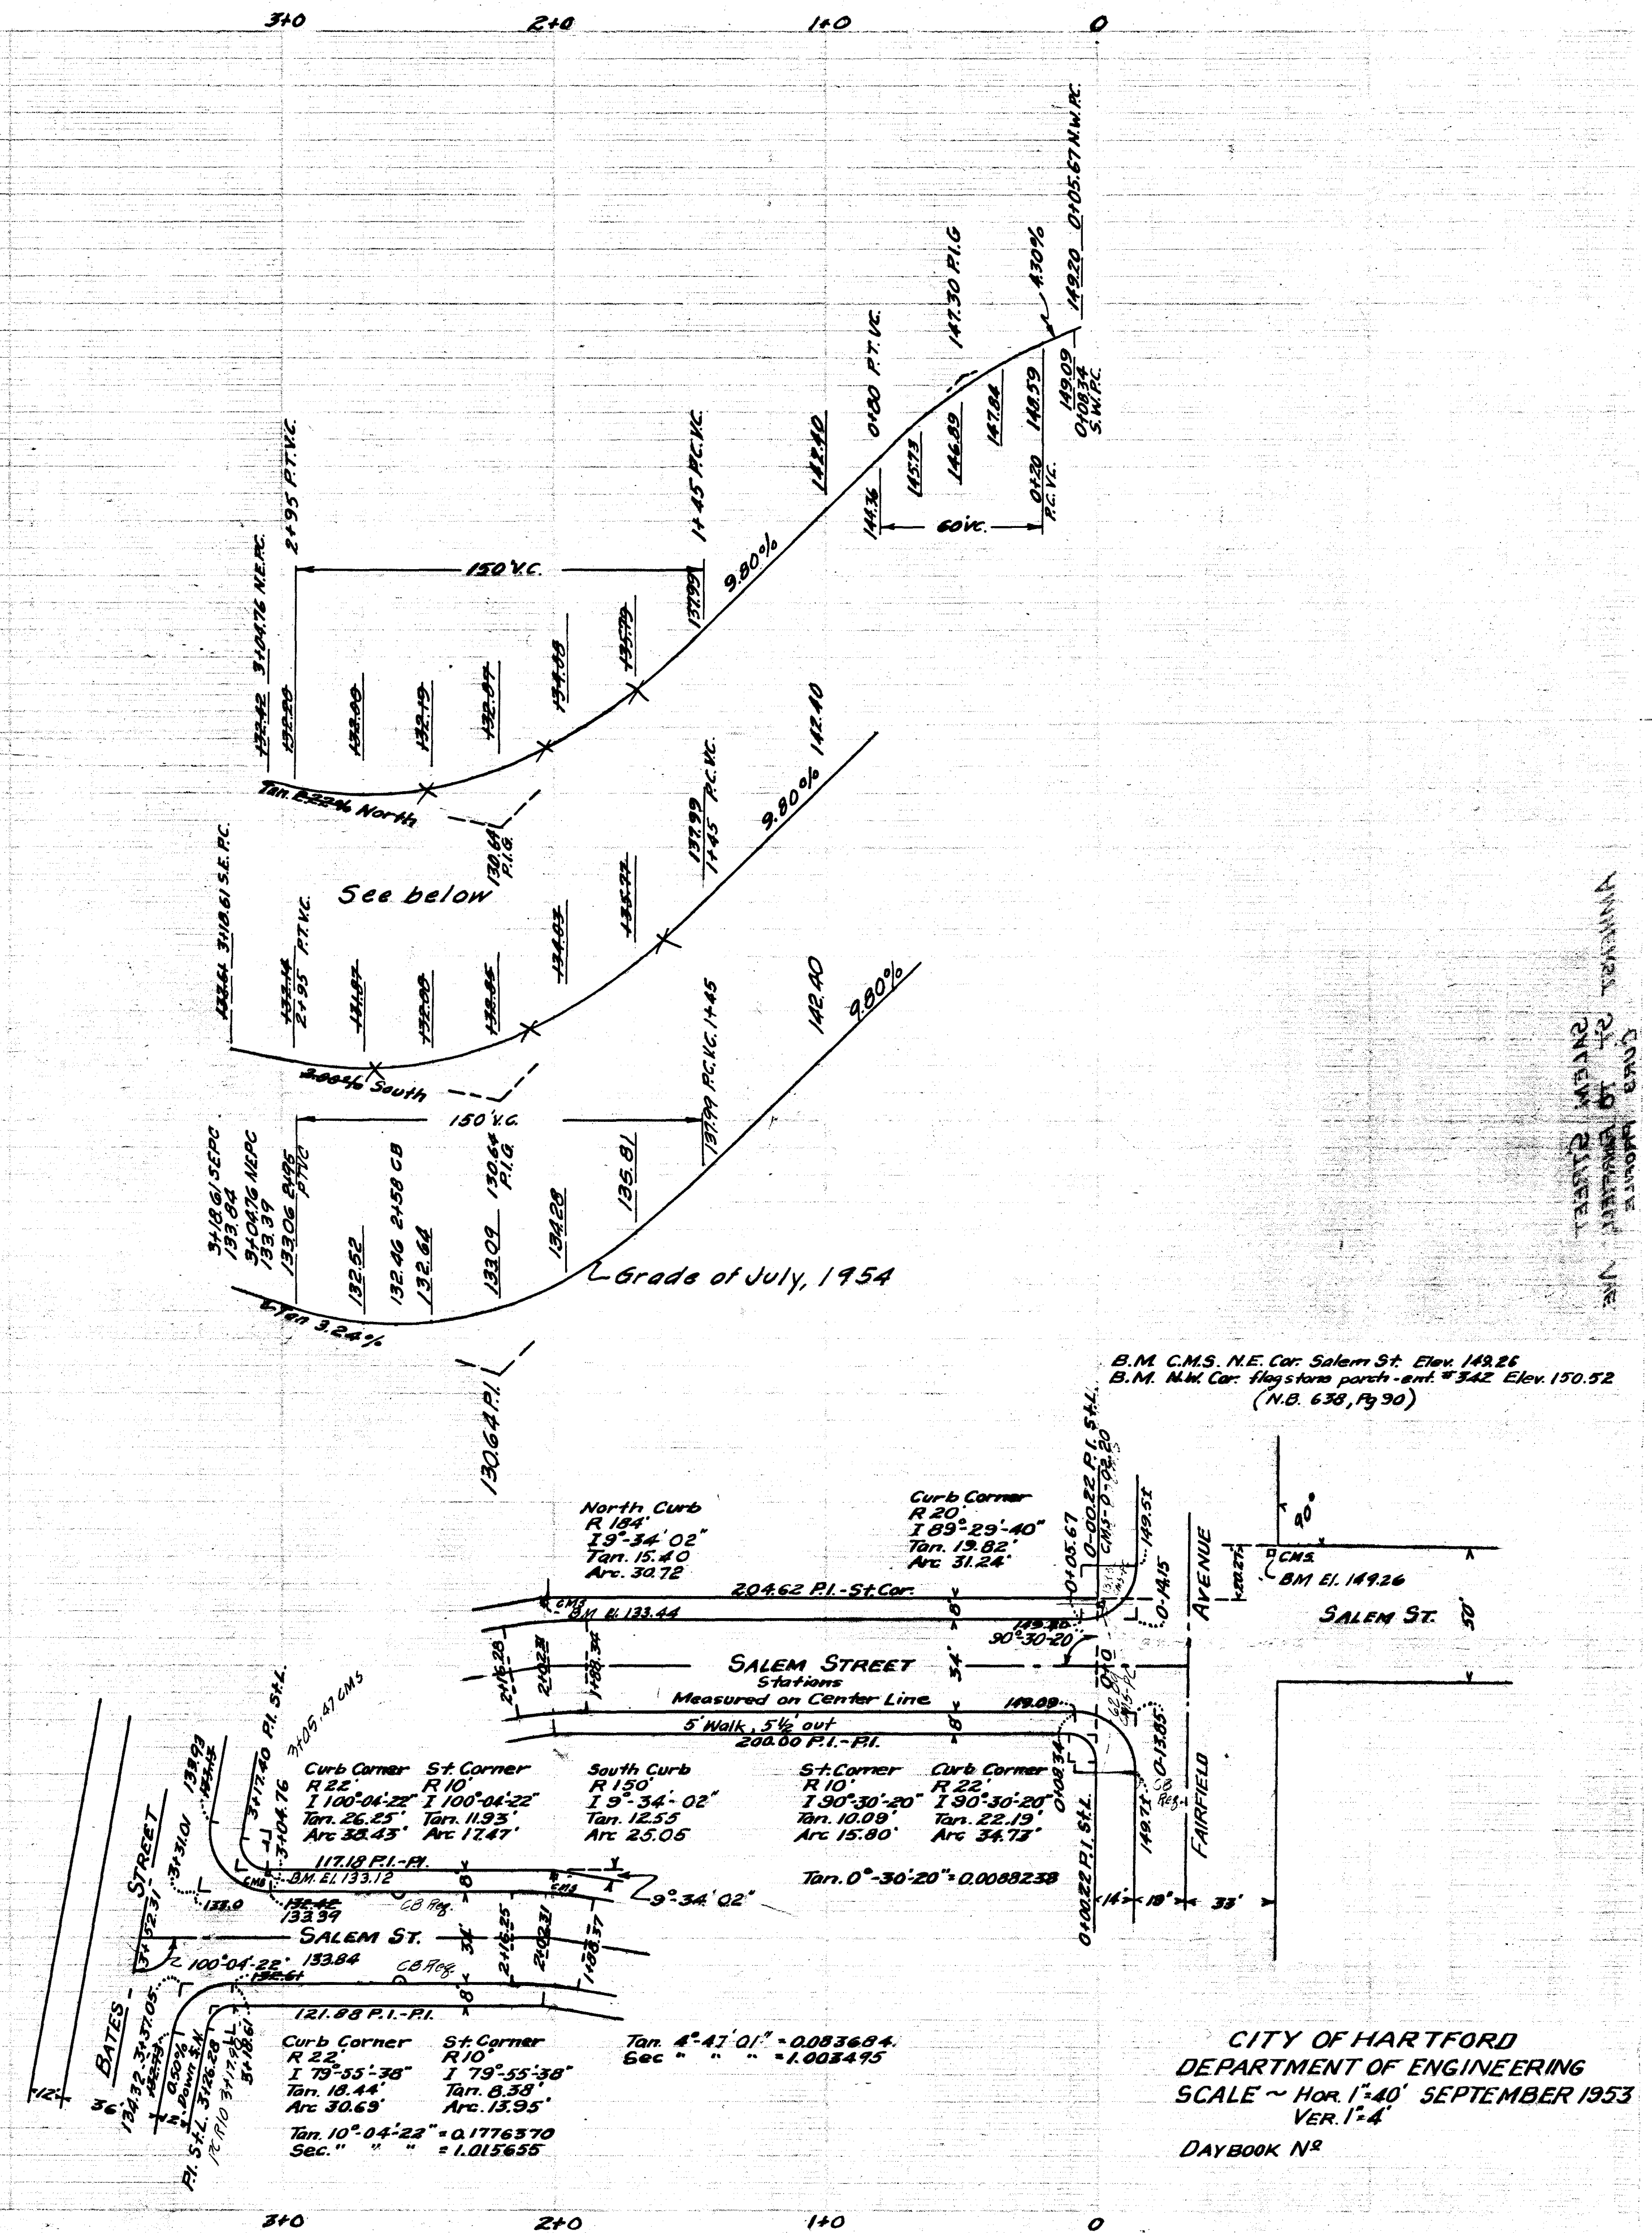


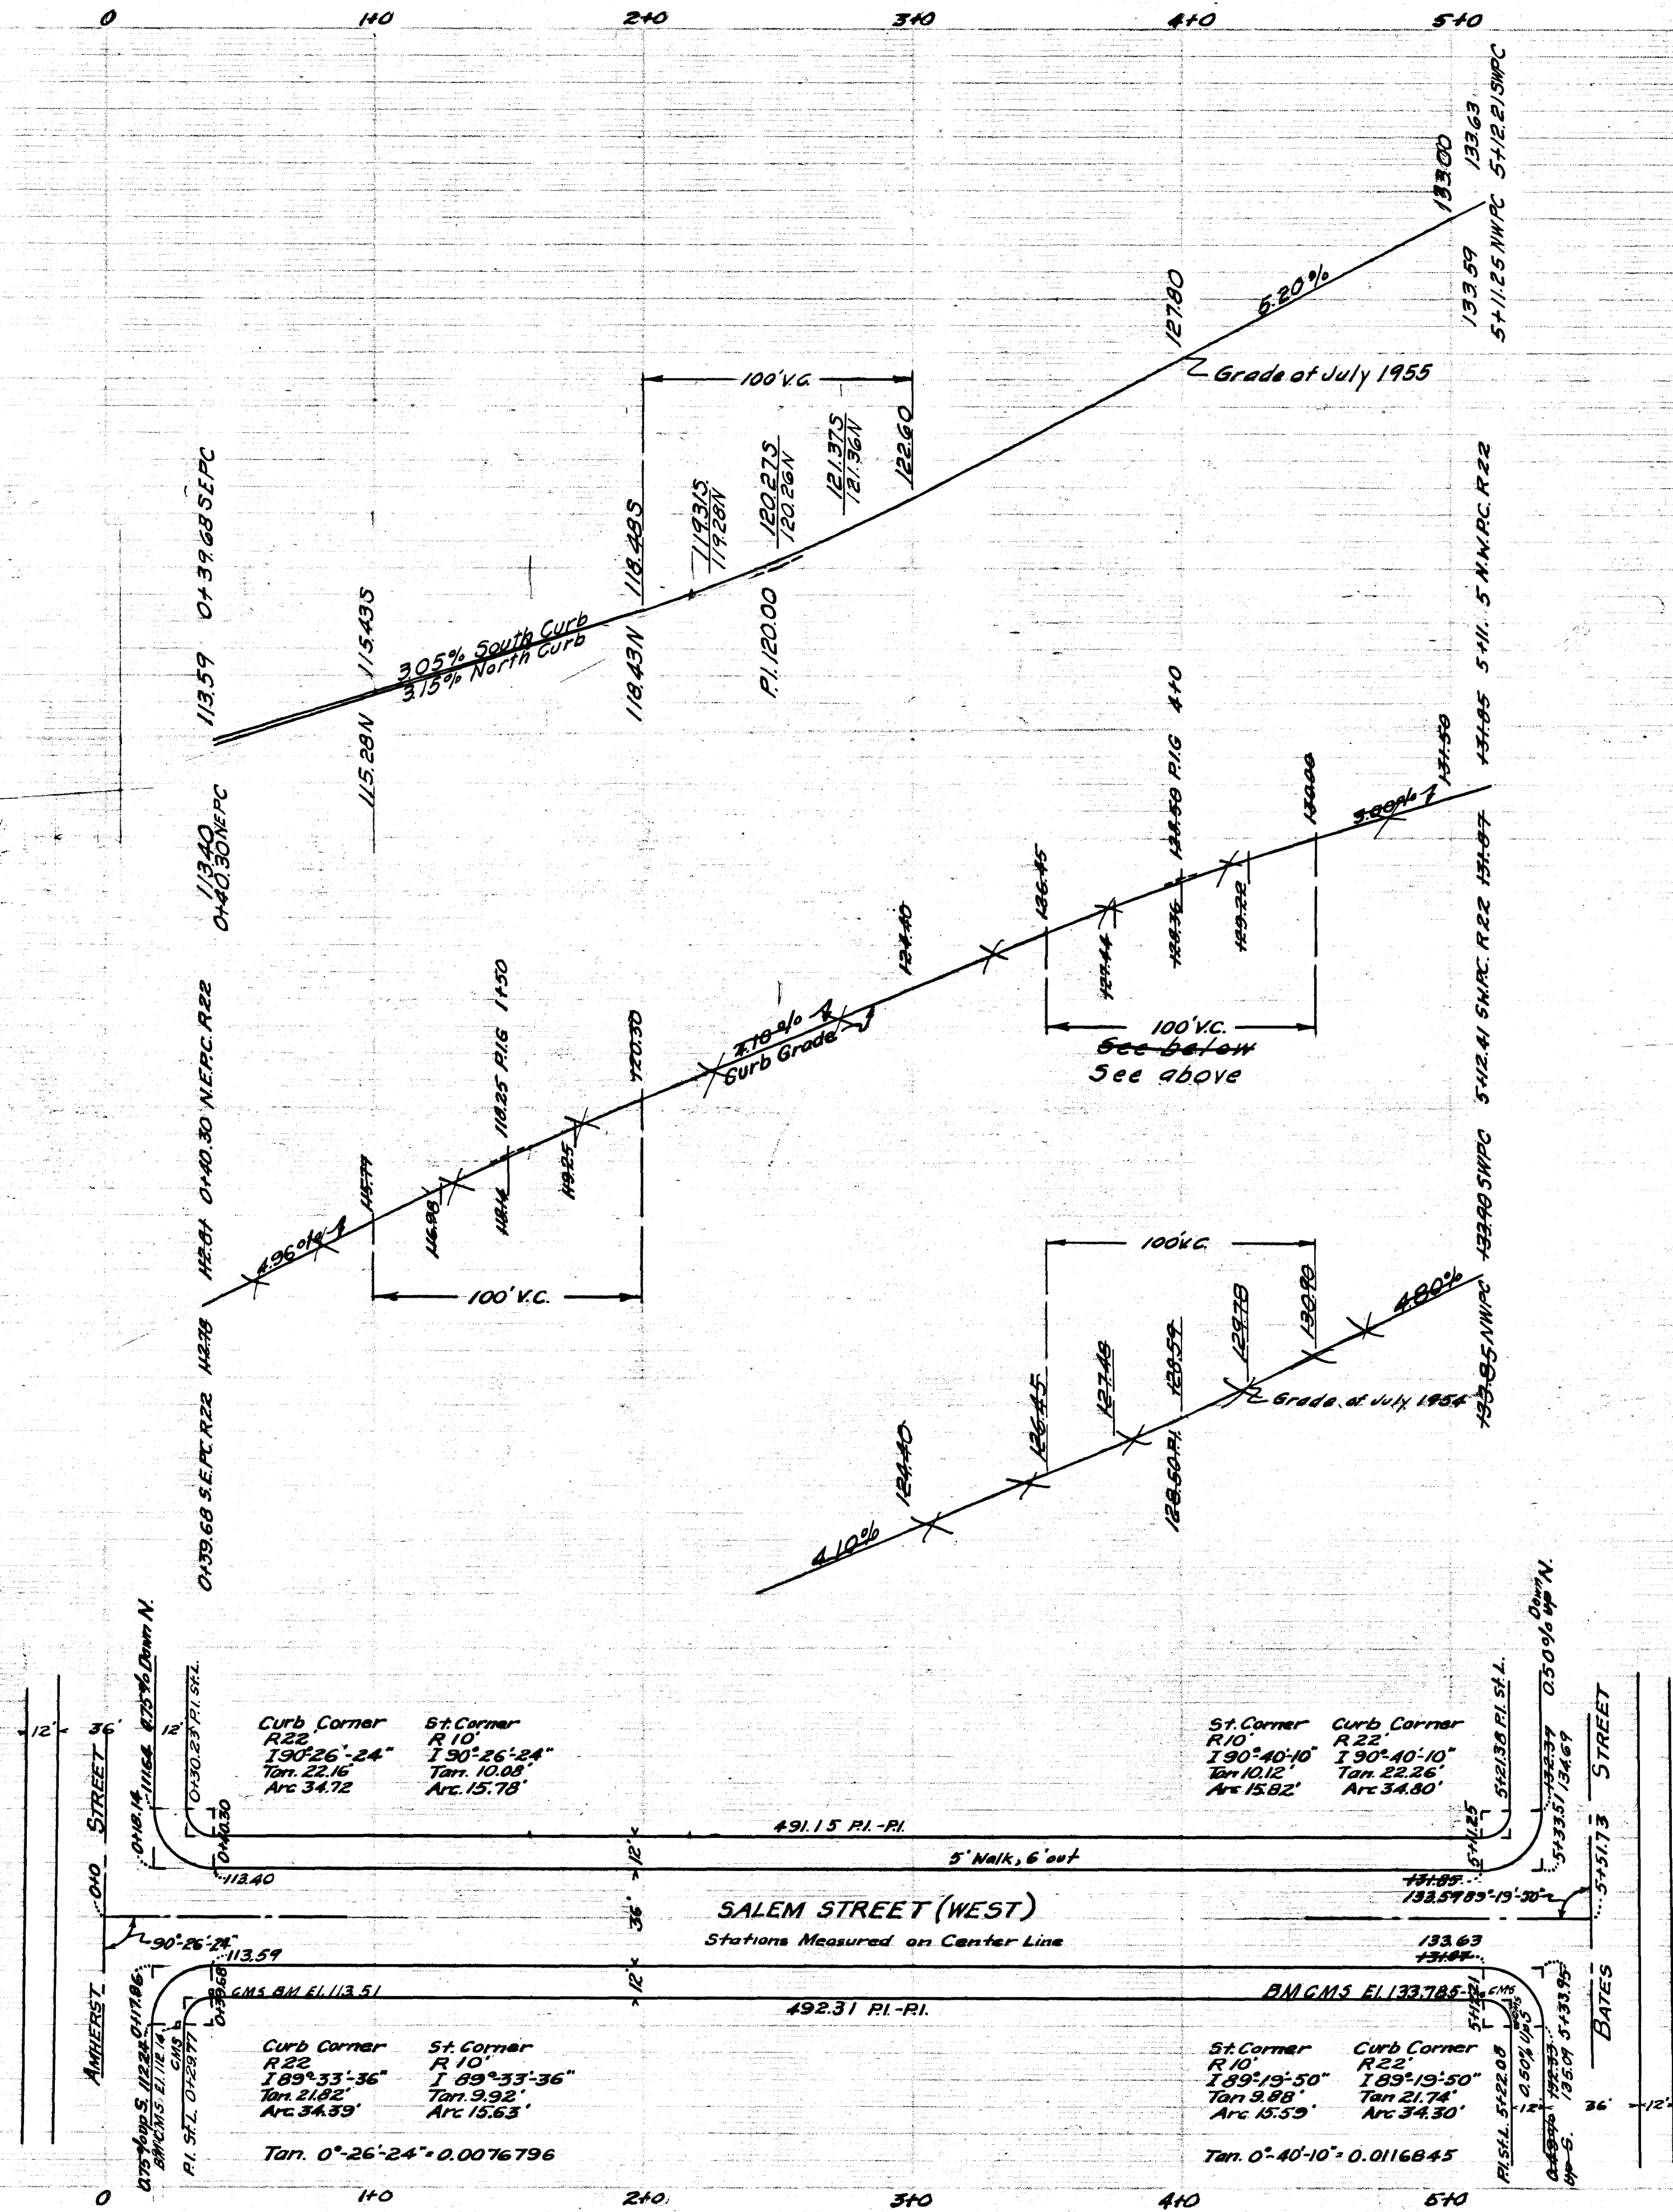

CITY OF HARTFORD
DEPARTMENT OF ENGINEERING
SCALE ~ HOR. 1"=40' SEPTEMBER 1953
VER. 1"=4'
DAYBOOK NR