


0.25%

12.5% (South)

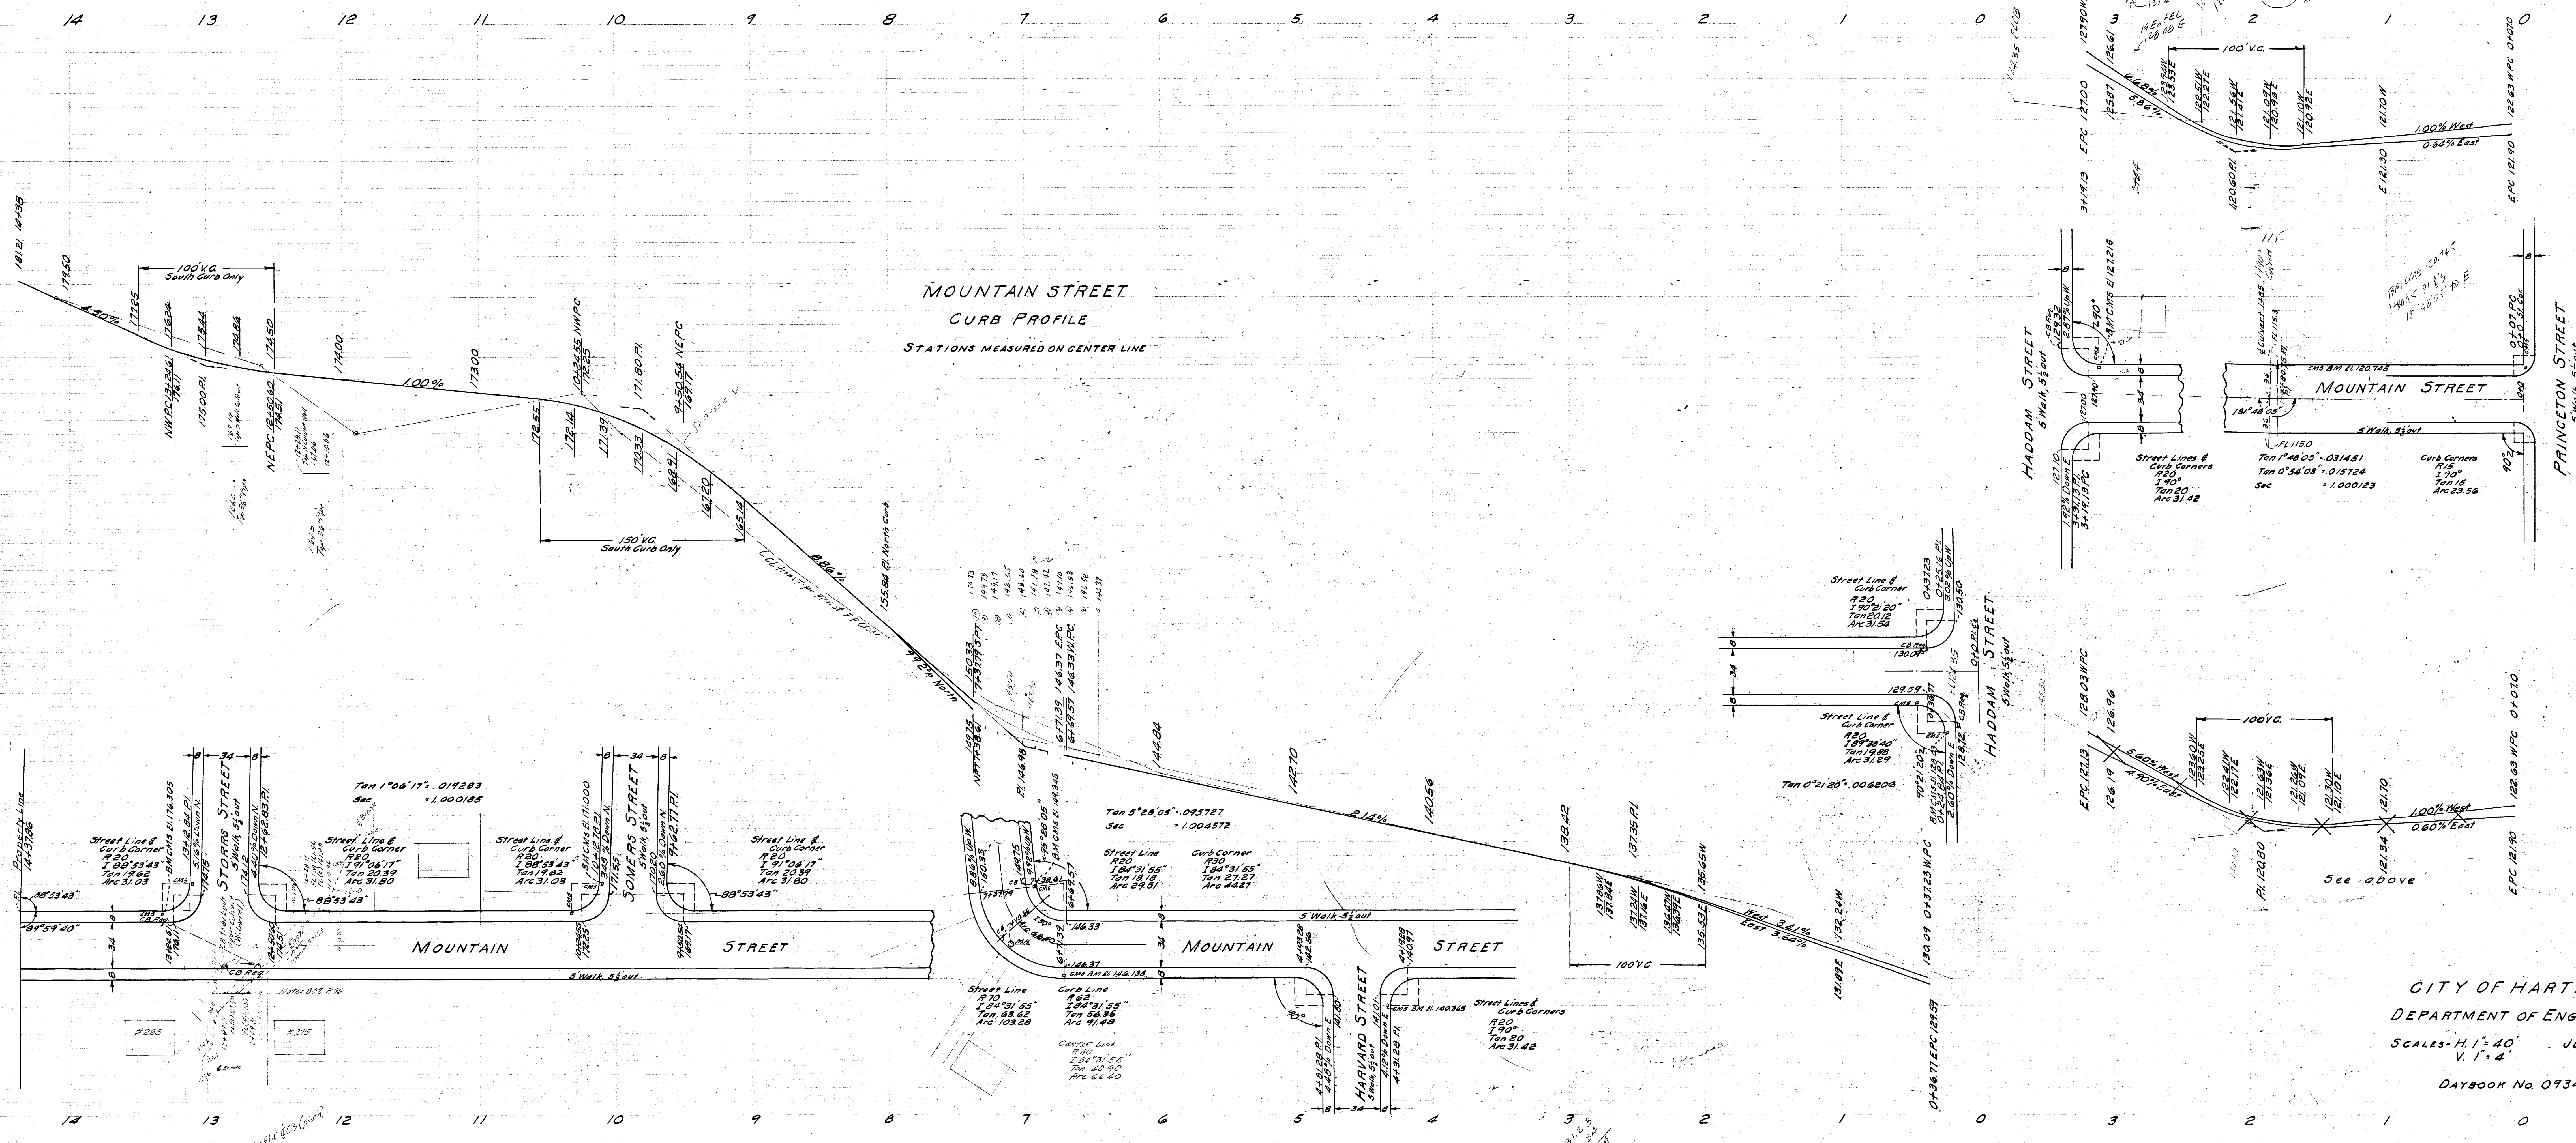

CITY OF HARTFORD
DEPARTMENT OF ENGINEERING
SCALES - H. 1" = 40' JULY 1954
V. 1" = 4'
DAYBOOK No. 09347

421.23
420.34
416.44
20.44
306.44