


9/2

9/2

122.05
1.22
120.83

120.83
1.22
122.05

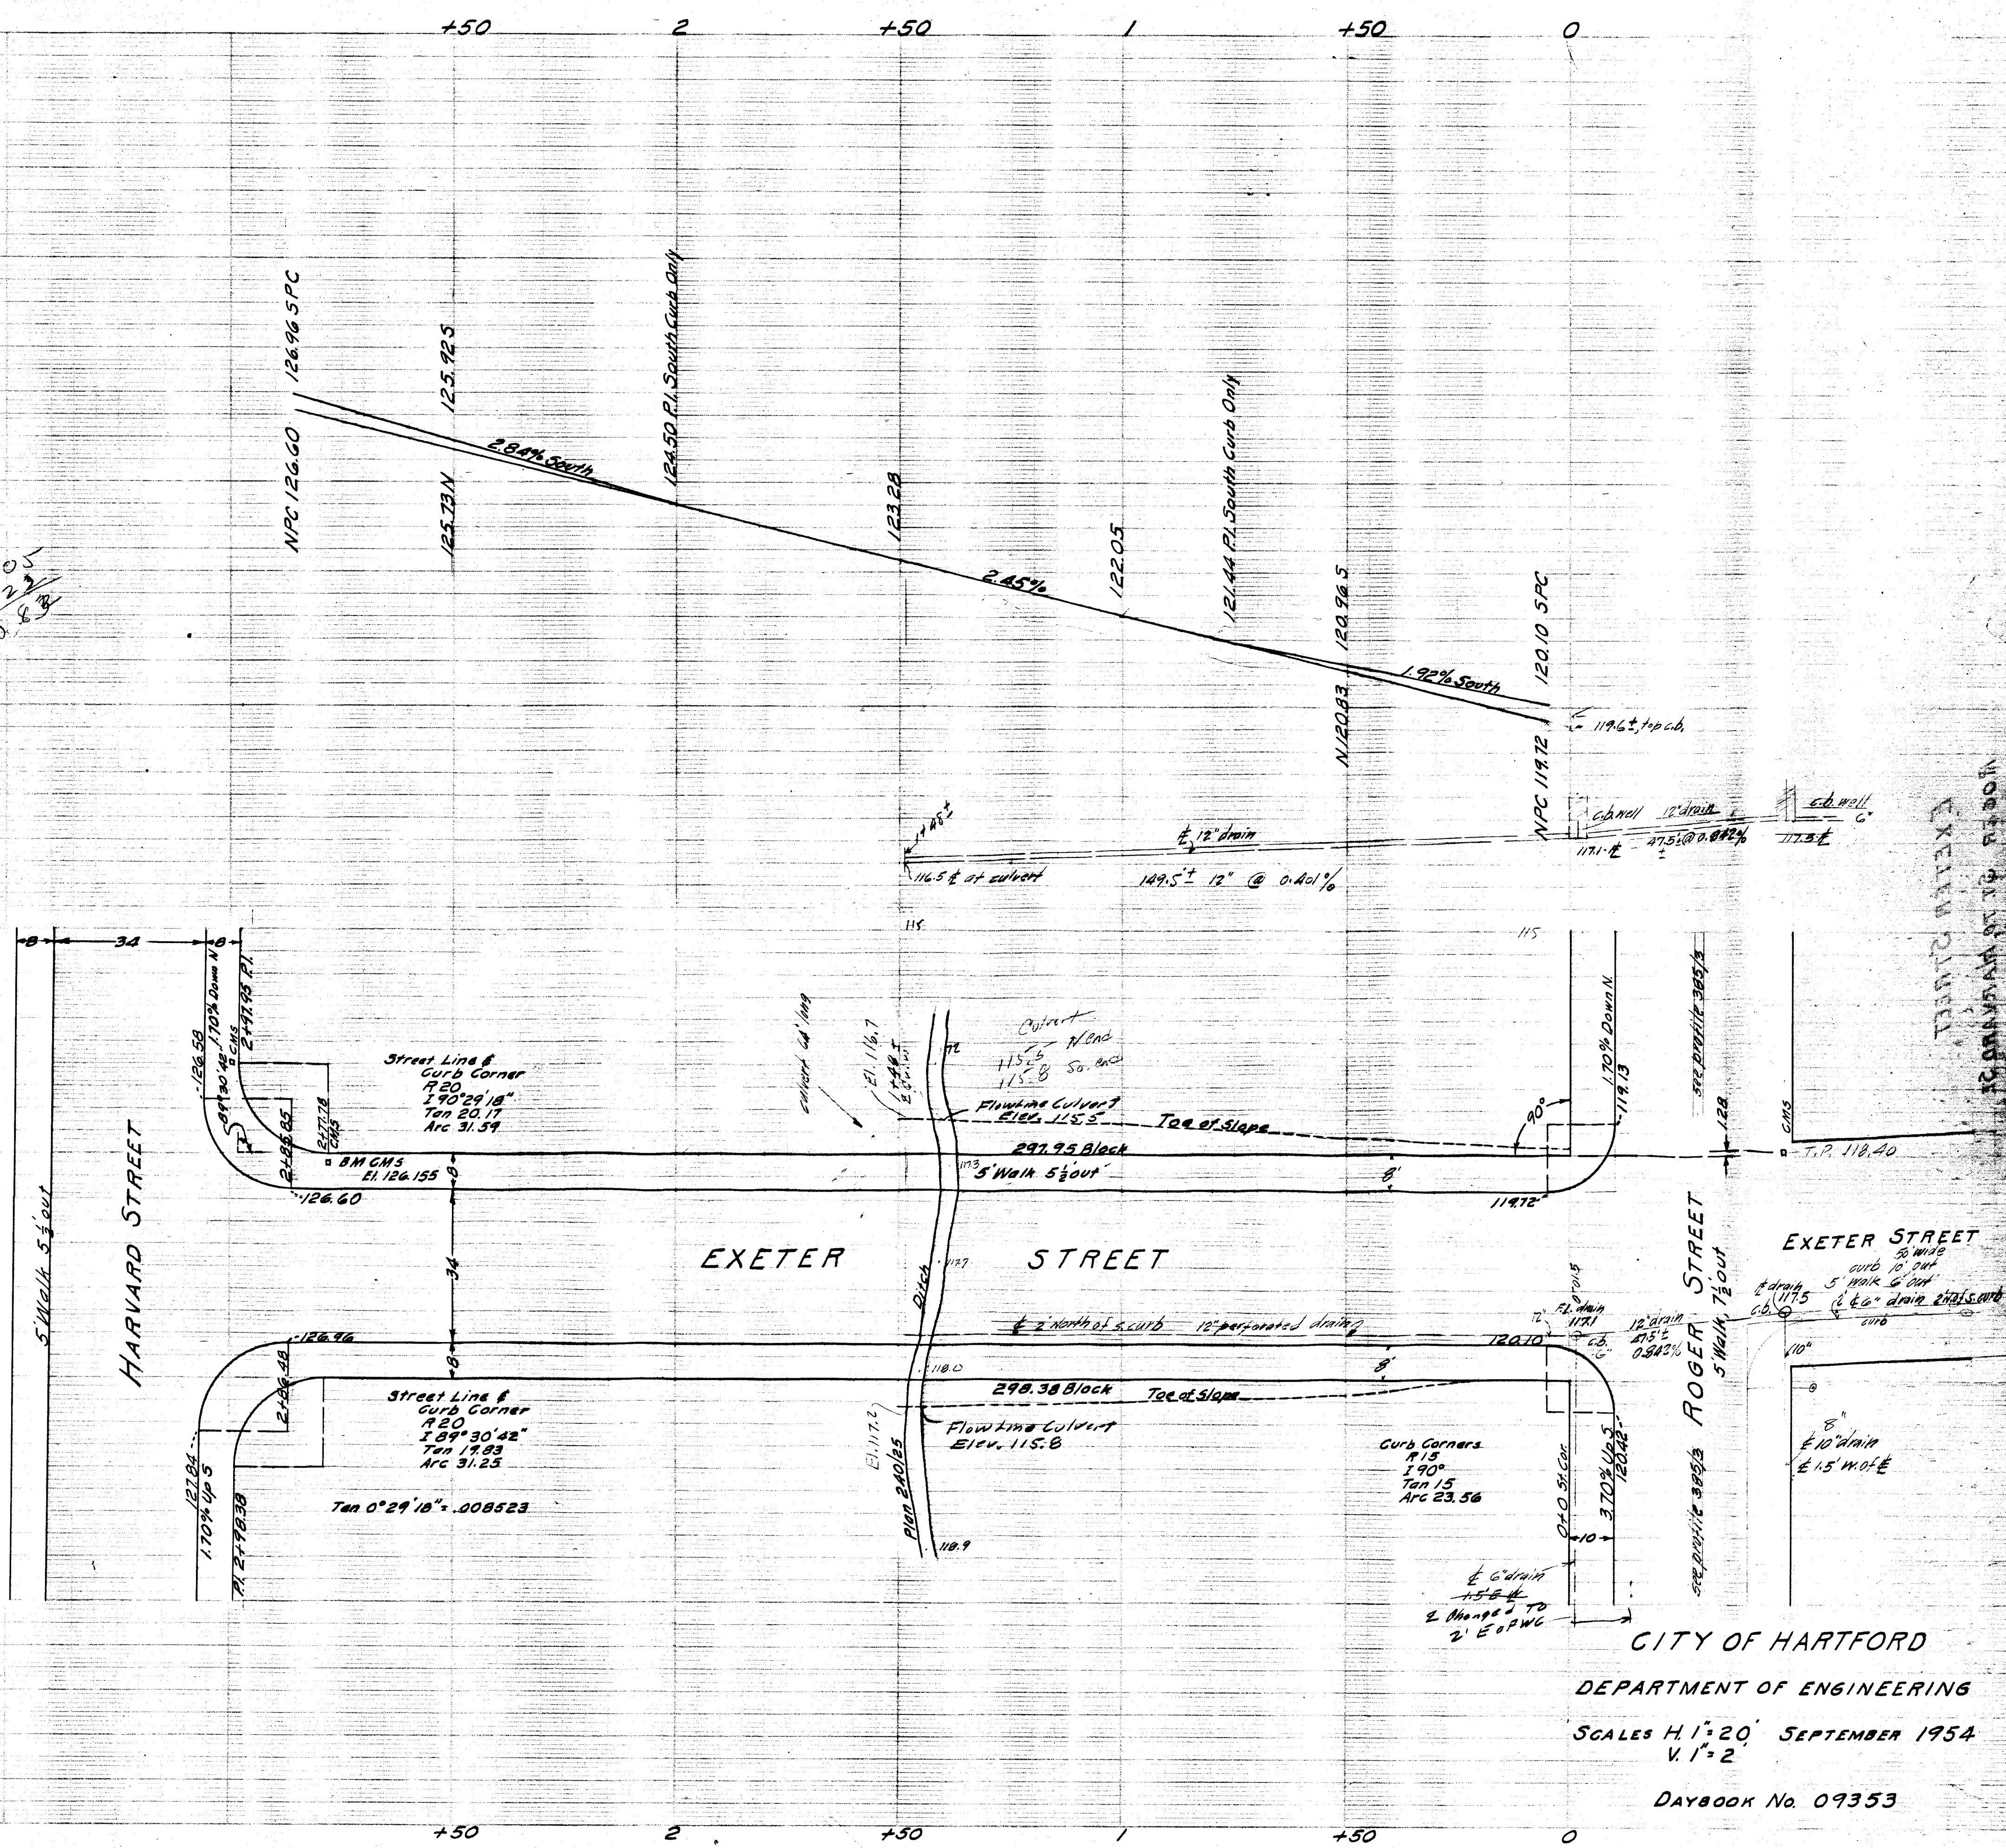

CITY OF HARTFORD

DEPARTMENT OF ENGINEERING

SCALE H. 1"=20' SEPTEMBER 1954
V. 1"=2'

DAYBOOK No. 09353

9/2

9/2