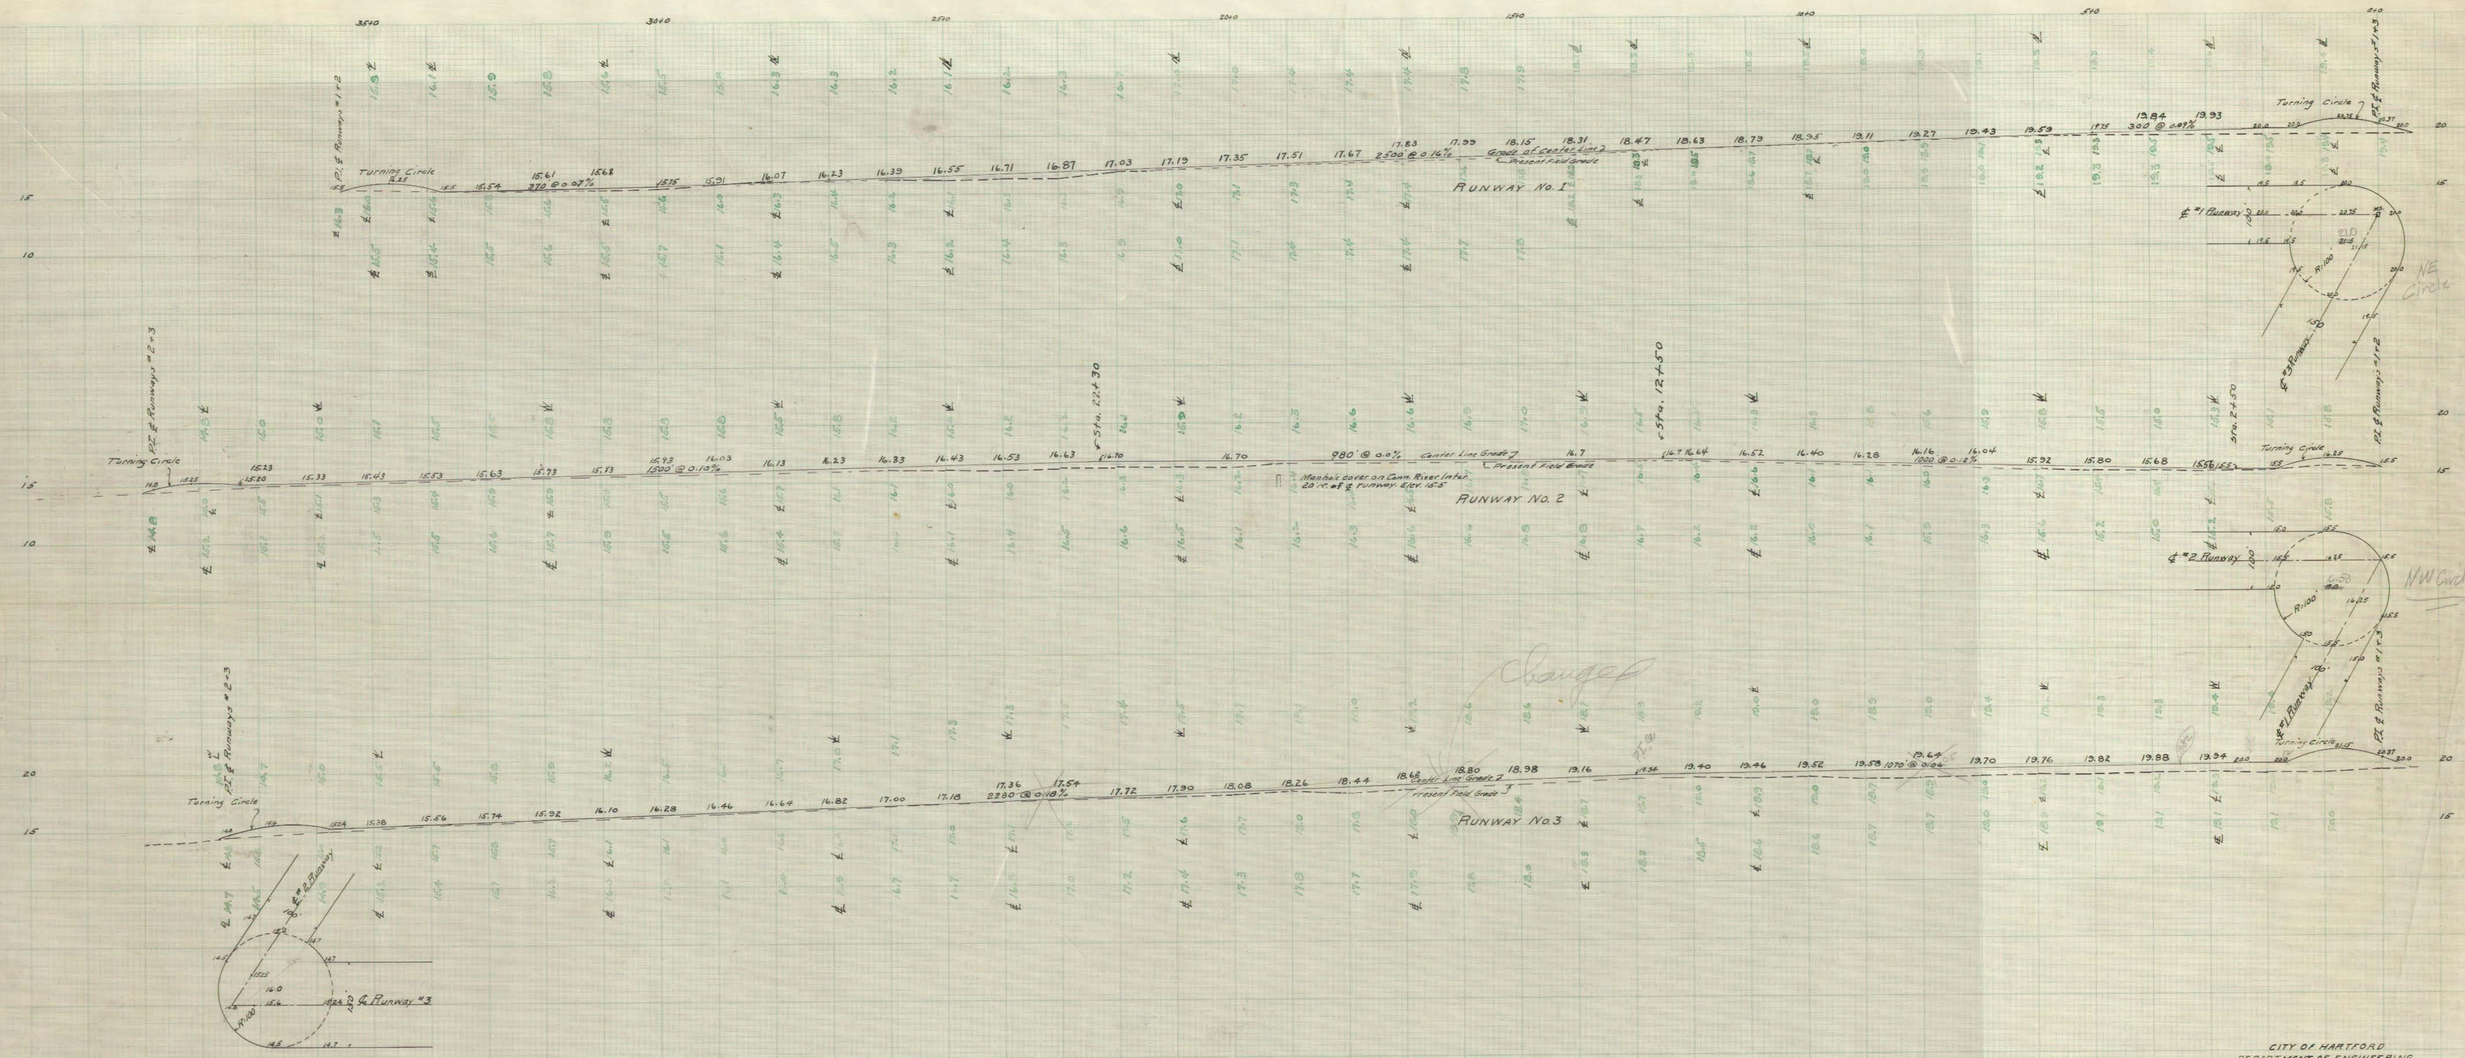

Note. Grade of center line to be 4" above edge of runways.
Grade of center of Turning Circles to be as shown on plan.
Edges to be adjusted to meet field grades.
Present field grades are shown in green ink on tracing. Proposed grades are shown in black ink

CITY OF HARTFORD
DEPARTMENT OF ENGINEERING

PROFILE OF PROPOSED RUNWAYS AT BRAINARD FIELD

Scale Hor. 1"=100' Vert. 1"=5'

Aug. 1936

Daybook No. 07518

Revised Jan. 1937
" Mar. 1937

Changed

Print 4/1/37