GARDEN STREET
ALBANY AVENUE TO GREENFIELD STREET
PAVING PROFILE
HOR. SCALE 1"=50'
VER. SCALE 1"=5'
Sta. Elevs. measured on center line and on curbs.

Department of Engineering
Hartford, Conn.
April - 1935.

City Book No. 2355T
note Book 447.

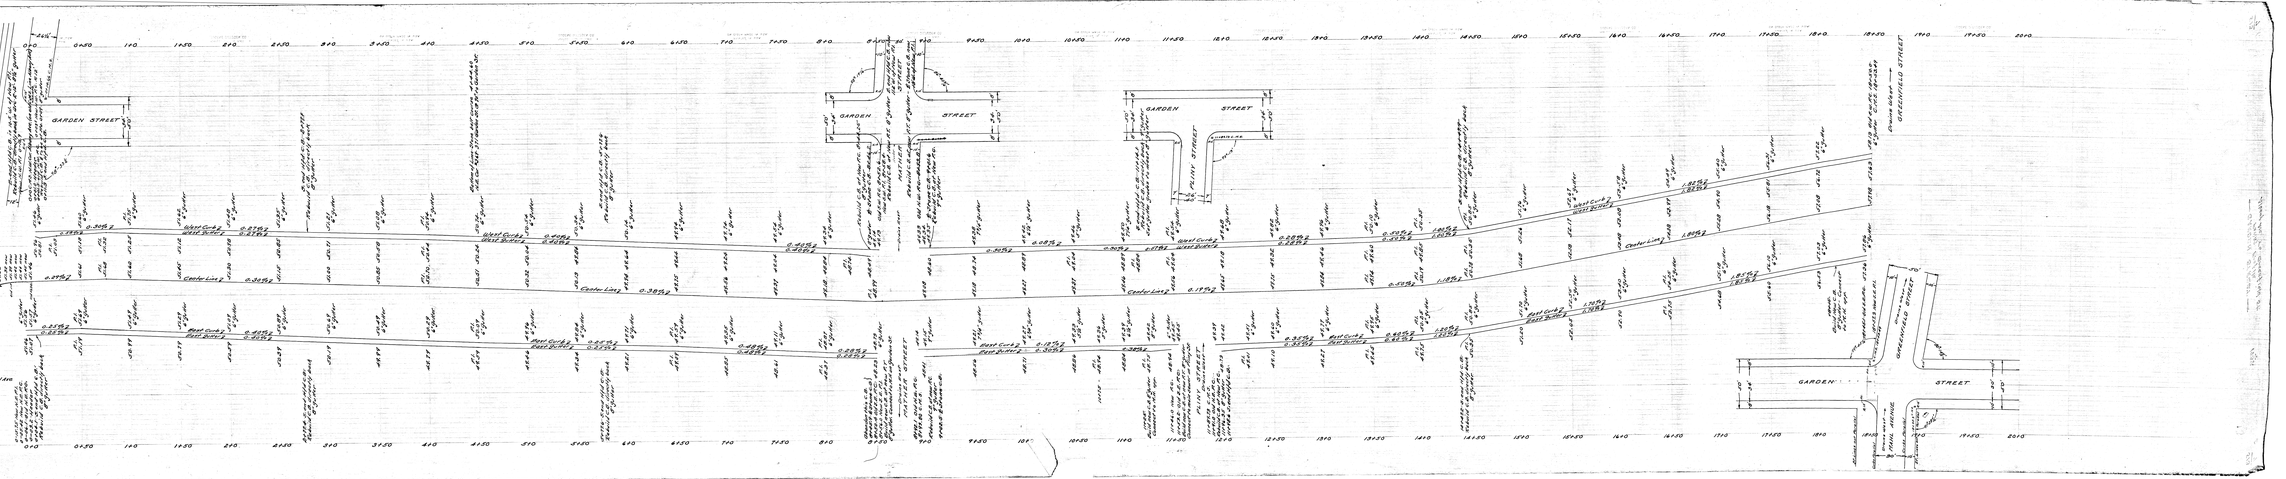
ALBANY AVENUE
GARDEN STREET
PLINY STREET
GREENFIELD STREET
Curb Line
Gutter Line
Center Line
Gutter Line
Curb Line