
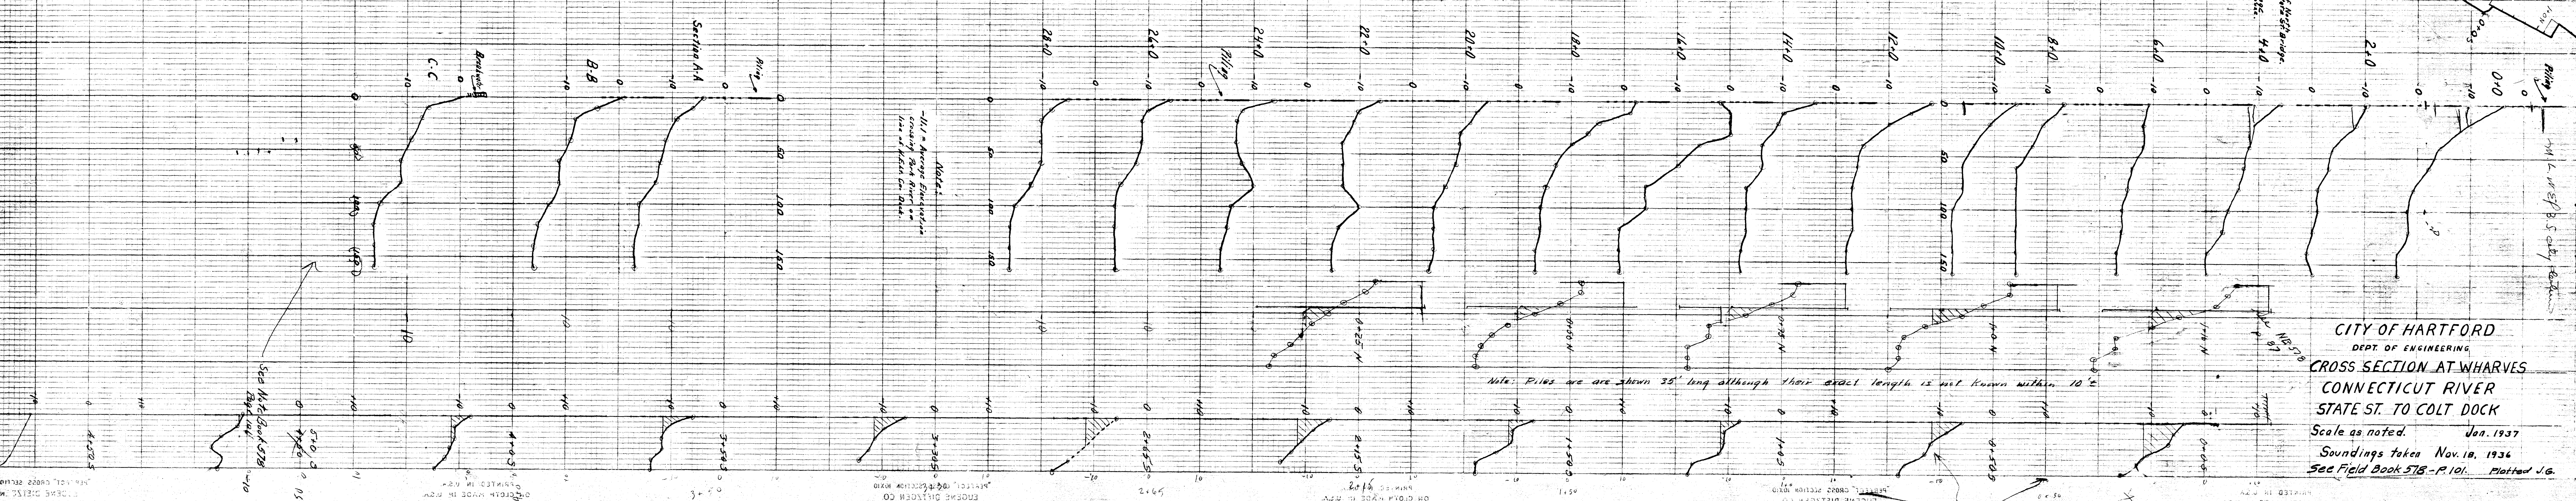


2/2

2/2

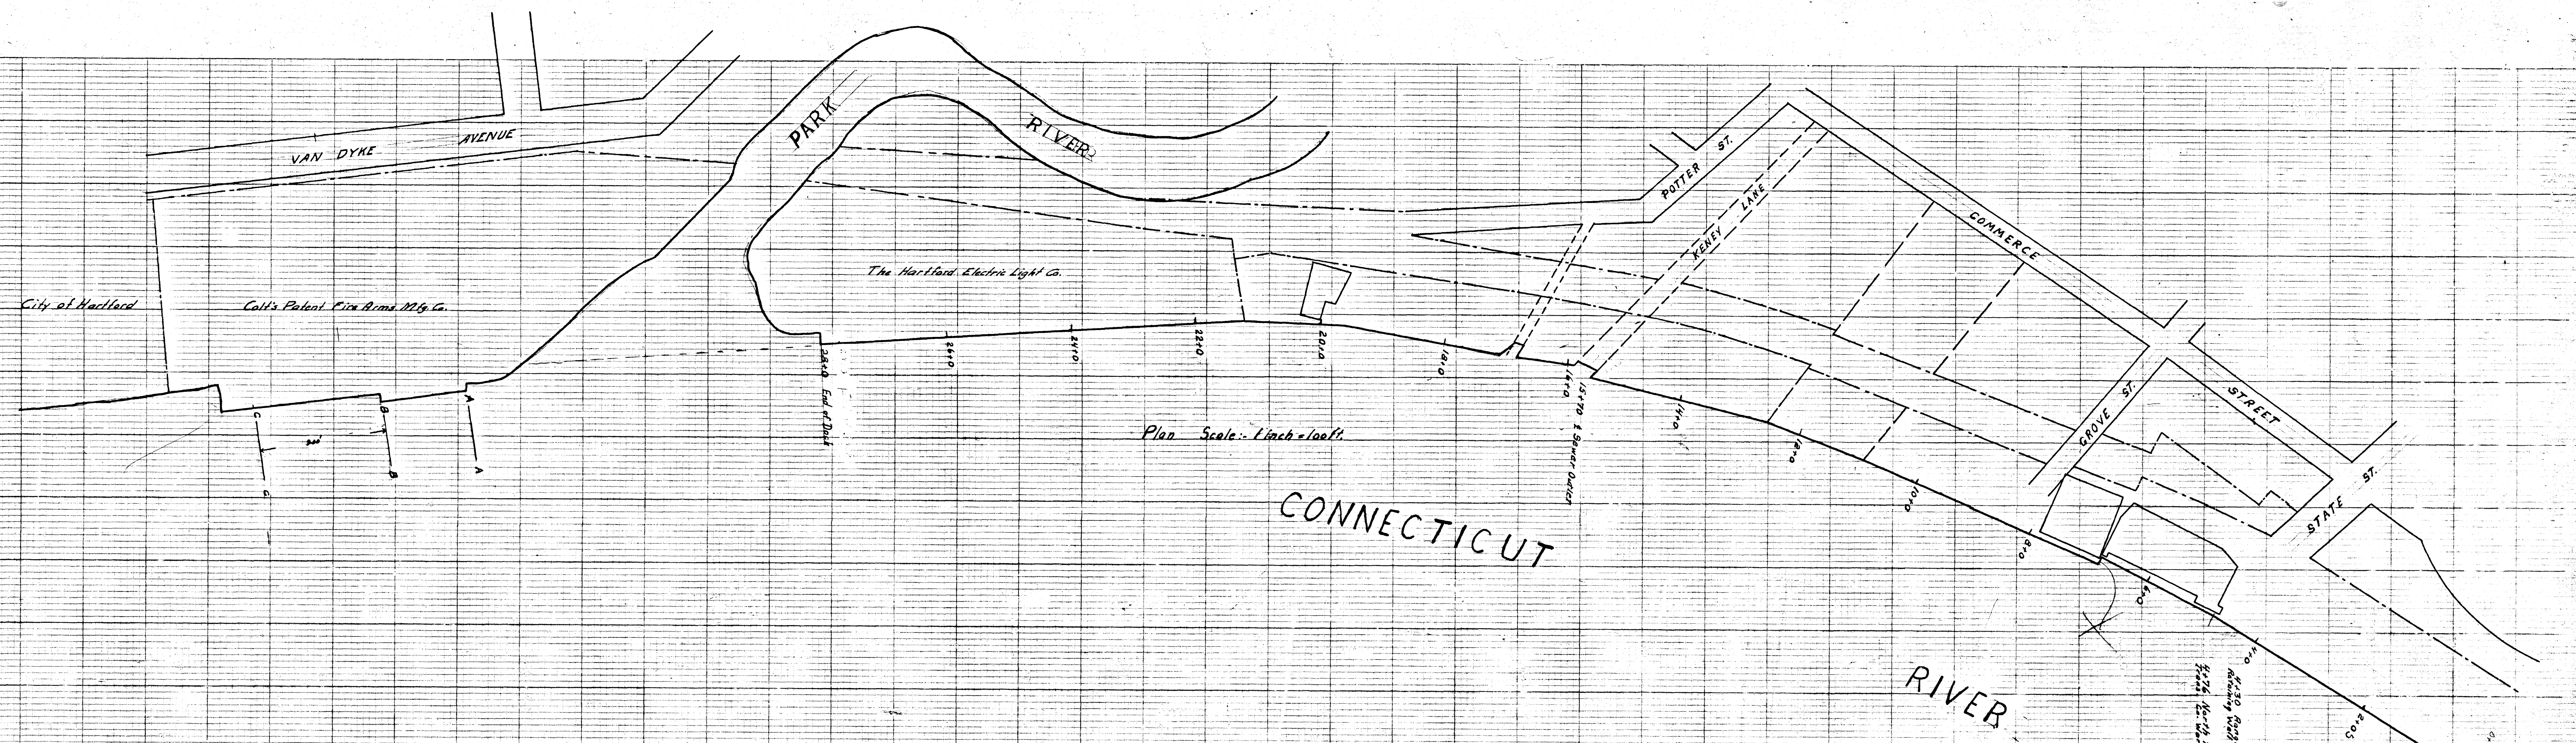

CITY OF HARTFORD
DEPT. OF ENGINEERING
CROSS SECTION AT WHARVES
CONNECTICUT RIVER
STATE ST. TO COLT DOCK
Scale as noted. Jan. 1937
Soundings taken Nov. 18, 1936
See Field Book 578-P. 101. Plotted J.G.

Line section at wharves
Comm. River to Colt Dock
Soundings taken

NB 578
Soundings
4-5-36

1/2 Scale 1" = 10'

1/2 Scale 1" = 10'

2/2