


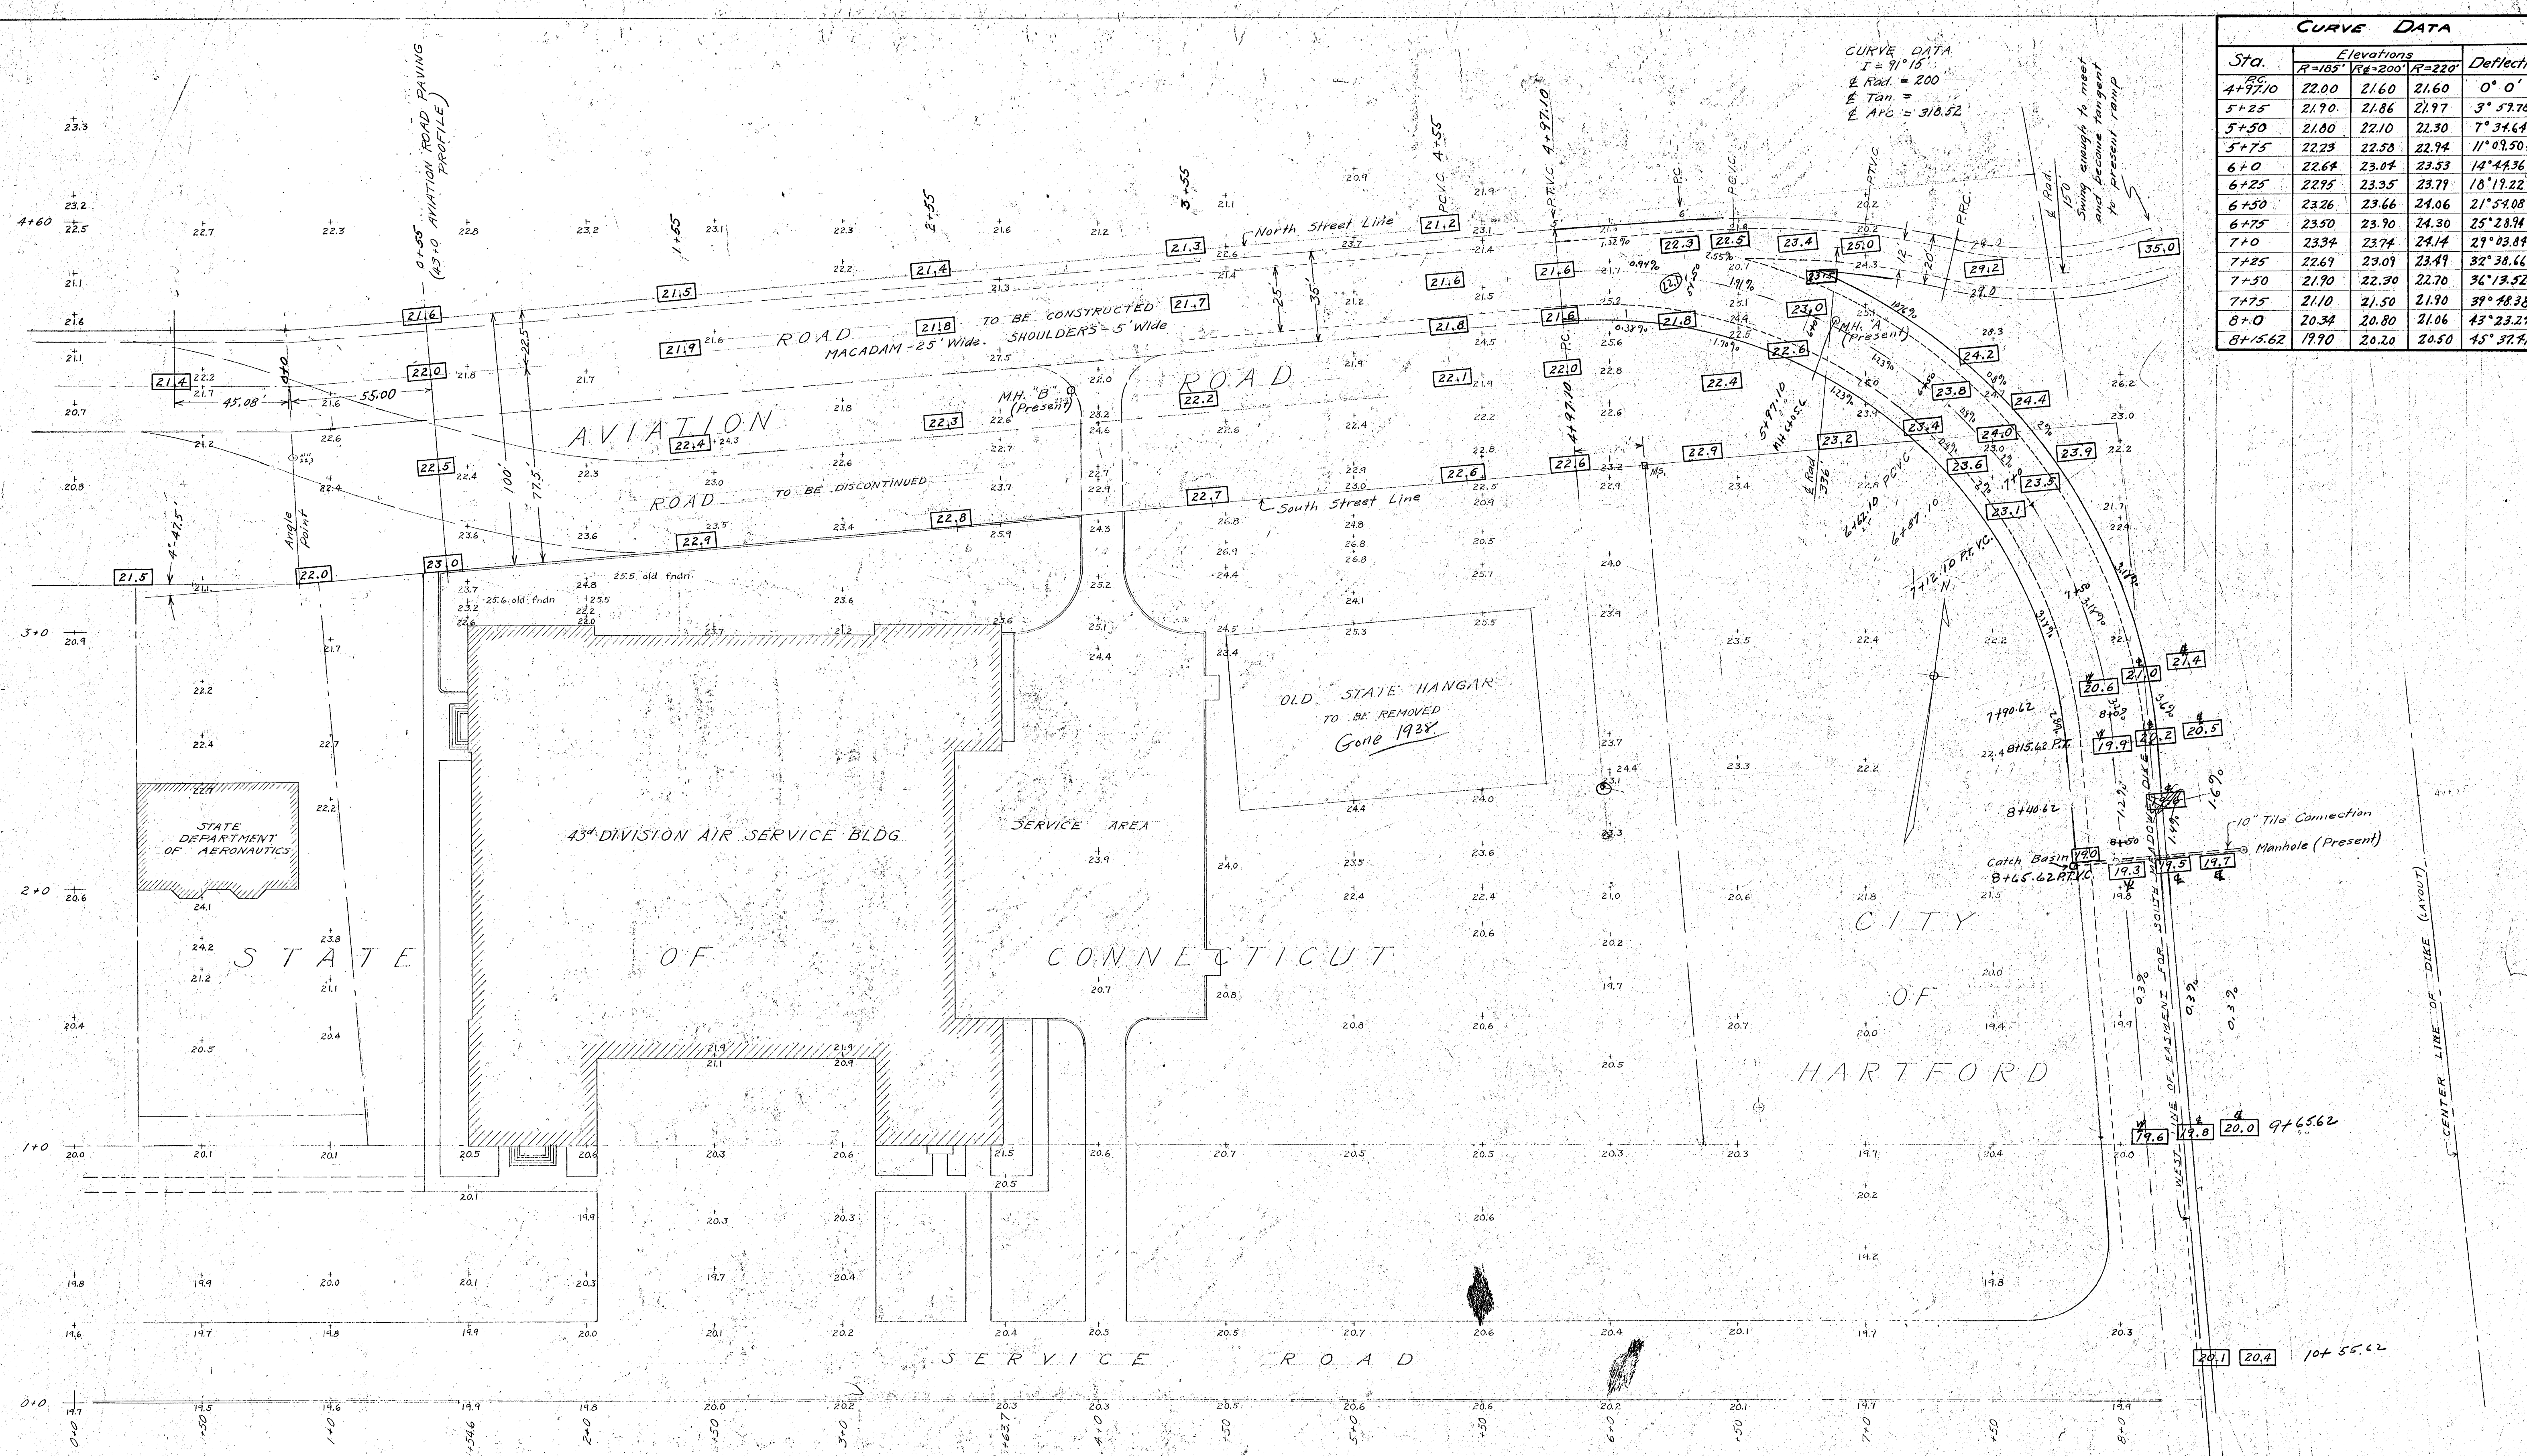

GRADING PLAN
 FOR NATIONAL GUARD AND PART OF CITY OF HARTFORD PROPERTIES
 AT BRAINARD FIELD, HARTFORD, CONNECTICUT
 SCALE: 1" = 30'
 AUGUST 1937

Plan traced from Print #1A, dated Aug. 11, 1936, 43rd DIVISION AIR SERVICE BUILDING, HARTFORD, CONN., PAYNE & KEEFE, ARCHITECTS
 Levels taken by CITY ENGINEERS OFFICE, Aug. 12, 1937
 See M.E. 466 p. 134-139
 Elevs. refer to Hartford City Datum
 Roadway and grades revised Oct. 20, 1937
 " " " Sept. 19, 1938

Daybook No. 076478
 Traced by A.W.S. Checked W.W.P.
 Print of Sept. 19, 1938